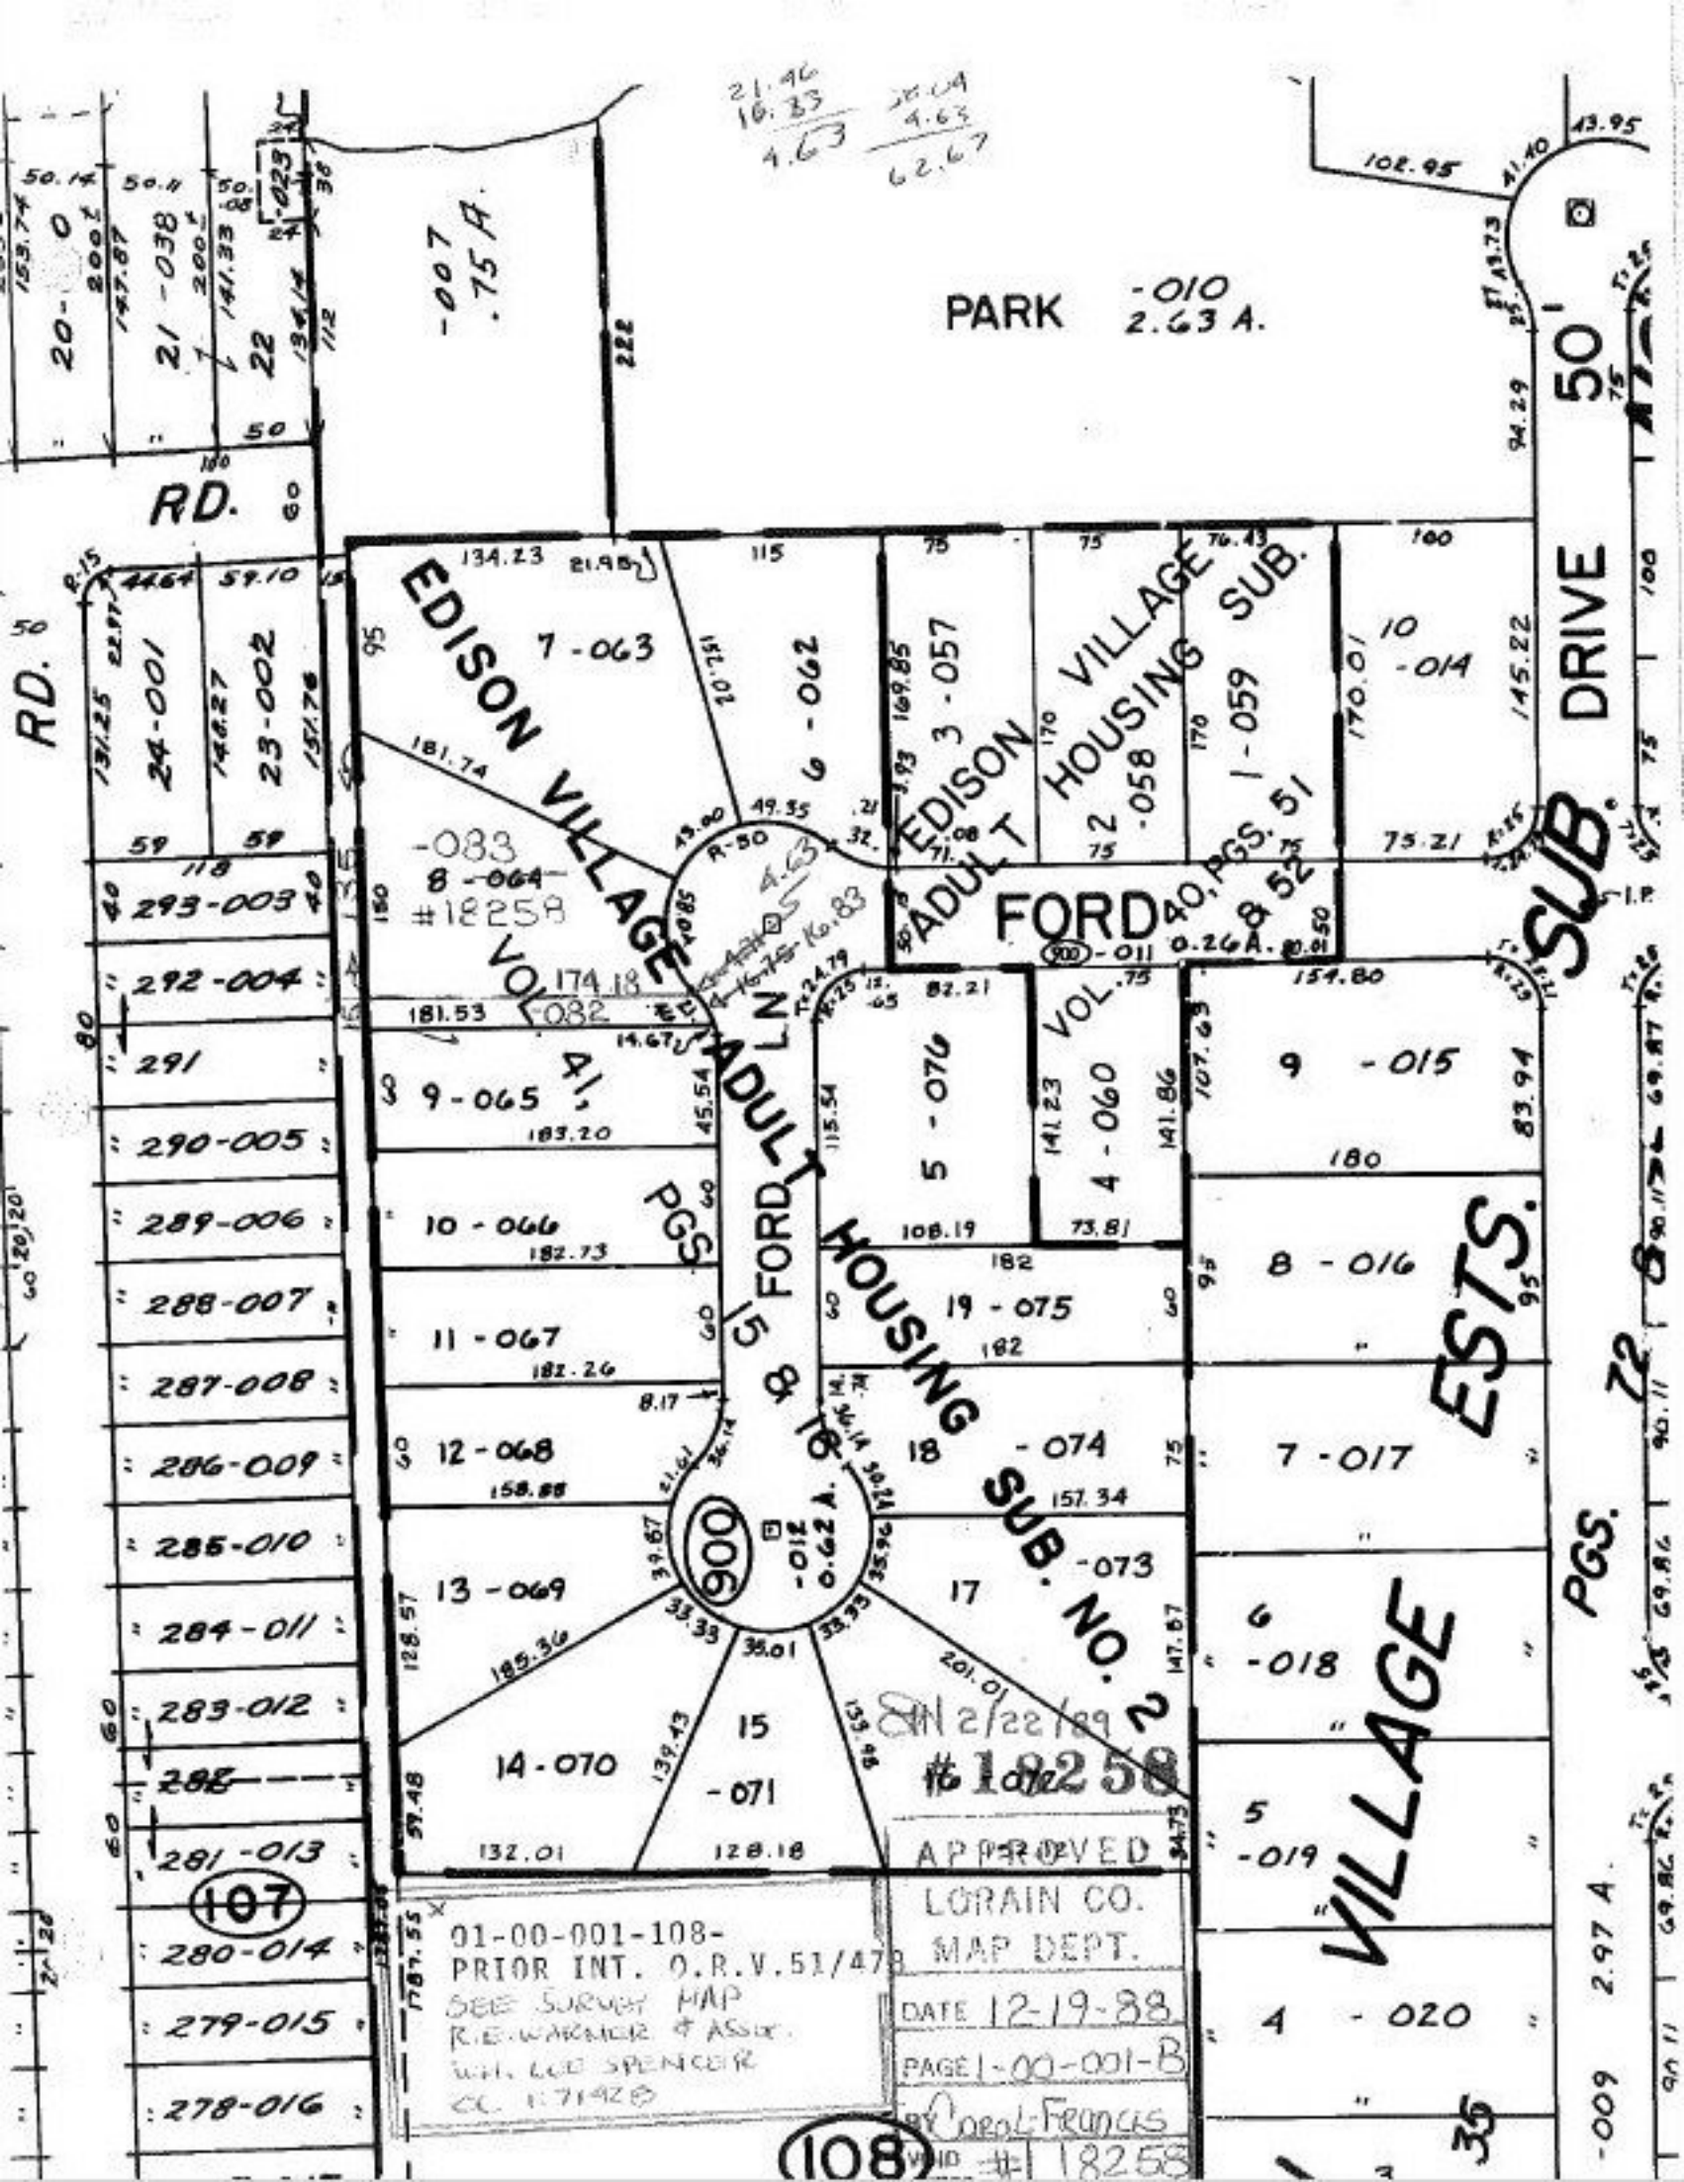
PARK -010 2.63 A.
-007 .75 A.
EDISON VILLAGE ADULT HOUSING SUB.
EDISON VILLAGE ADULT HOUSING SUB. NO. 2
FORD DRIVE
VILLAGE ESTS.
RD.
7-063
6-062
3-057
2-058
1-059
10-014
-083
8-064
#18258
VOL. 040, PGS. 51 & 52
-011 0.26 A.
-012 0.62 A.
9-065
10-066
11-067
12-068
13-069
14-070
15-071
5-076
4-060
19-075
18-074
17-073
9-015
8-016
7-017
6-018
5-019
4-020
293-003
292-004
291
290-005
289-006
288-007
287-008
286-009
285-010
284-011
283-012
282
281-013
280-014
279-015
278-016
20-0
21-038
22
24-001
23-002
107
108
900
01-00-001-108-
PRIOR INT. O.R.V. 51/478
SEE SURVEY MAP
R.E. WARNER & ASSOC.
W.H. LEE SPENCER
CC. 1-71-42
APPROVED
LORAIN CO.
MAP DEPT.
DATE 12-19-88
PAGE 1-00-001-B
BY Carol Frances
VOID #18258
2/22/89
#18258