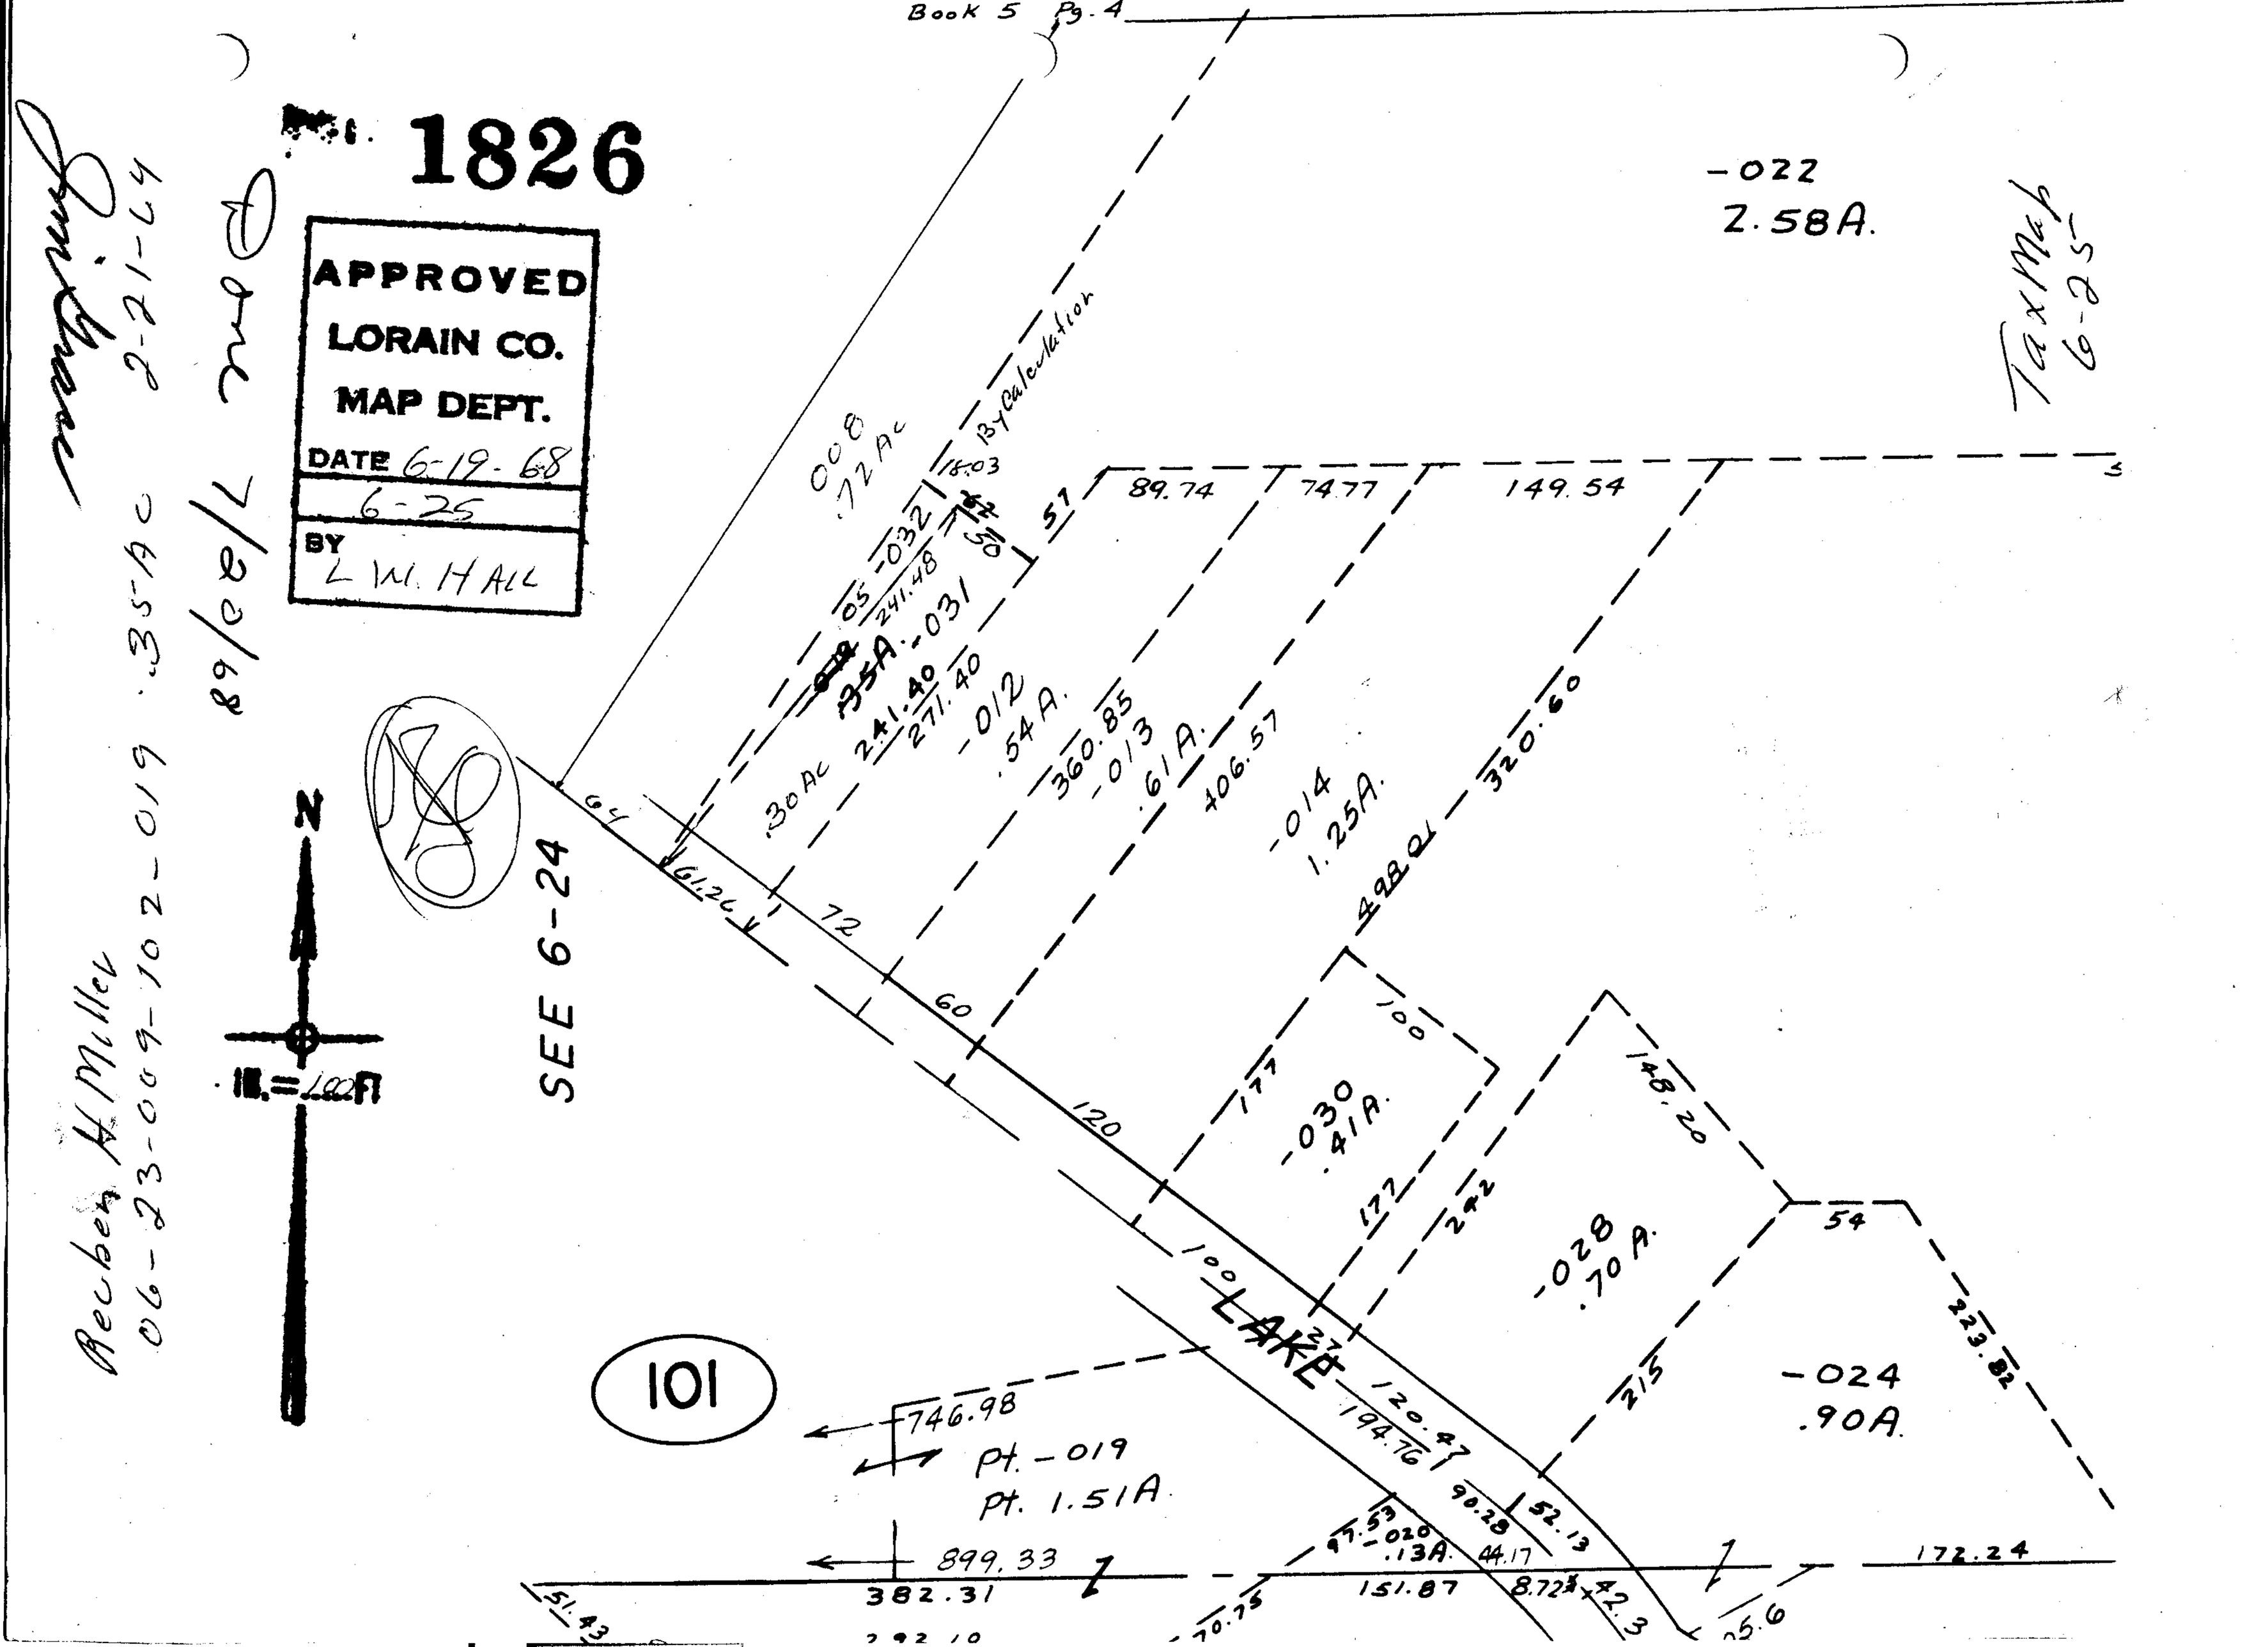

Book 5 Pg. 4
1826
APPROVED
LORAIN CO.
MAP DEPT.
DATE 6-19-68
6-25
BY L. W. HALL
-022
2.58A.
Tax Map 6-25
By Calculation
008
.72 Ac
18.03
57
89.74
74.77
149.54
05 -032
241.48
-031
.35A.
241.40
271.40
-012
.54A.
360.85
-013
.61A.
406.57
-014
1.25A.
320.60
.30 Ac
64
61.26
72
60
120
100
177
-030
.41A.
177
242
148.20
-028
.70A.
54
223.82
215
-024
.90A.
LAKE
27
120.47
194.76
90.28
52.13
97.53
-020
.13A.
44.17
151.87
8.72
42.3
172.24
746.98
Pt. -019
Pt. 1.51A.
899.33
382.31
51.43
SEE 6-24
N
1 IN. = 100 FT
101
Reuben H. Miller
06-23-009-102-019 .35 Ac
2-21-69
