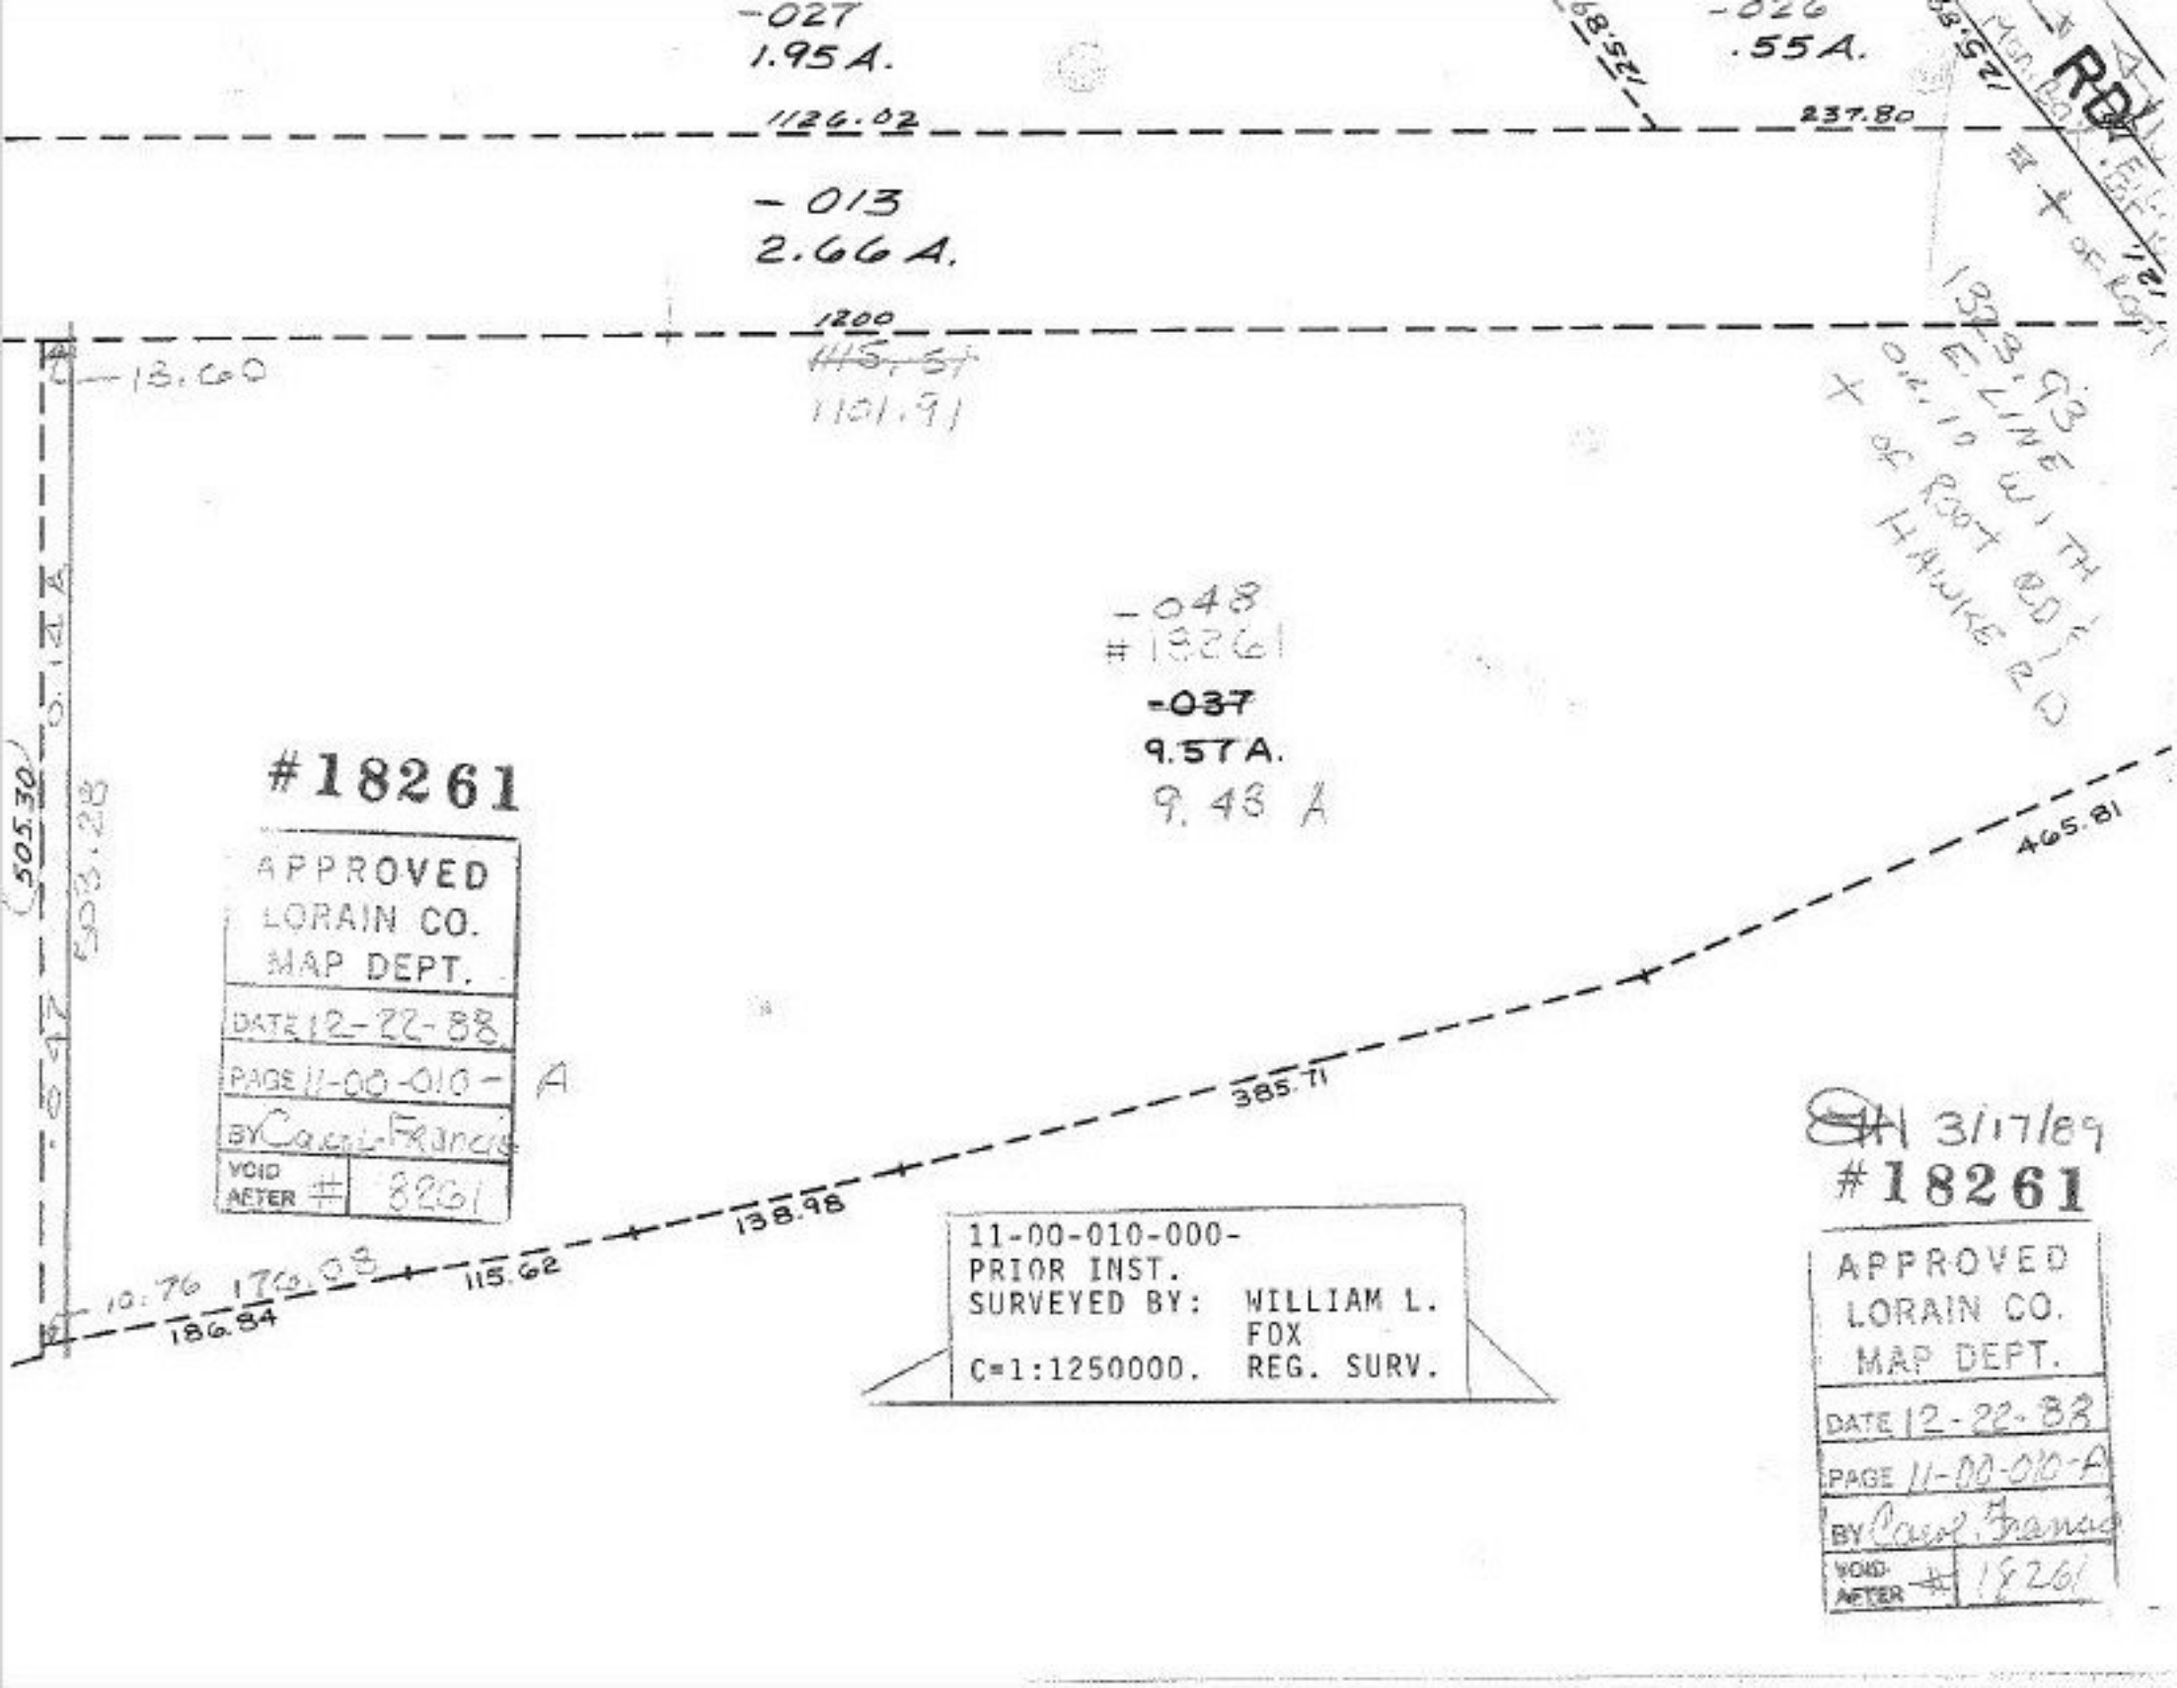
-027
1.95 A.
-026
.55 A.
1126.02
237.80
-013
2.66 A.
1200
1101.91
13.60
-048
#18261
-037
9.57 A.
9.48 A
505.30
503.28
465.81
385.71
138.98
115.62
186.84
176.08
10.76
11-00-010-000-
PRIOR INST.
SURVEYED BY: WILLIAM L. FOX
C=1:1250000. REG. SURV.
#18261
APPROVED
LORAIN CO.
MAP DEPT.
DATE 12-22-88
PAGE 11-00-010-A
BY Carol Francis
VOID AFTER # 8261
3/17/89
#18261
APPROVED
LORAIN CO.
MAP DEPT.
DATE 12-22-88
PAGE 11-00-010-A
BY Carol Francis
VOID AFTER # 18261