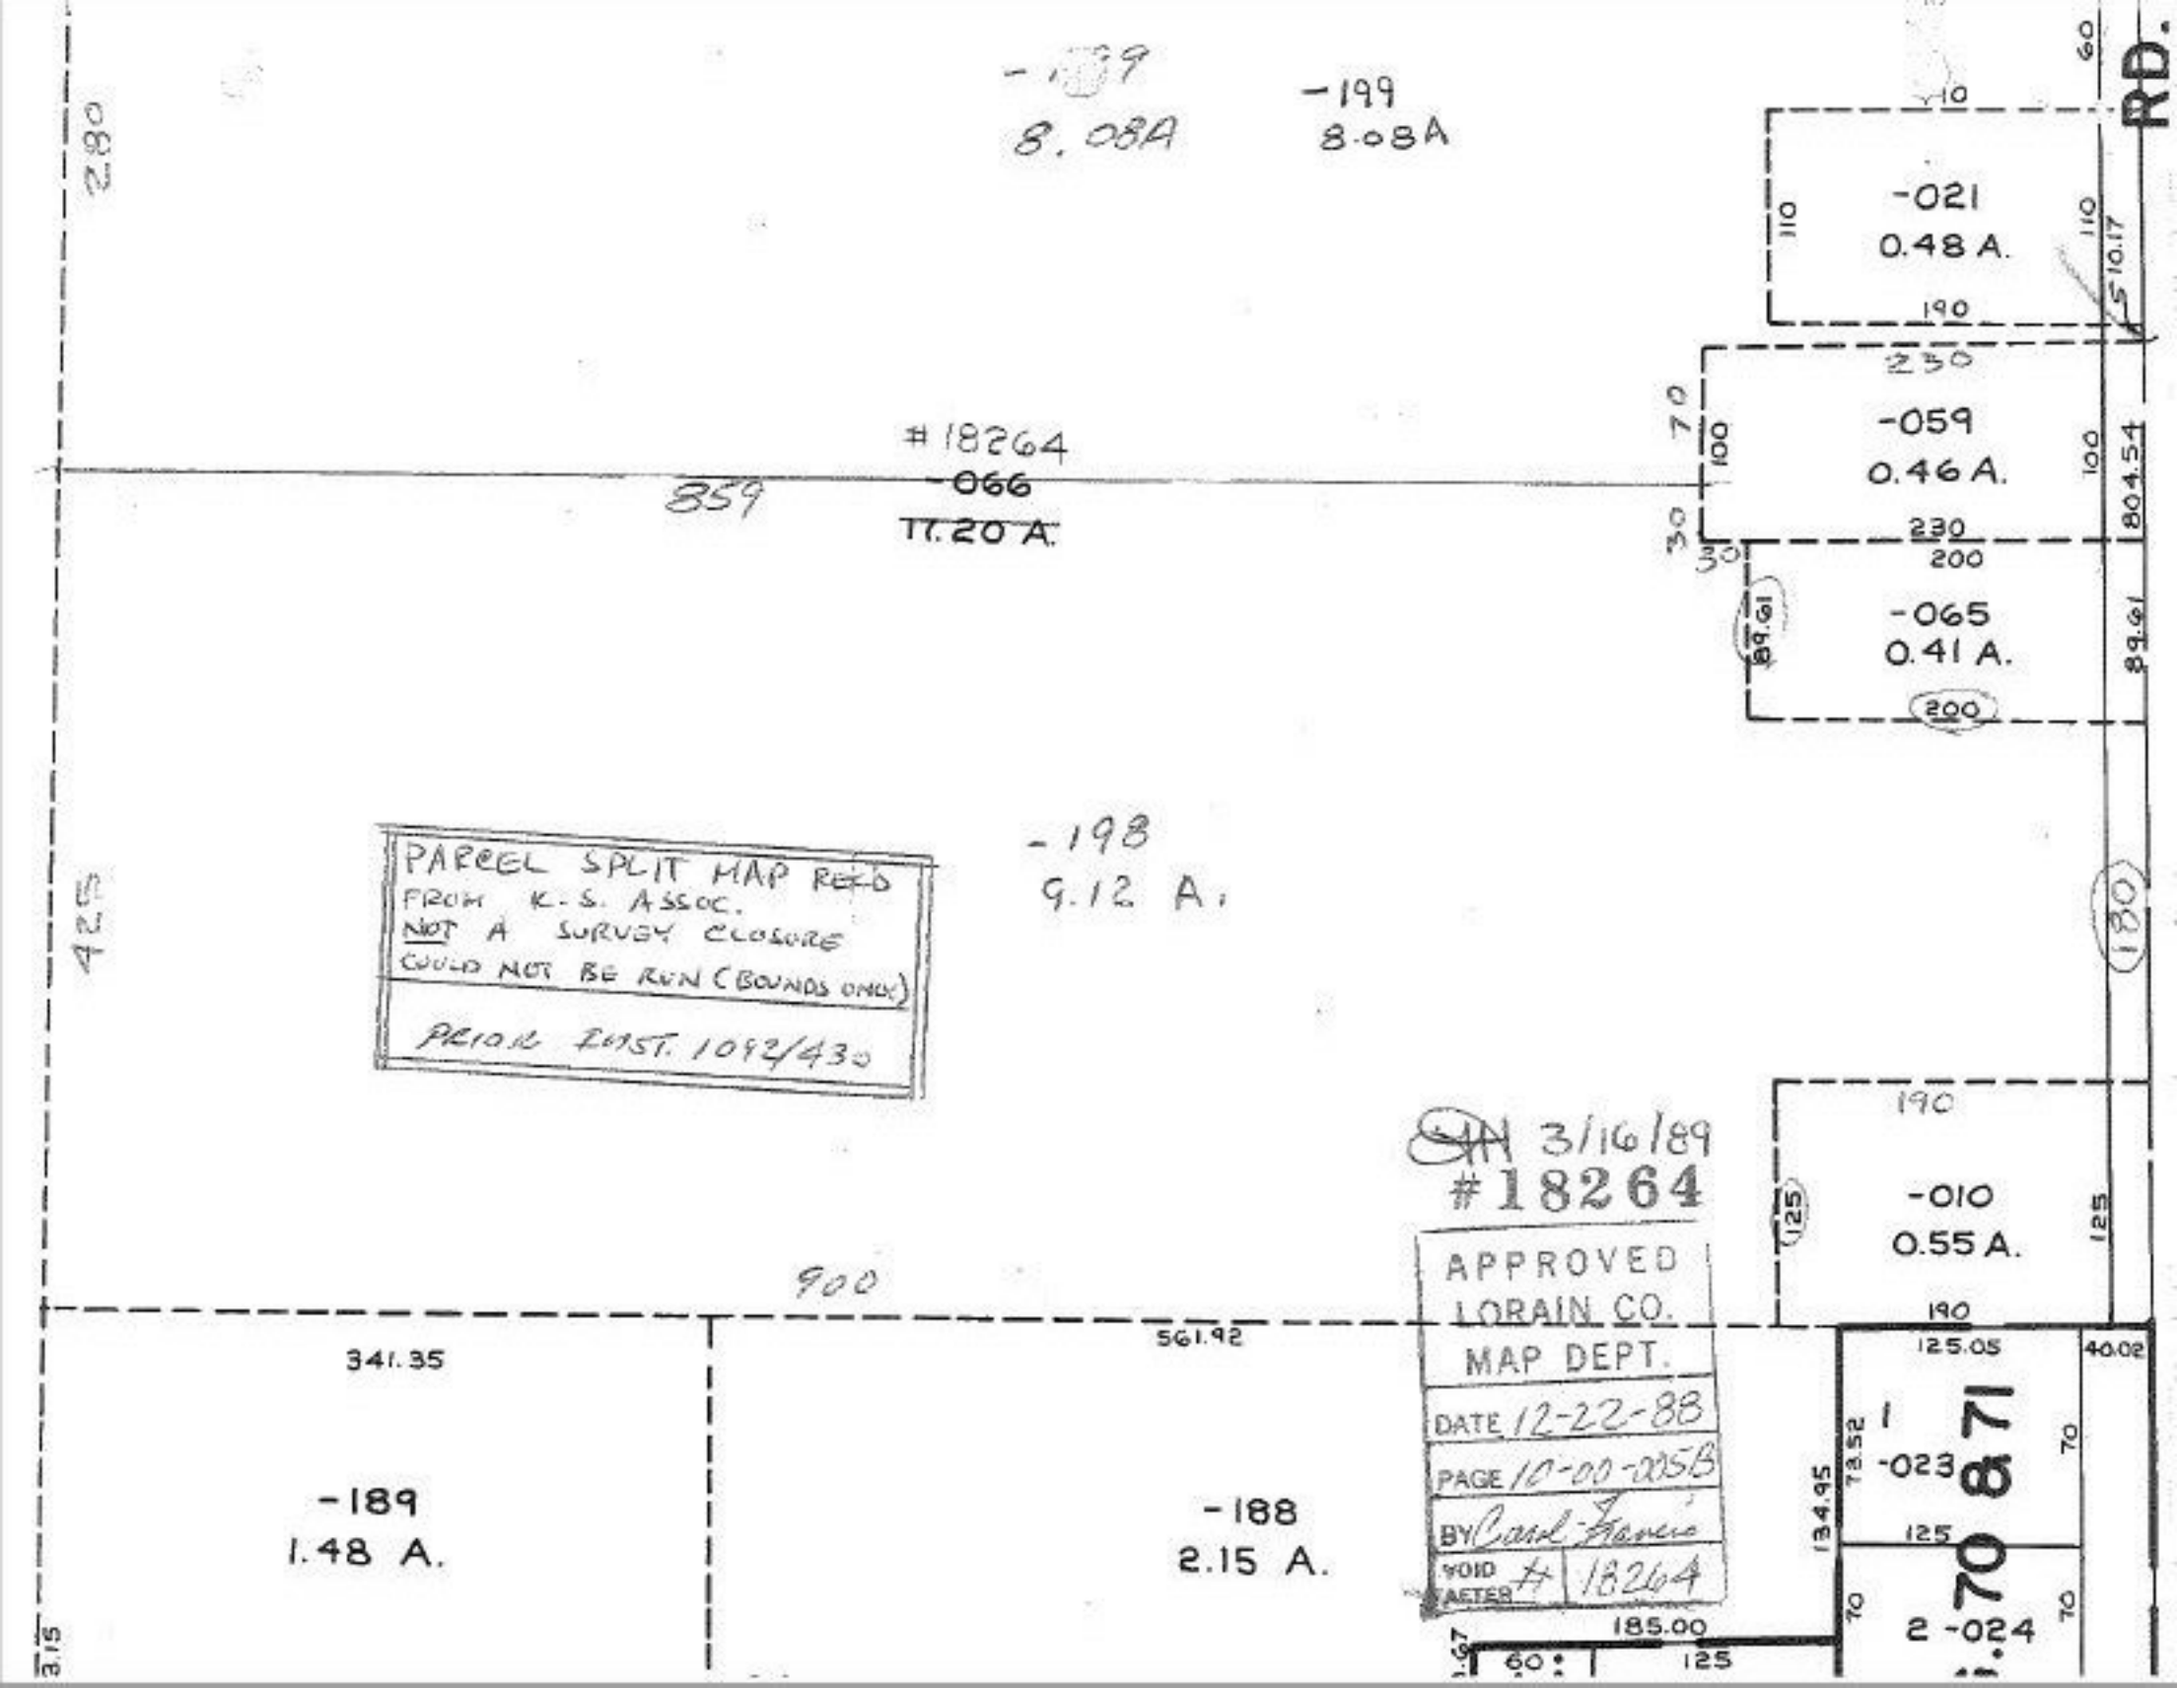
-199
8.08A
-021
0.48 A.
-059
0.46 A.
-065
0.41 A.
-010
0.55 A.
#18264
-066
11.20 A.
-198
9.12 A.
PARCEL SPLIT MAP REF'D FROM K-S ASSOC.
NOT A SURVEY CLOSURE
COULD NOT BE RUN (BOUNDS ONLY)
PRIOR INST. 1092/430
3/16/89
#18264
APPROVED
LORAIN CO.
MAP DEPT.
DATE 12-22-88
PAGE 10-00-025B
BY Carol Francis
VOID AFTER # 18264
-189
1.48 A.
-188
2.15 A.
-023
-024
871
RD.