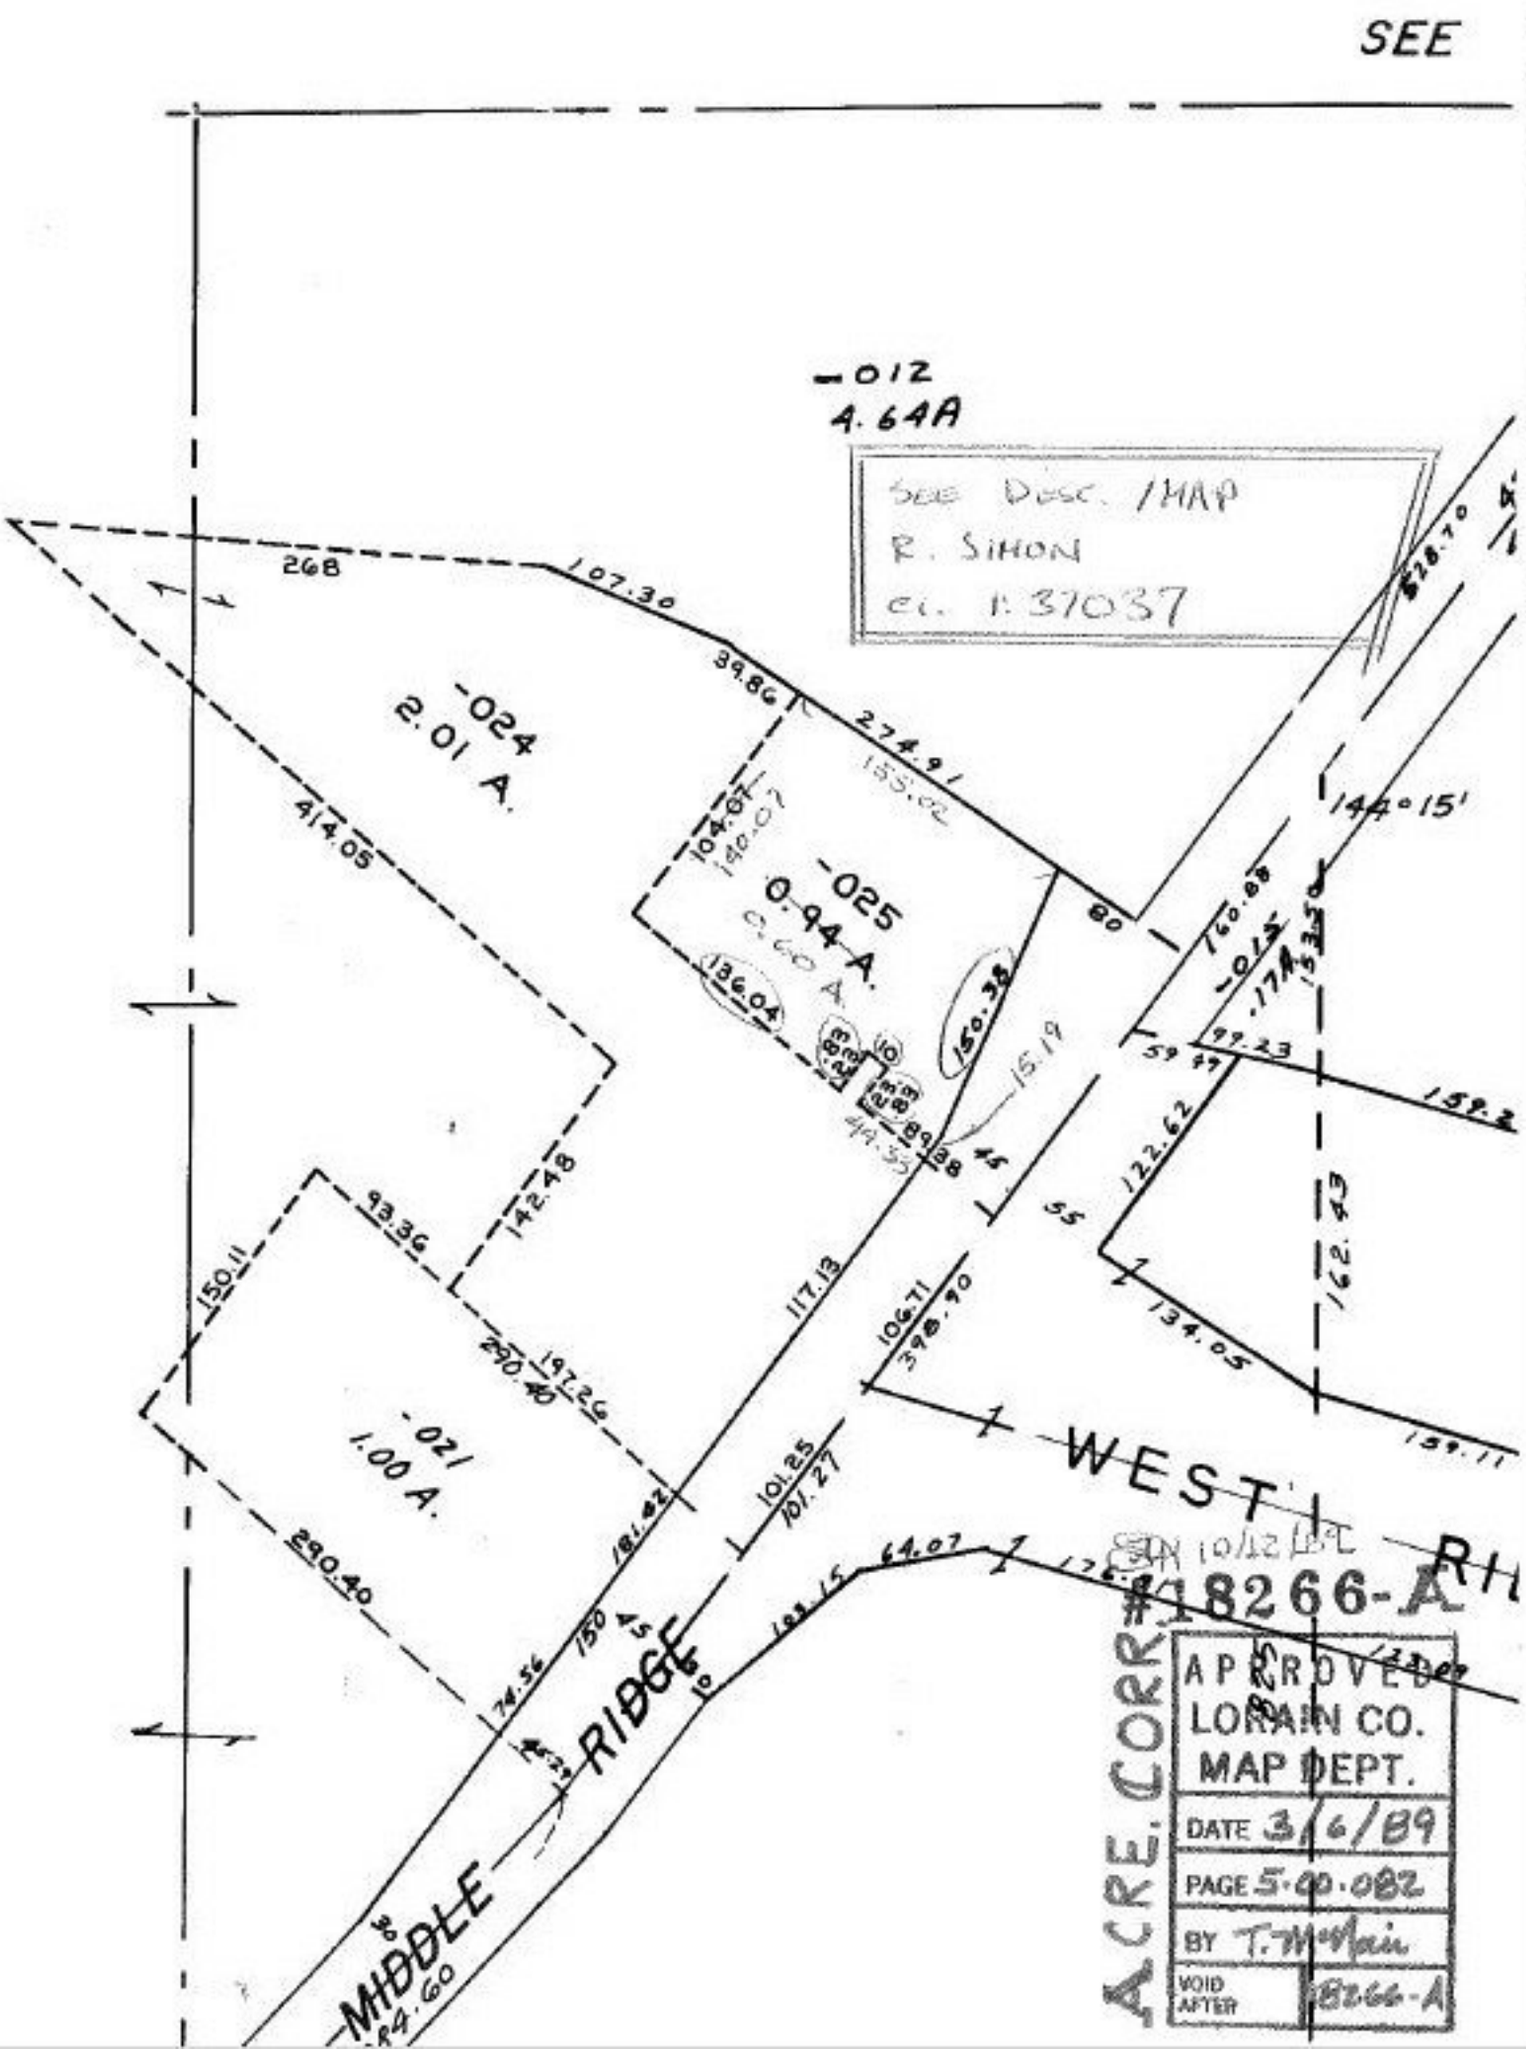
SEE
-012
4.64A
SEE DESC. /MAP
R. SIMON
CL. 1:37037
-024
2.01 A.
-025
0.94 A.
0.60 A.
-021
1.00 A.
-015
.17A
WEST
RI
MIDDLE
RIDGE
268
107.30
39.86
274.91
155.02
414.05
104.07
140.07
136.04
150.38
15.19
80
144°15'
160.88
99.23
159.2
122.62
162.43
134.05
159.11
142.48
93.36
150.11
117.13
106.71
398.90
290.40
197.26
101.25
101.27
181.42
290.40
74.56
150
64.07
103.15
ACRE CORR.
#18266-A
APPROVED
LORAIN CO.
MAP DEPT.
DATE 3/6/89
PAGE 5-00-082
BY T. McMain
VOID AFTER 18266-A