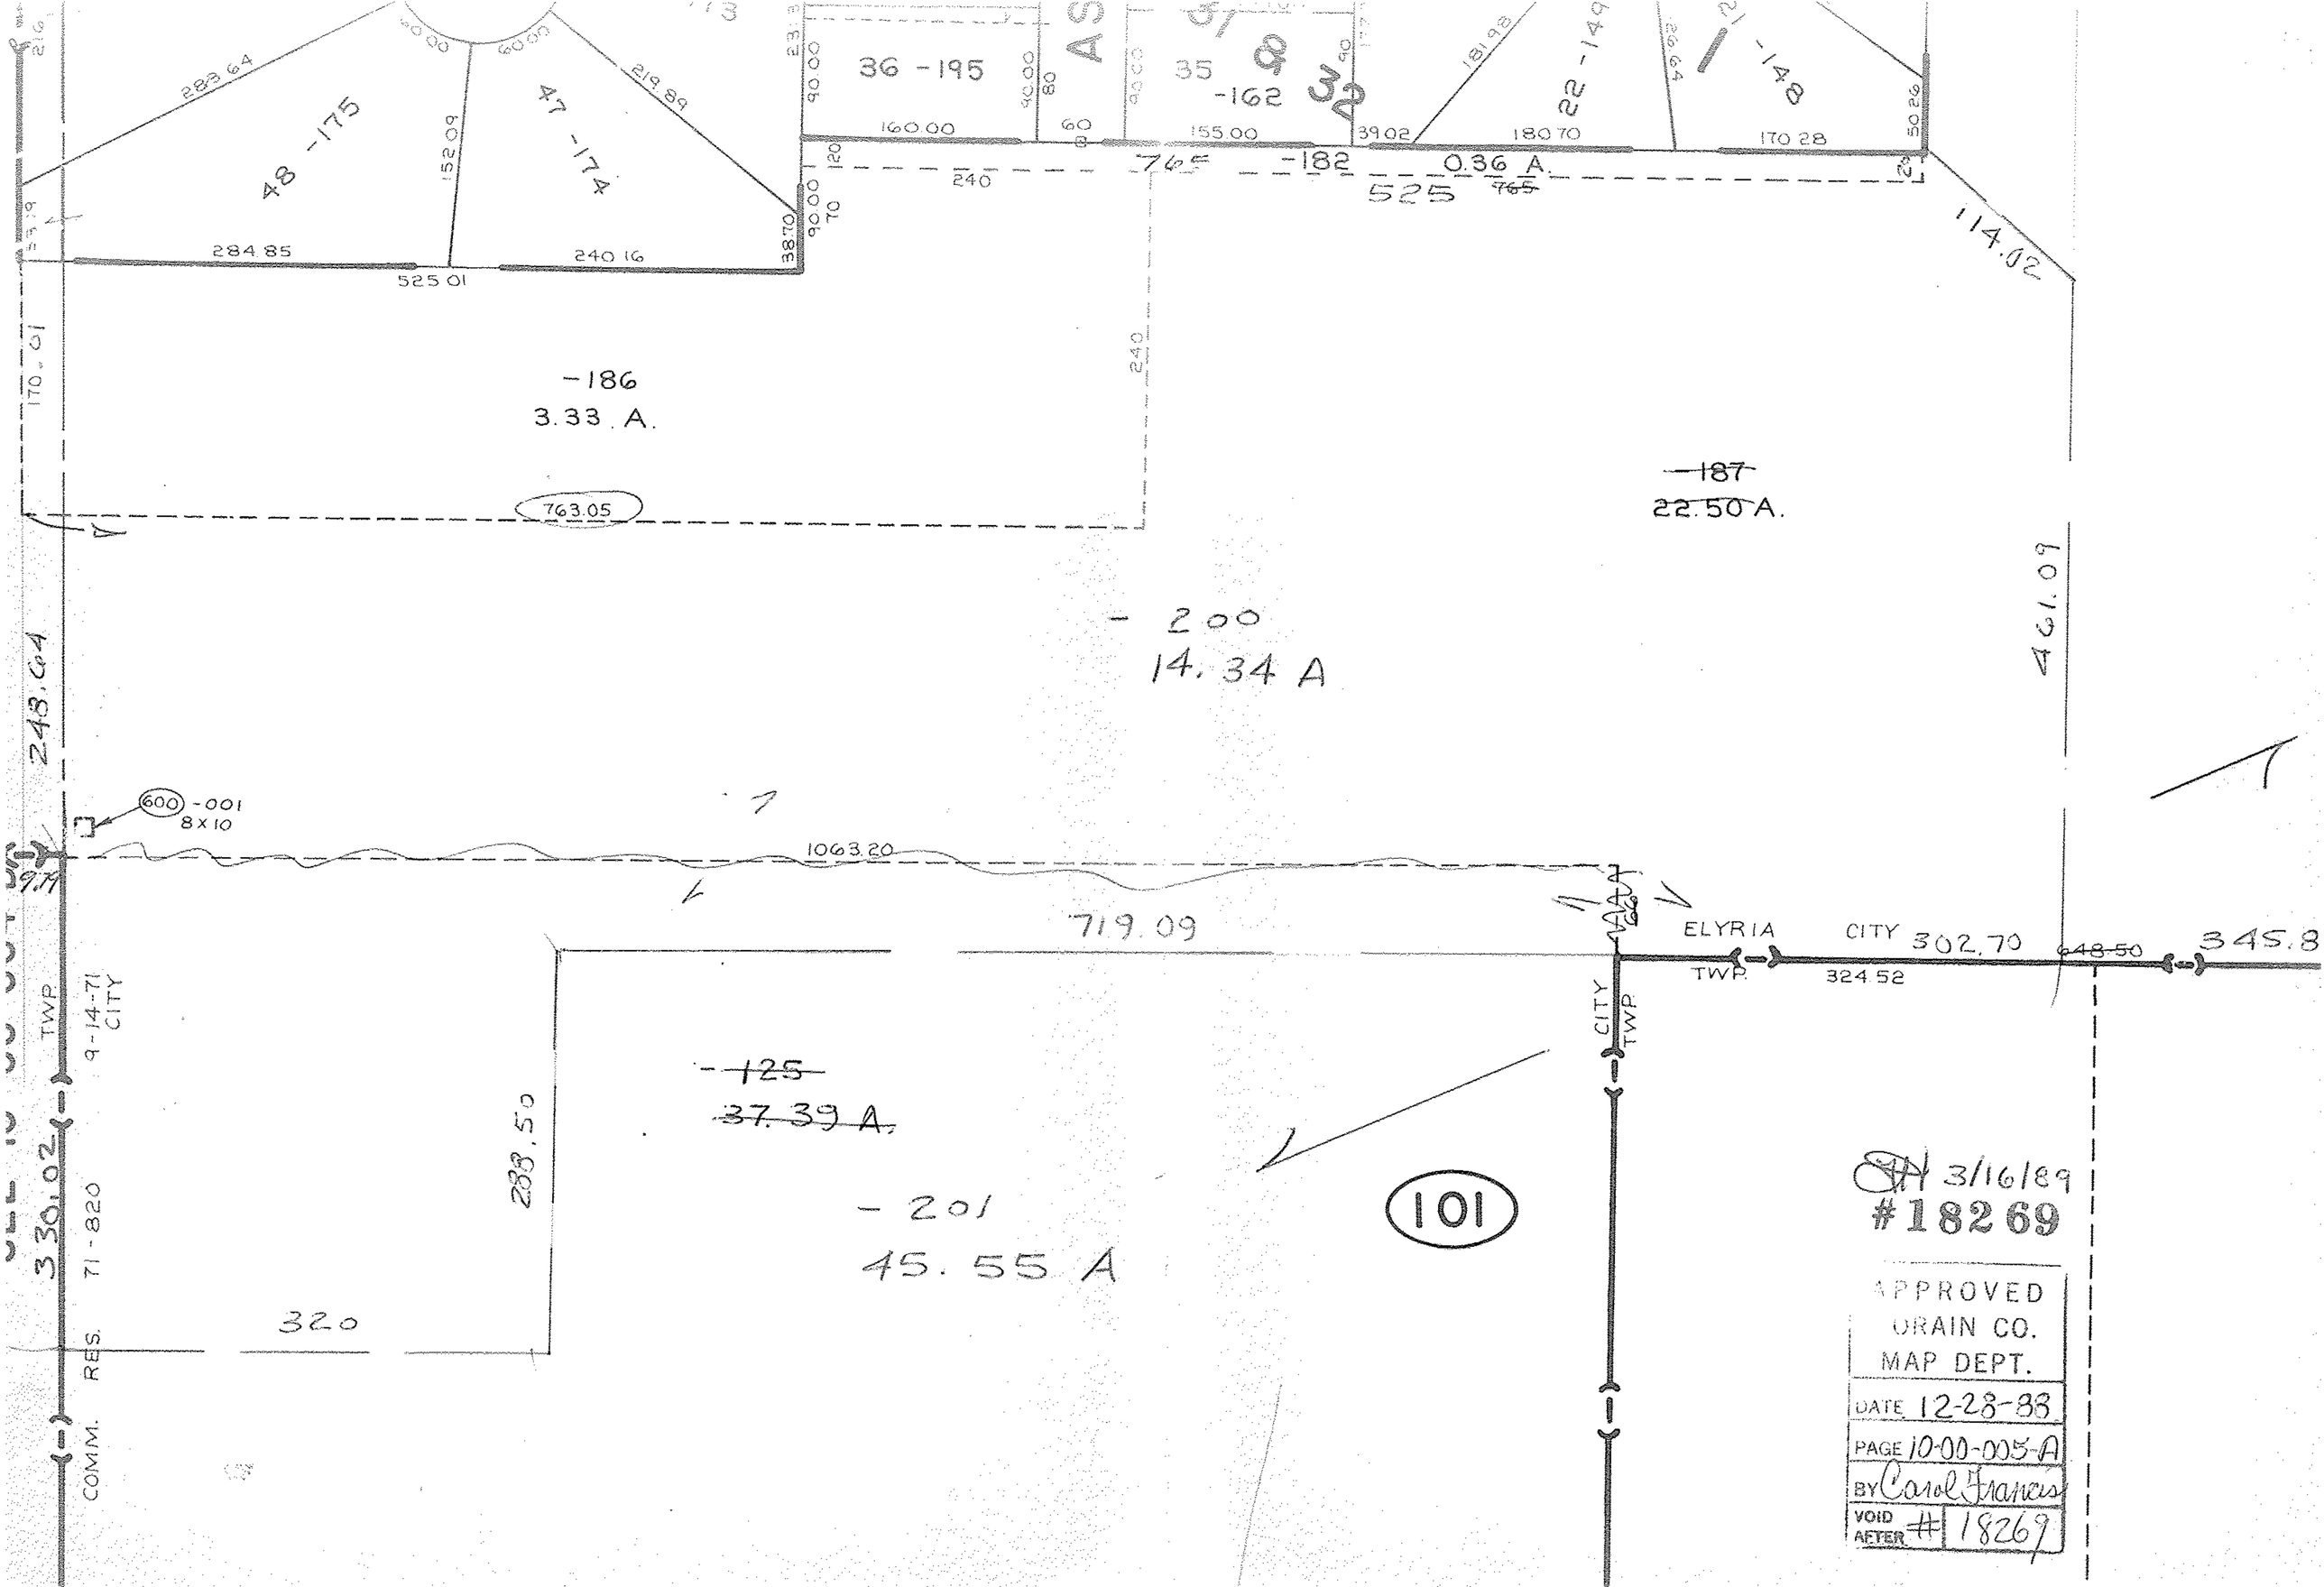

48 -175
47 -174
36 -195
35 -162
22 -149
-148
-182
0.36 A.
525
114.02
-186
3.33 A.
763.05
~~-187~~
~~22.50 A.~~
- 200
14.34 A
461.09
248.64
600 -001
8X10
1063.20
719.09
ELYRIA
TWP.
CITY
302.70
324.52
345.8
CITY
TWP.
9-14-71
CITY
TWP.
330.02
71-820
RES.
COMM.
~~-125~~
~~37.39 A.~~
288.50
- 201
45.55 A
320
101
3/16/89
#18269
APPROVED
DRAIN CO.
MAP DEPT.
DATE 12-28-88
PAGE 10-00-005-A
BY Carol Francis
VOID AFTER # 18269