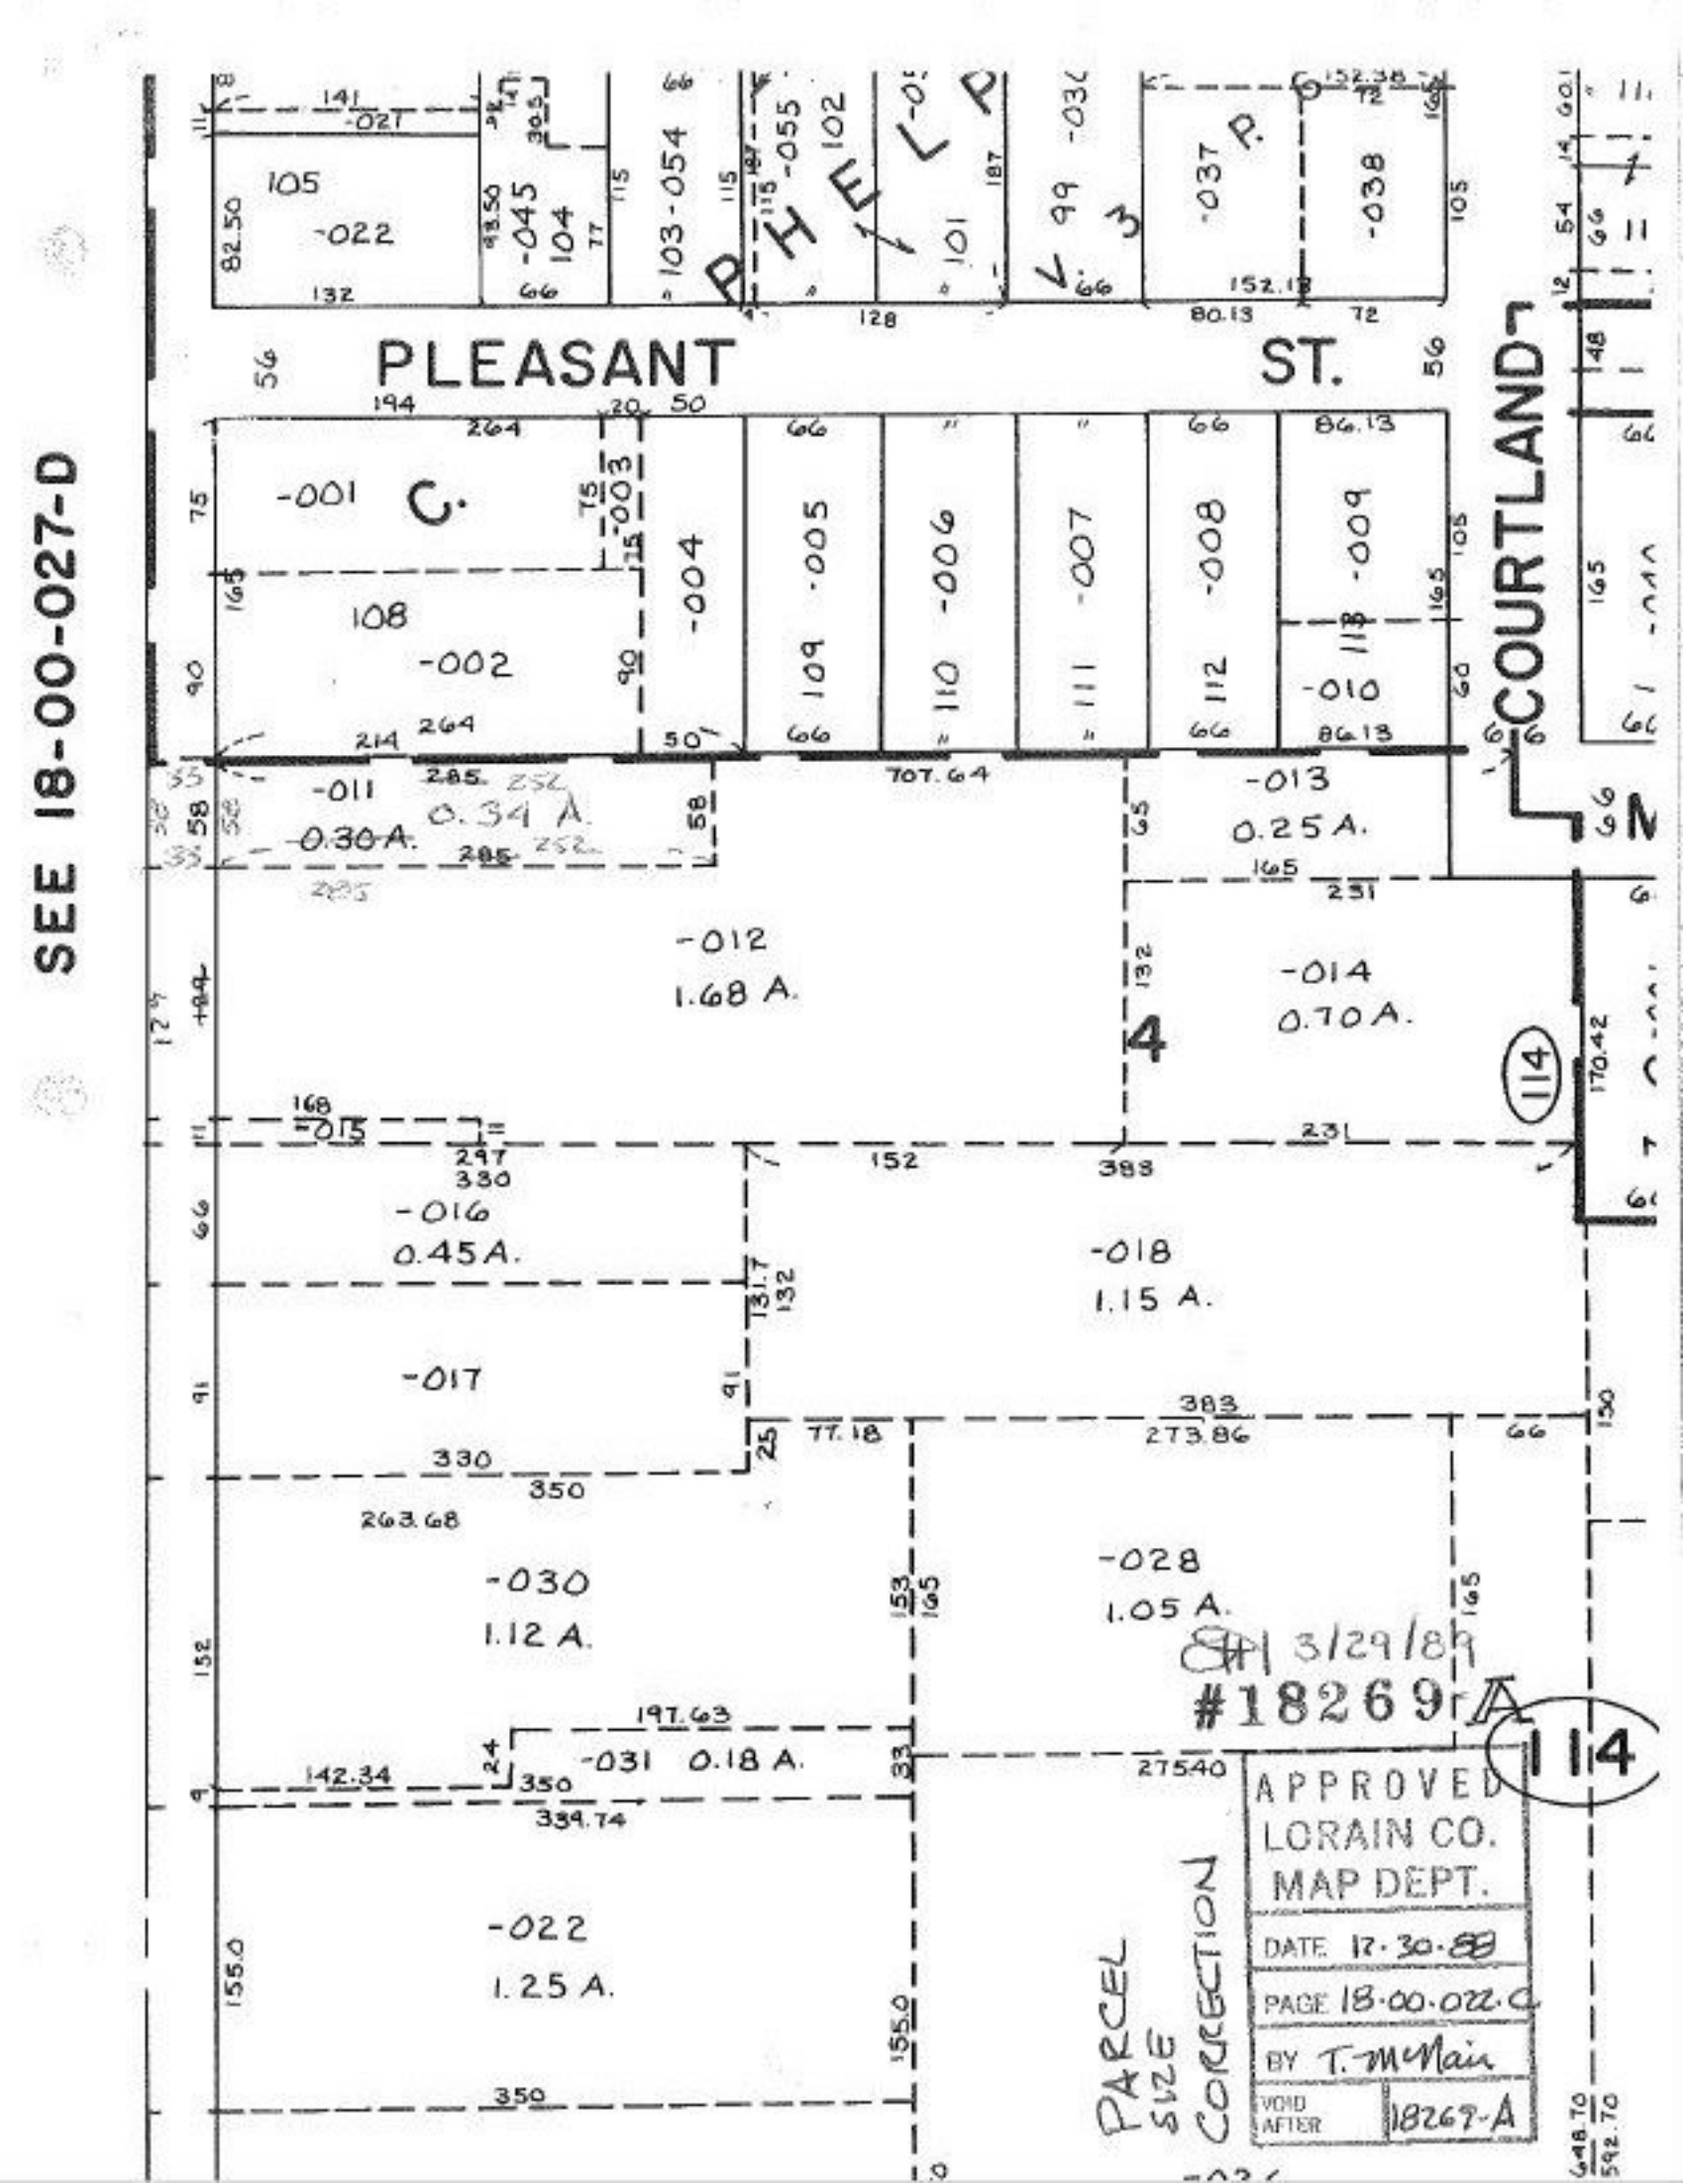
SEE 18-00-027-D
PLEASANT ST.
COURTLAND
-001
C.
-002
-003
-004
-005
-006
-007
-008
-009
-010
-011
-012
-013
-014
-015
-016
-017
-018
-022
-027
-030
-031
-037
-038
-045
-055
103-054
105
104
108
109
110
111
112
118
99
102
101
0.34 A.
0.30 A.
1.68 A.
0.25 A.
0.70 A.
0.45 A.
1.15 A.
1.12 A.
1.05 A.
0.18 A.
1.25 A.
707.64
273.86
197.63
339.74
263.68
4
114
3/29/89
#18269-A
APPROVED
LORAIN CO.
MAP DEPT.
DATE 12-30-89
PAGE 18-00-022.C
BY T. McMain
VOID AFTER 18269-A
PARCEL SIZE CORRECTION