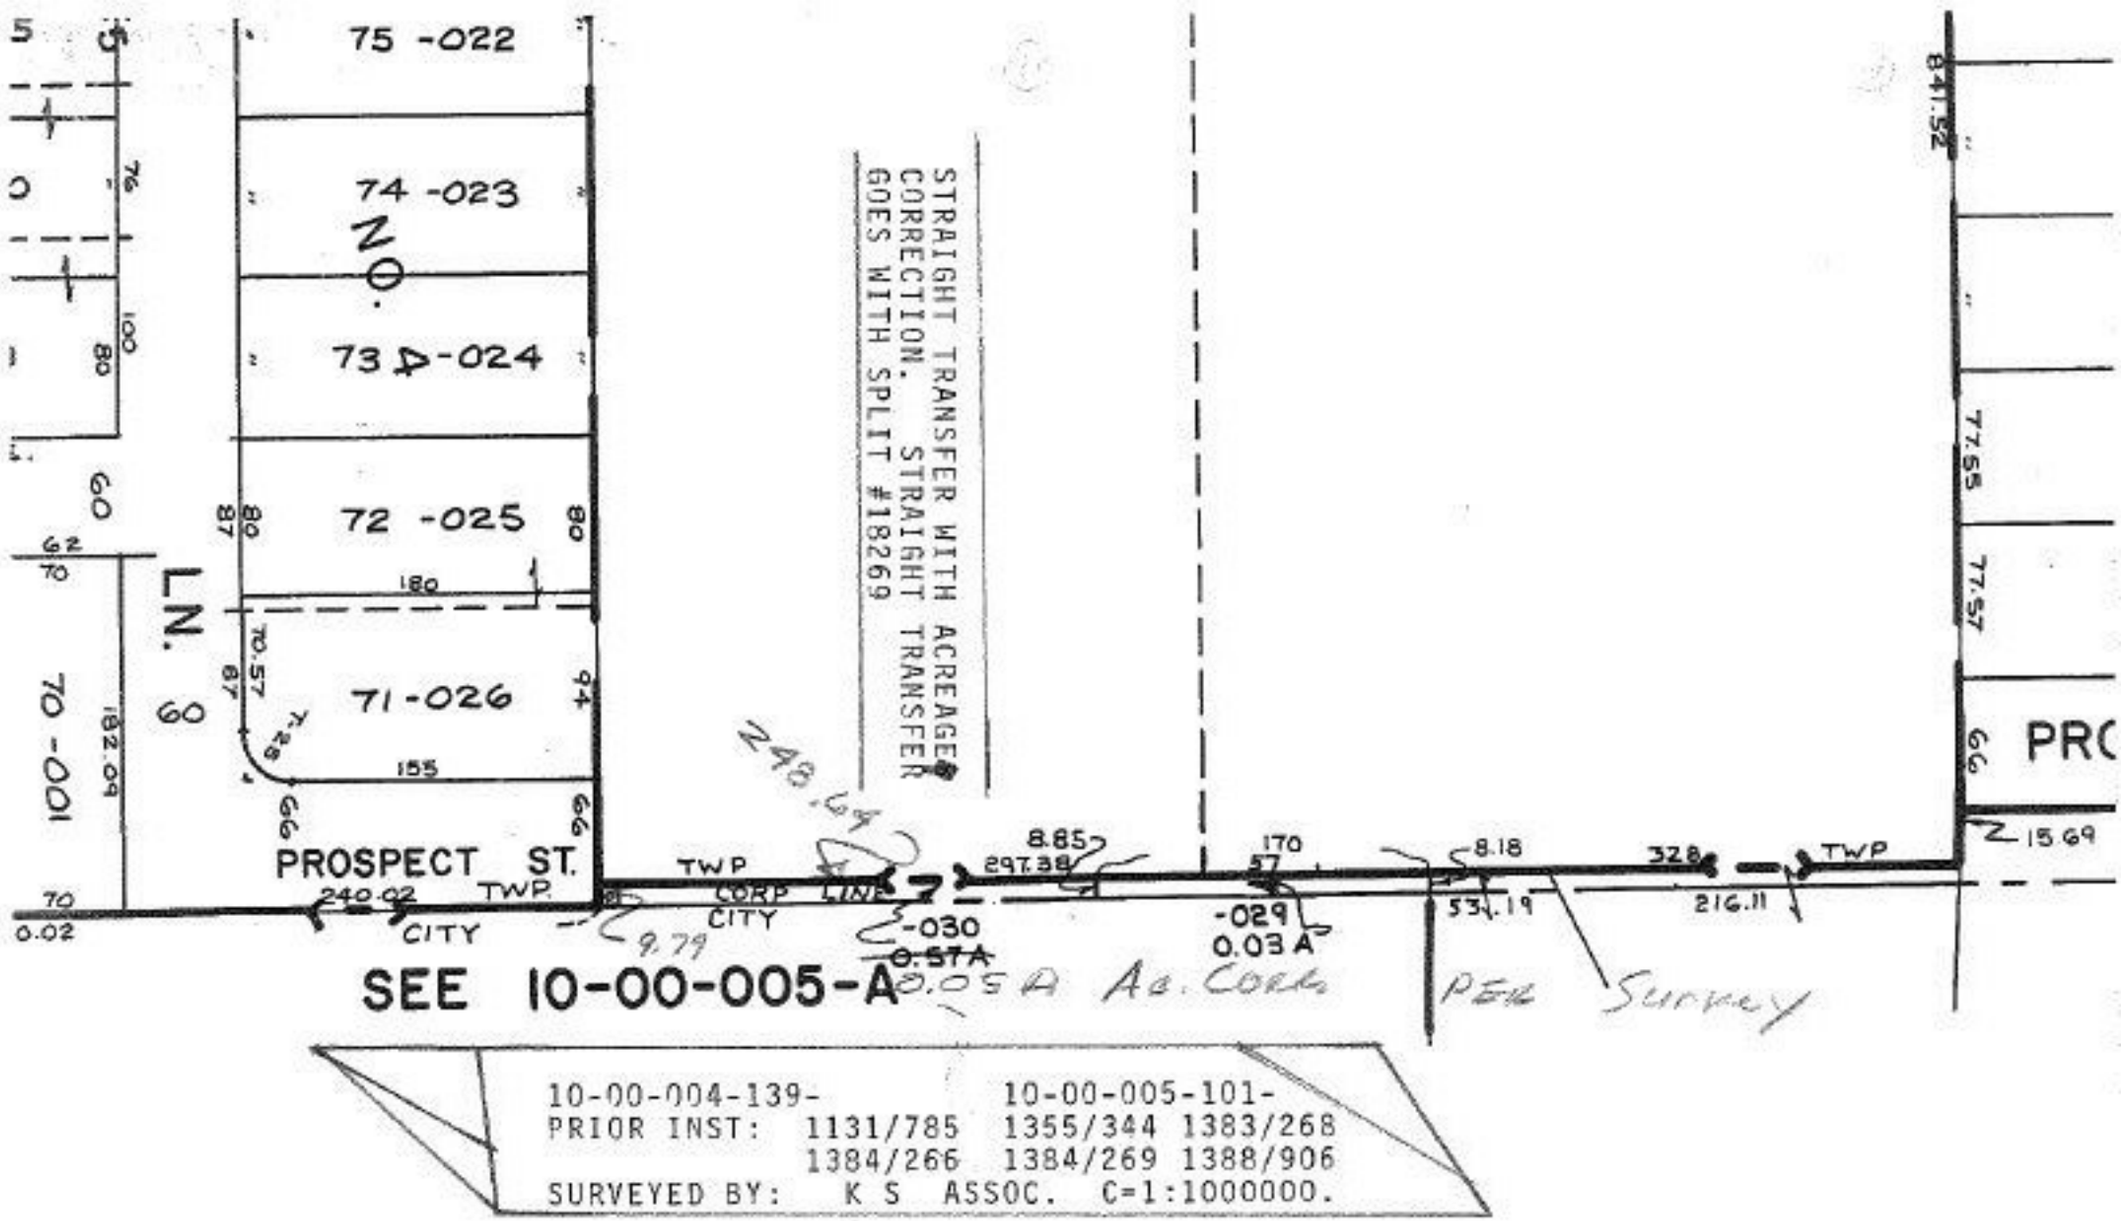

10-00-004-139- 10-00-005-101-
PRIOR INST: 1131/785 1355/344 1383/268
1384/266 1384/269 1388/906
SURVEYED BY: K S ASSOC. C=1:1000000.

APPROVED
LORAIN CO.
MAP DEPT.
DATE 12-23-88
PAGE 10-00-004-D
BY Carol Thomas
VOID AFTER #18269

3/16/89
#18269