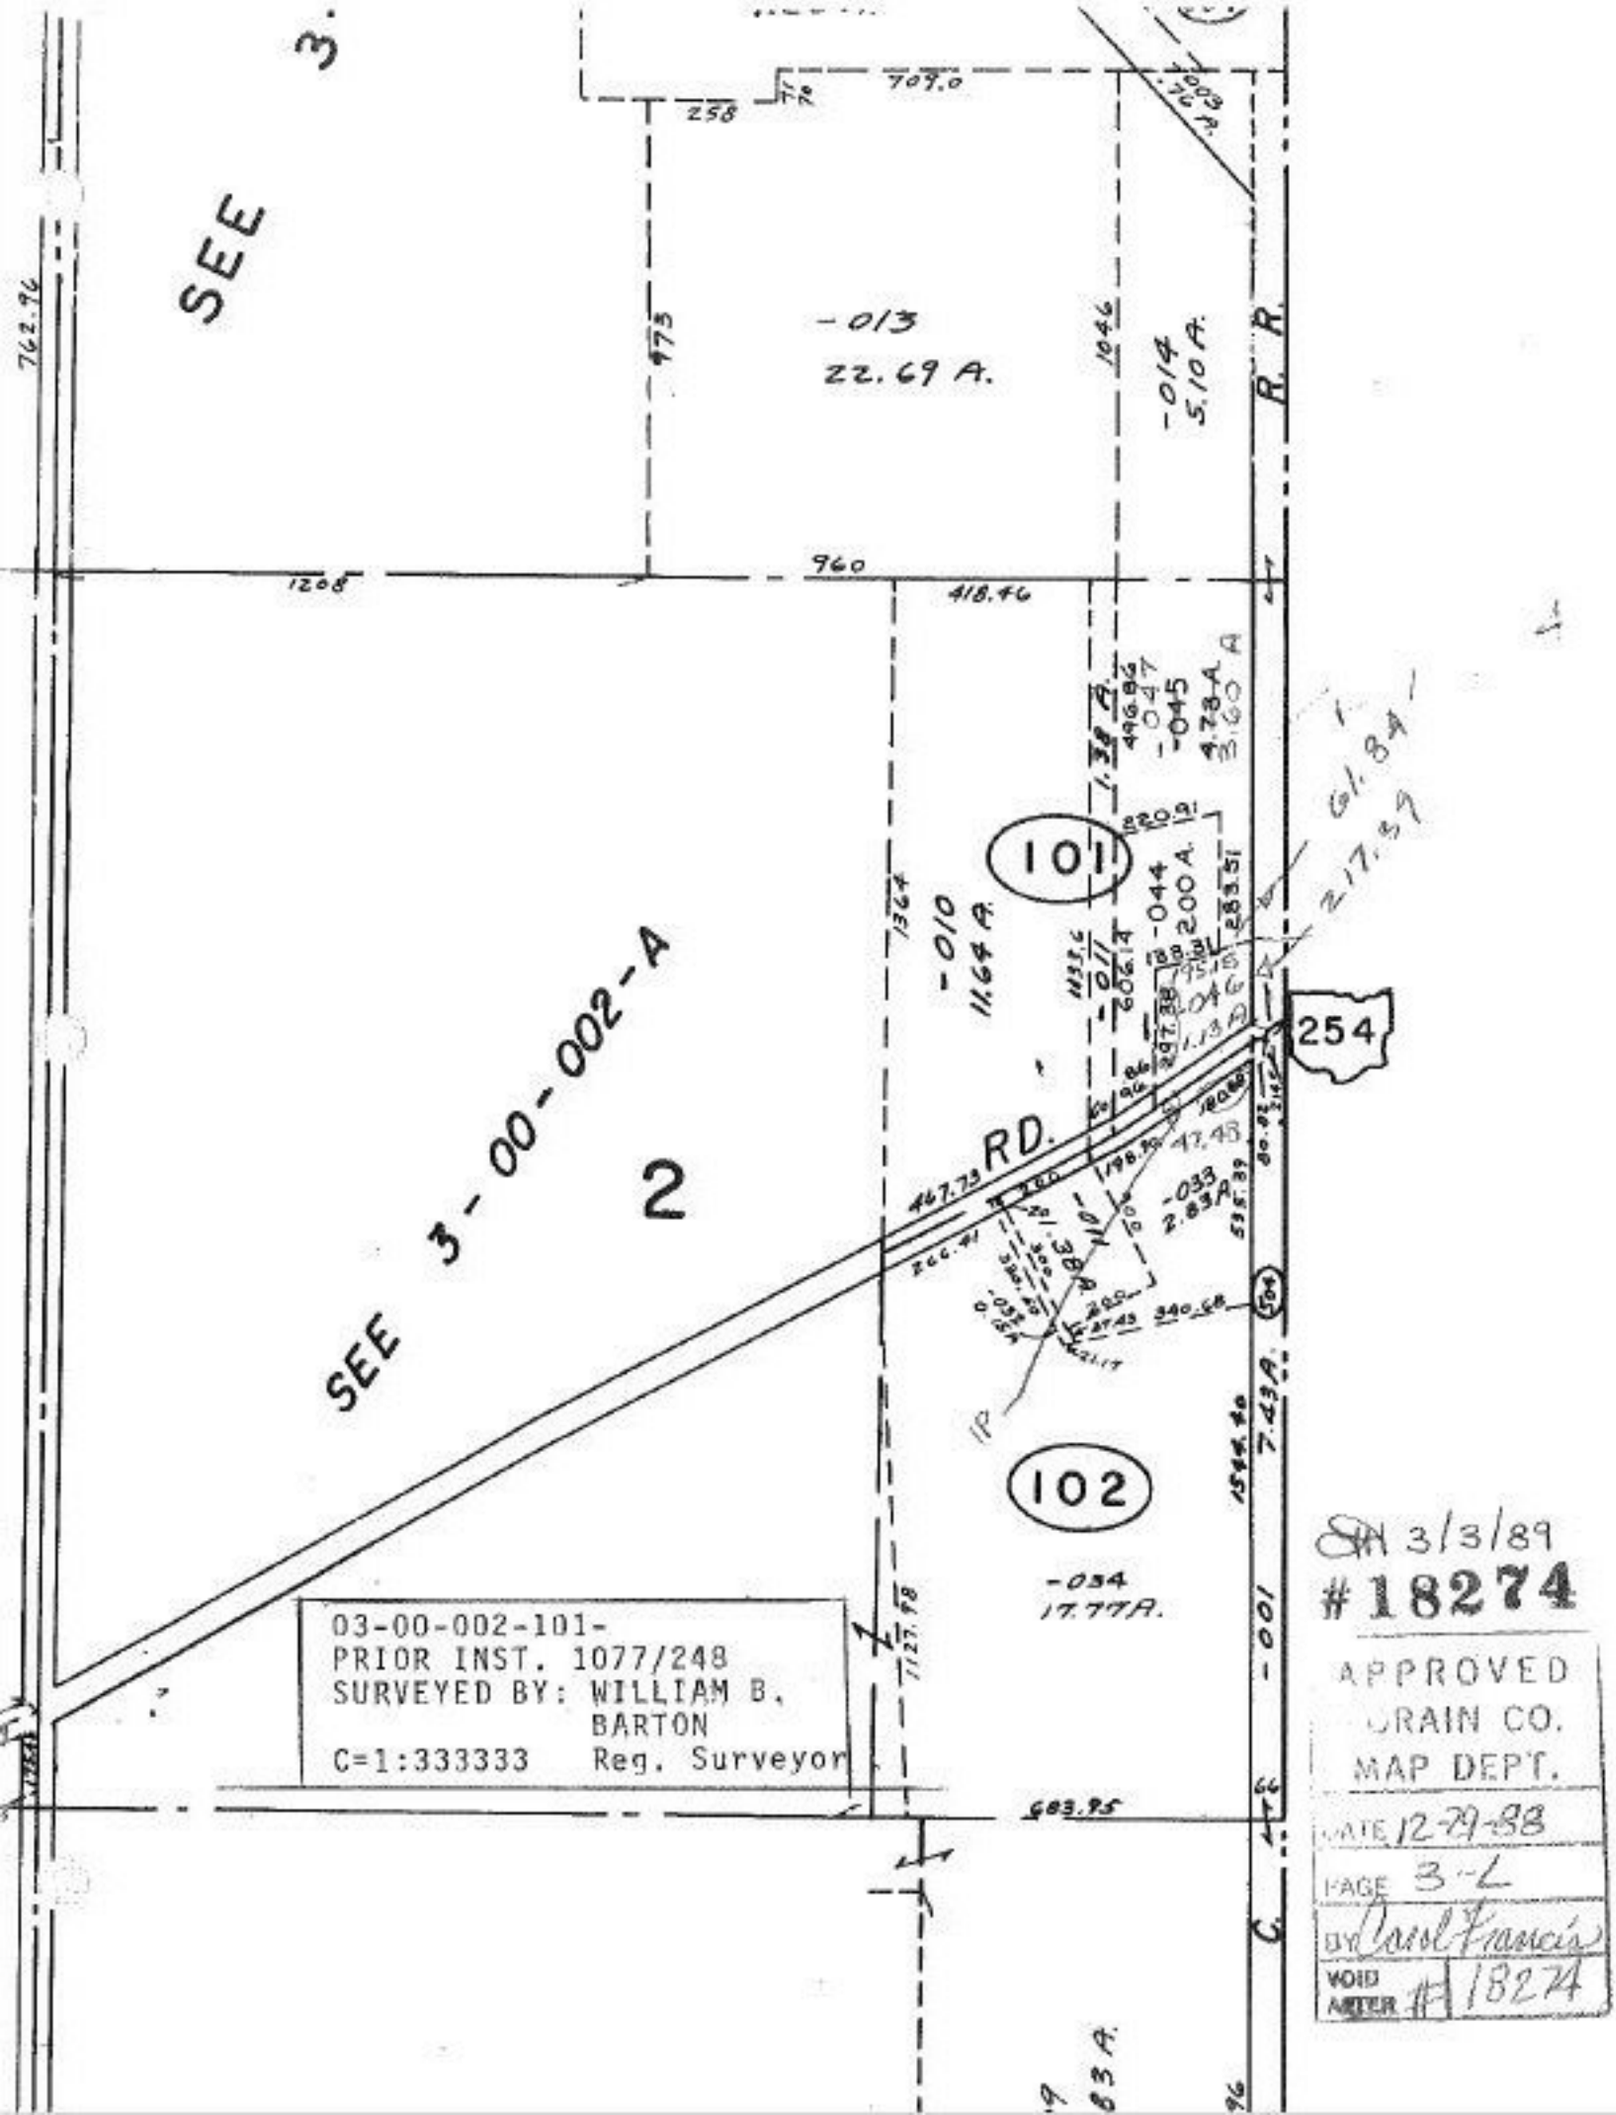

3/3/89
#18274

APPROVED
DRAIN CO.
MAP DEPT.
DATE 12-29-88
PAGE 3-L
BY Carol Francis
VOID AFTER # 18274