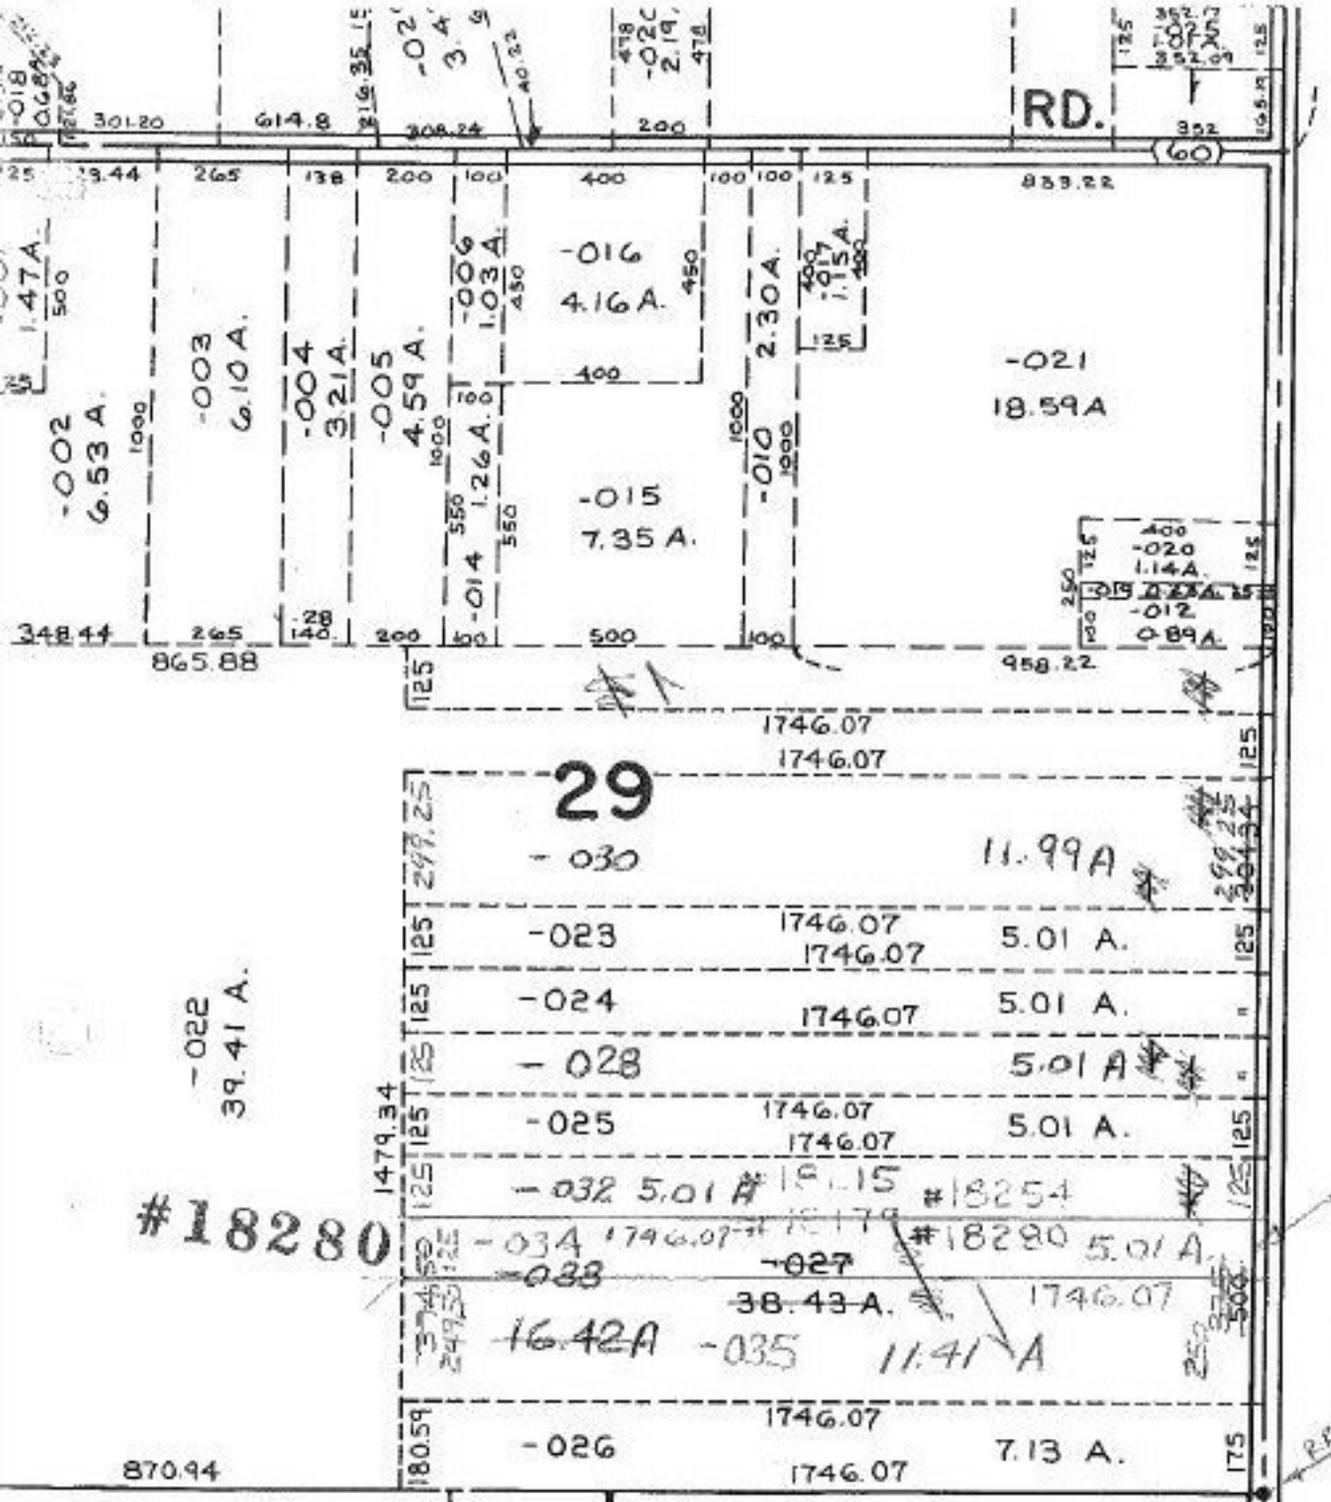

12-00-029-000-
PRIOR INST. 11 49/403
SURVEYED BY: JOHN POZYWAK
C=1: INF. REG. SURVEYOR

3/24/89

#18280

APPROVED
LORAIN CO.
MAP DEPT.

DATE 1-10-89

PAGE 12-G

BY Carol Francis

VOID AFTER #18280