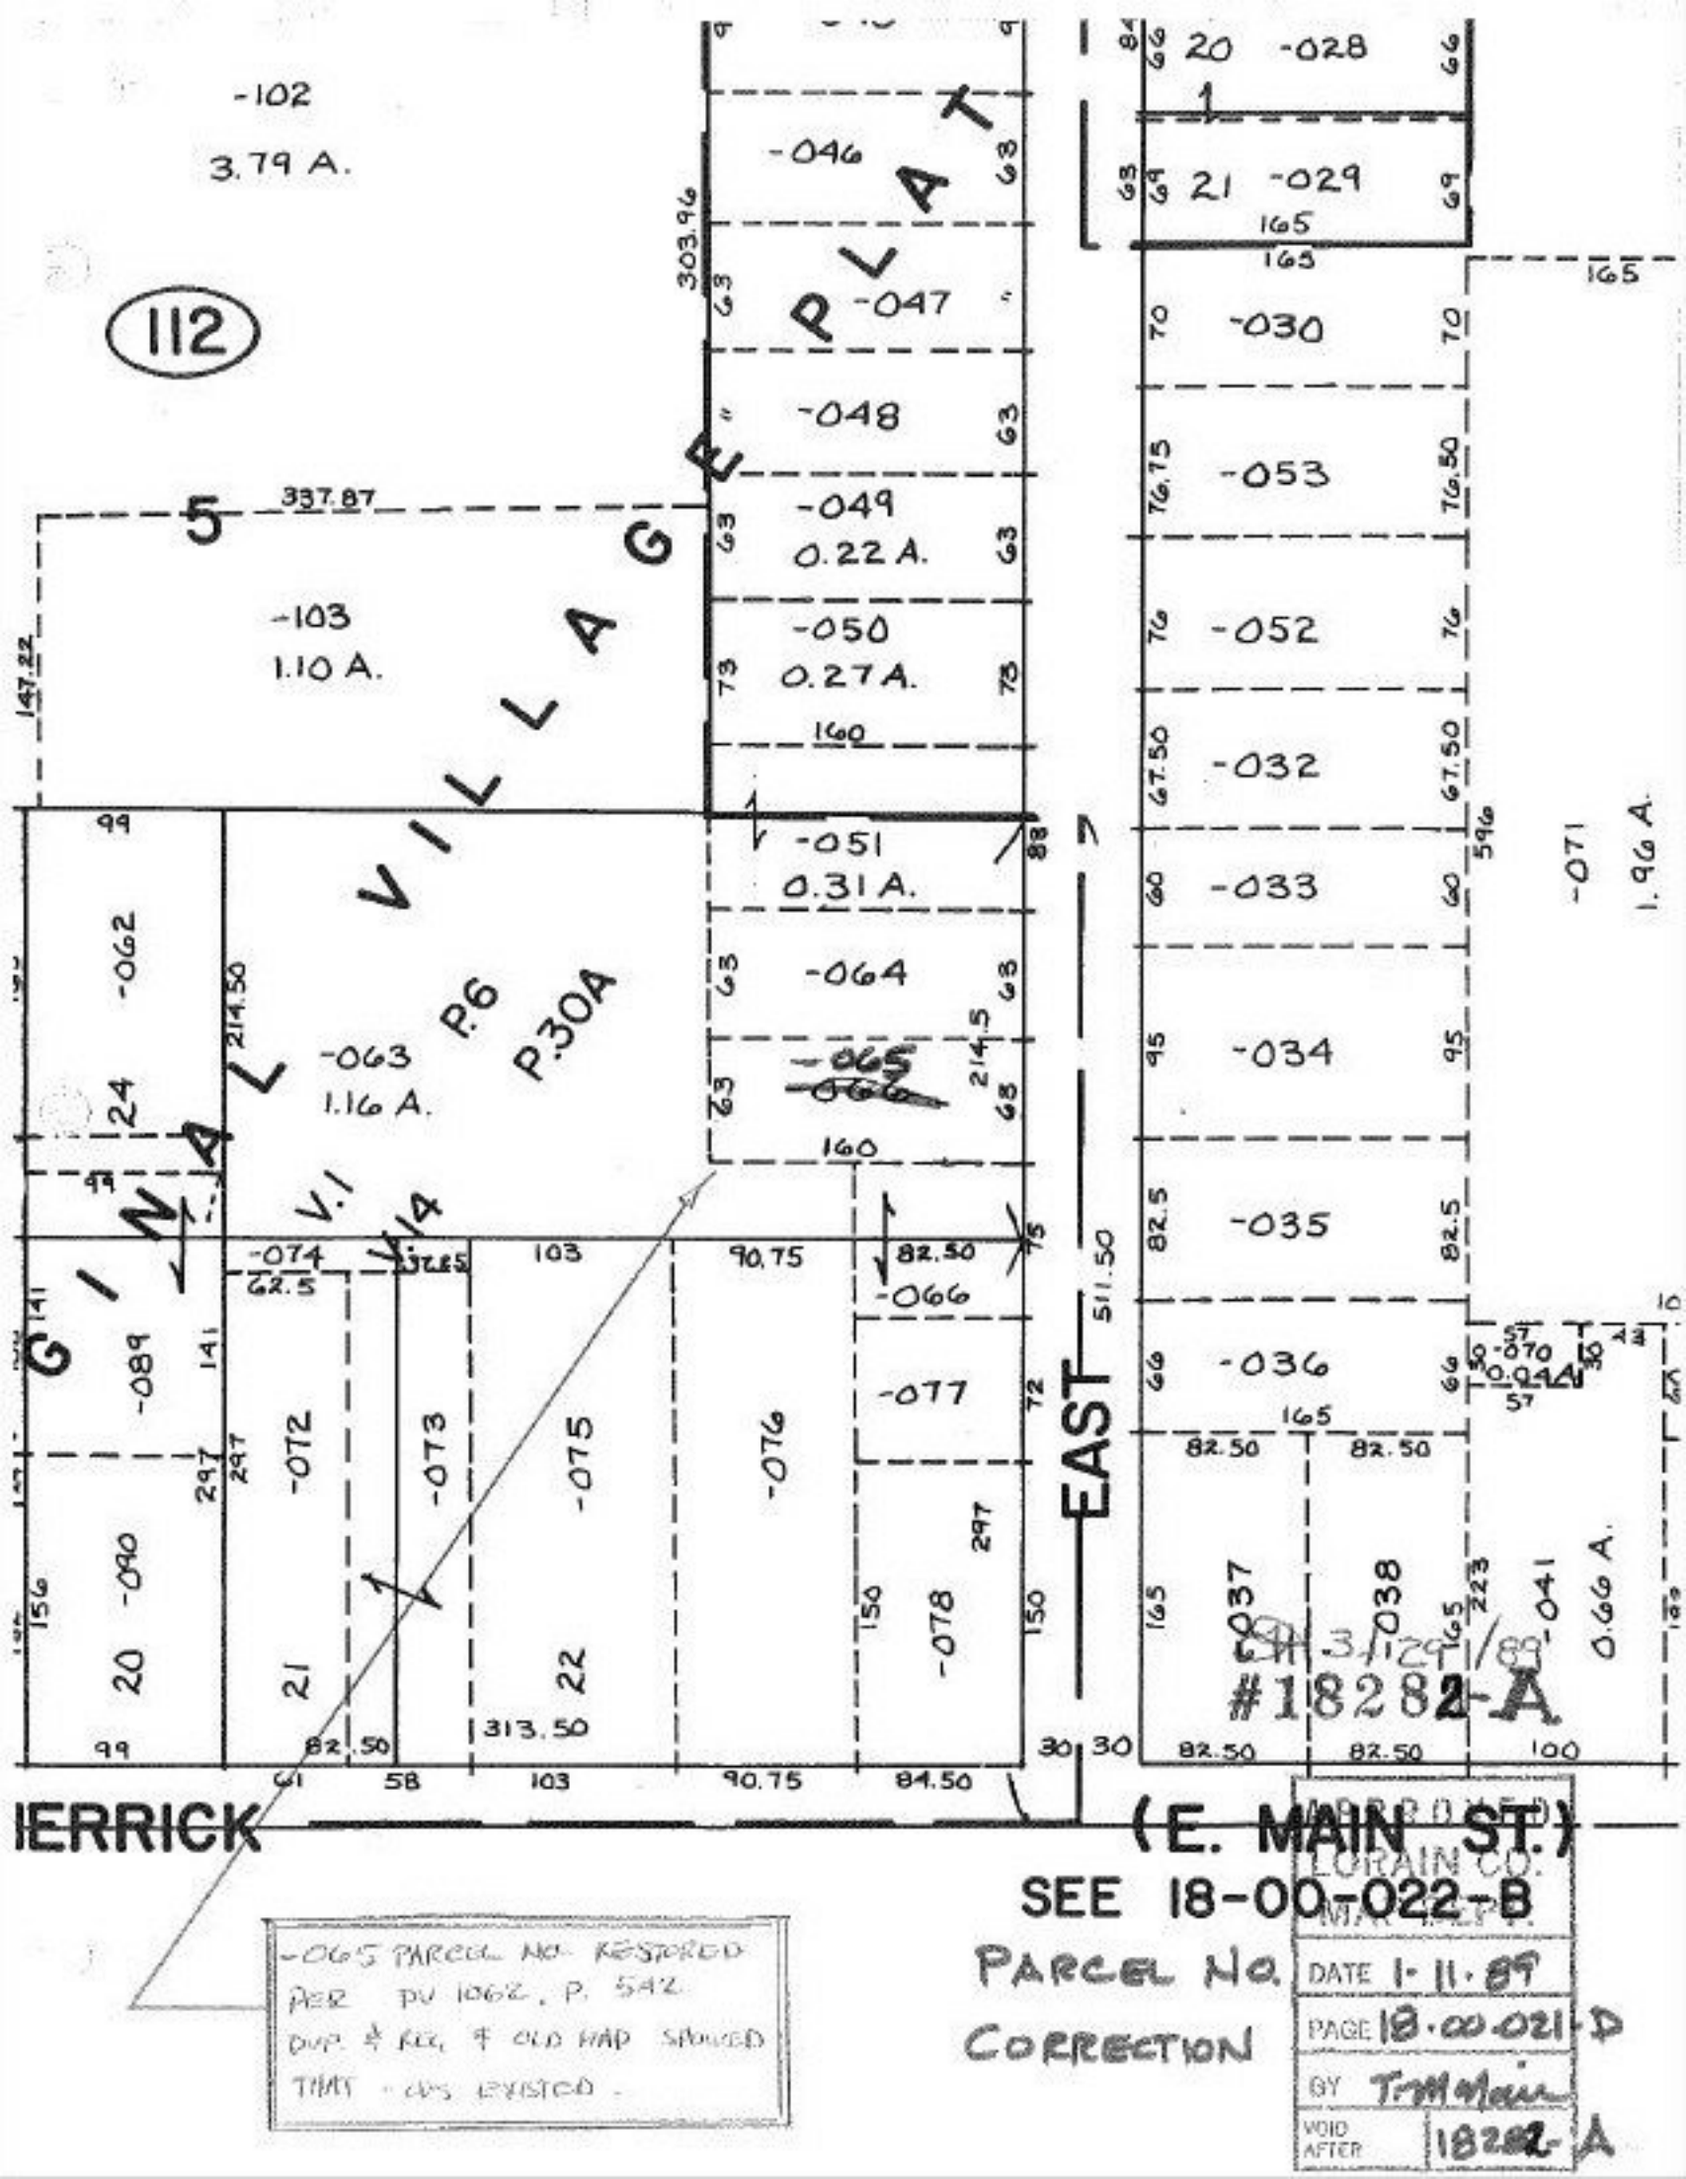

IERRICK (E. MAIN ST.)