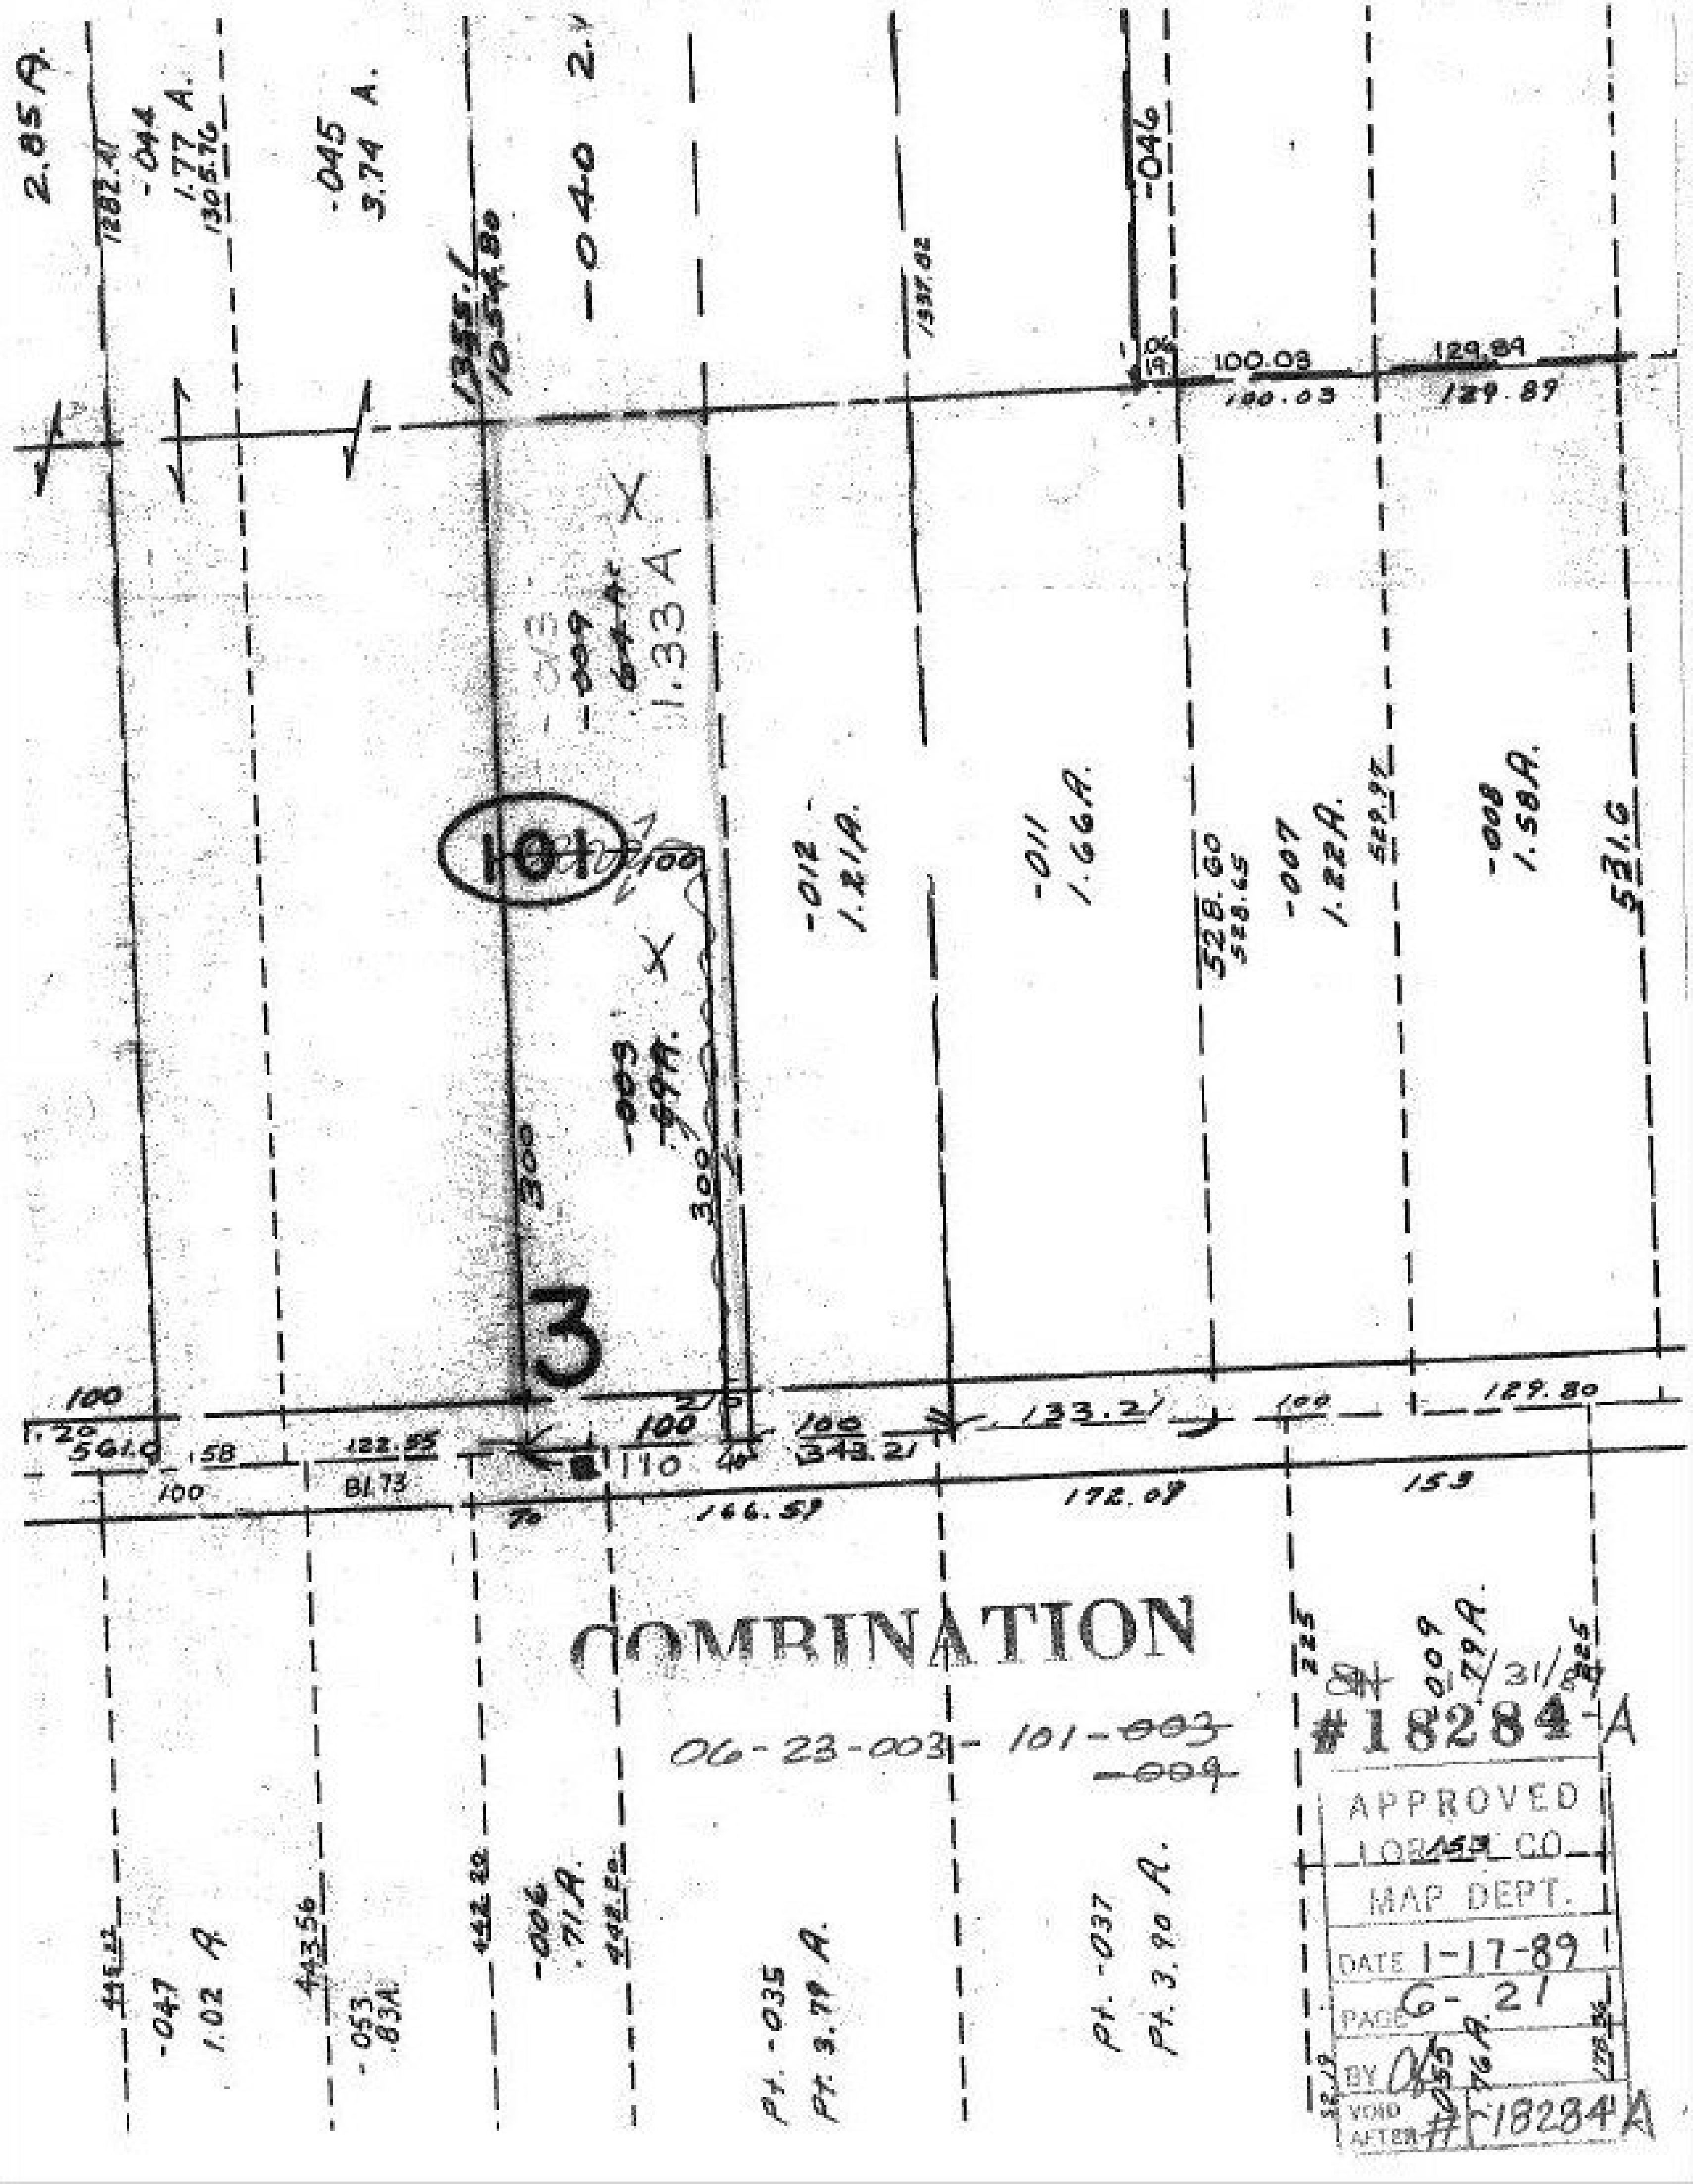
COMBINATION
06-23-003-101-003
-004
#18284-A
APPROVED
LORAIN CO.
MAP DEPT.
DATE 1-17-89
PAGE G-21
BY
VOID AFTER
#18284-A
101
3
100.03
129.89
133.21
129.80
122.55
81.73
166.51
172.07
343.21