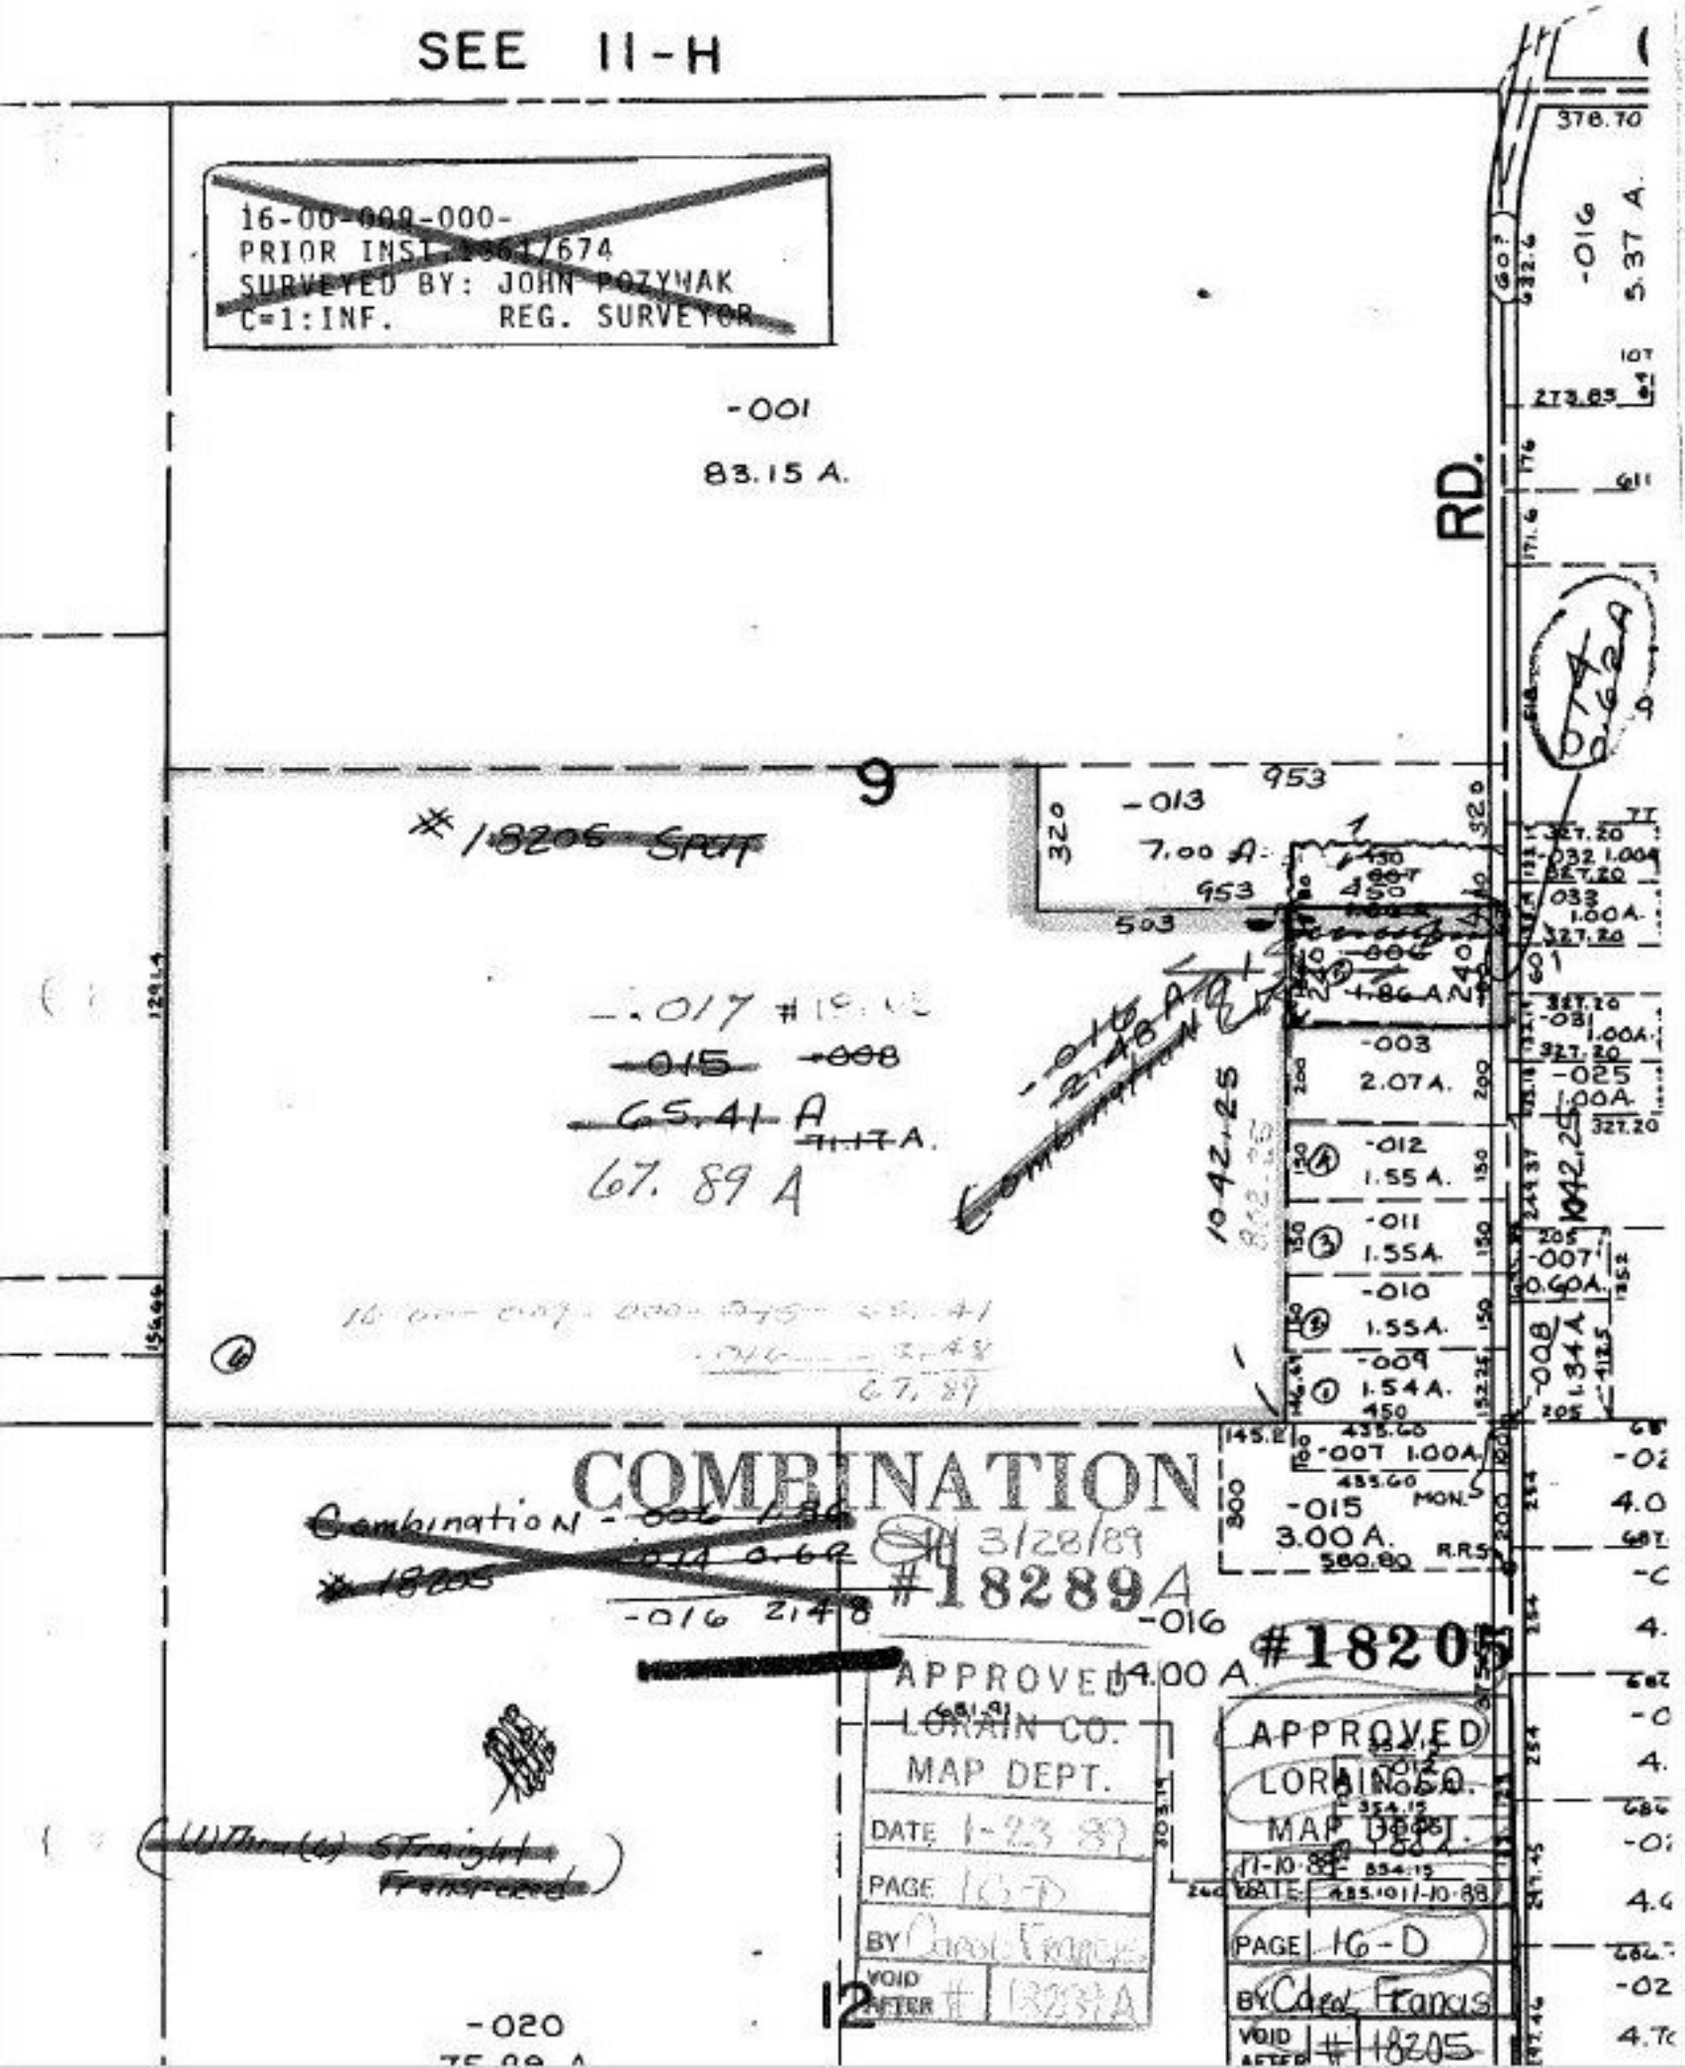
SEE 11-H
16-00-009-000-
PRIOR INST. 1361/674
SURVEYED BY: JOHN POZYWAK
C=1:INF. REG. SURVEYOR
-001
83.15 A.
RD.
9
-013
7.00 A.
953
503
-017
-015
-008
65.41 A
67.89 A
-003
2.07 A.
-012
1.55 A.
-011
1.55 A.
-010
1.55 A.
-009
1.54 A.
-007
1.00 A.
-015
3.00 A.
-016
14.00 A.
COMBINATION
3/28/89
#18289A
#18205
APPROVED
LORAIN CO.
MAP DEPT.
DATE 1-23-89
PAGE 16-D
BY Carol Francis
VOID AFTER # 18289A
APPROVED
LORAIN CO.
MAP DEPT.
DATE 11-10-88
PAGE 16-D
BY Carol Francis
VOID AFTER # 18205
12
-020
-016
5.37 A.
-025
1.00 A.
-007
0.60 A.
-008
1.34 A.
-032
1.00 A.
-031
1.00 A.
-033
1.00 A.
-006
1.86 A.
1042.25
1042.25
378.70
273.85
-016
2.48
67.89