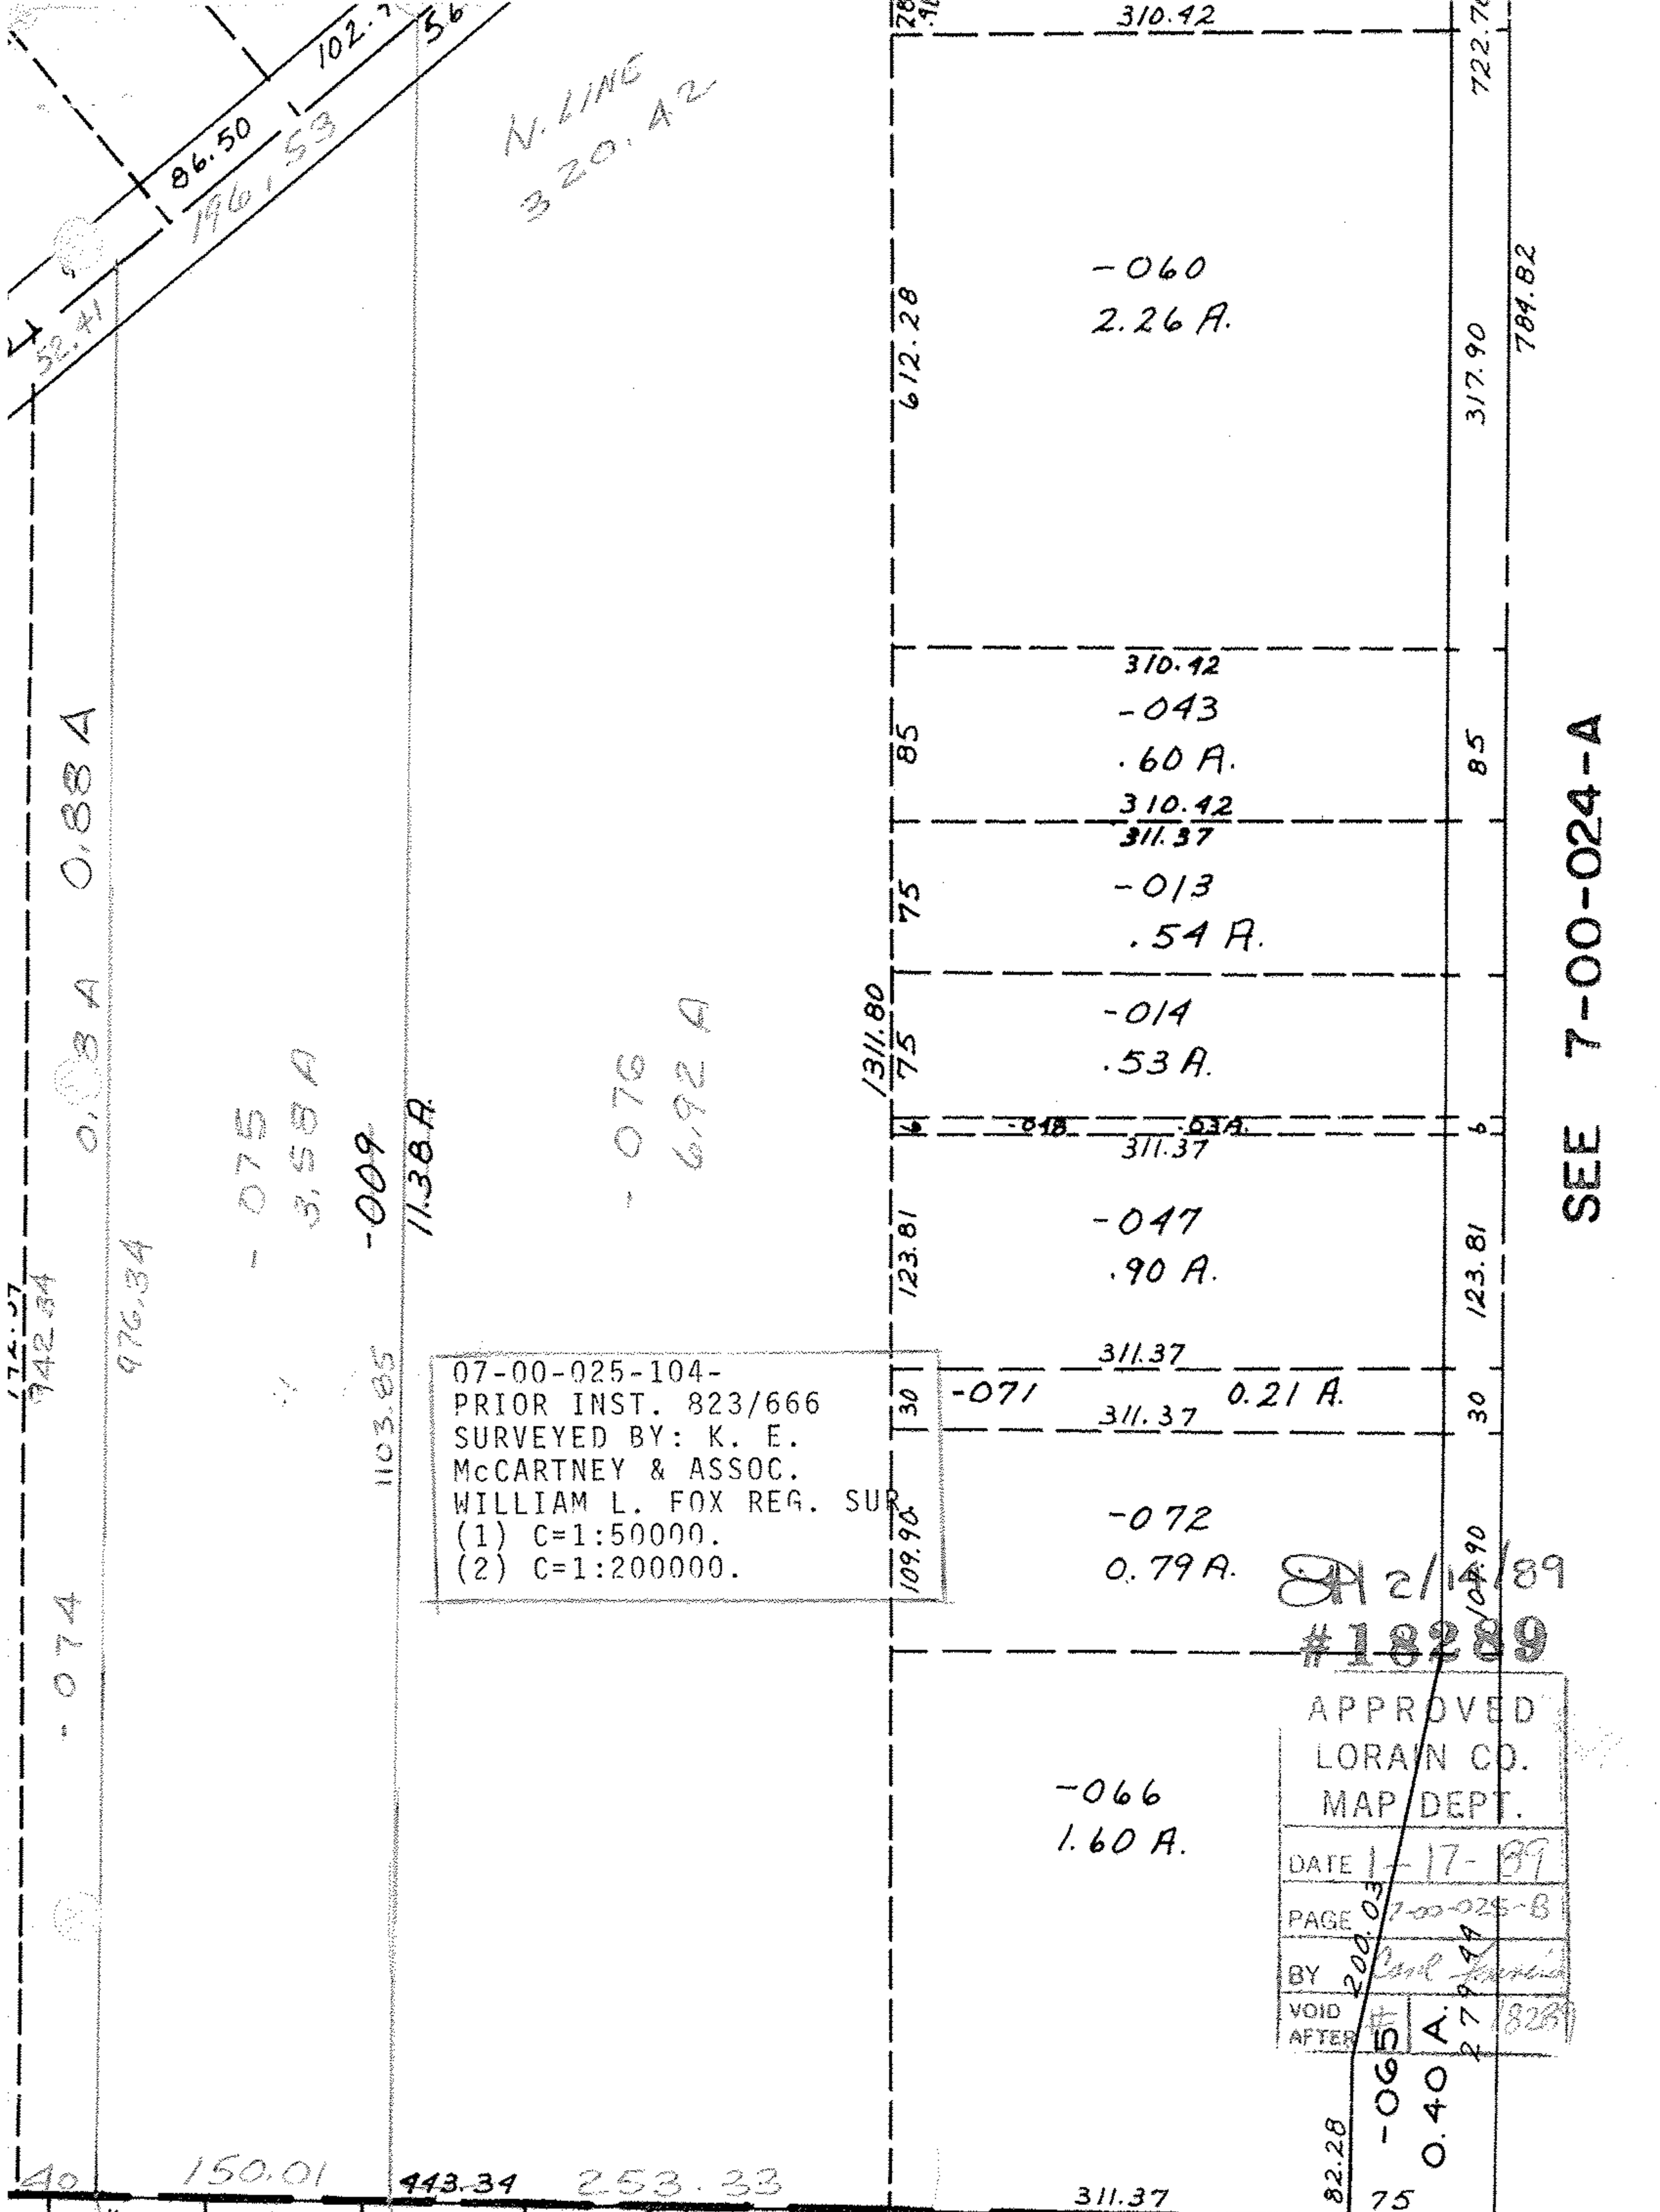
N. LINE
320.42
86.50
102.7
36
52.41
N 60° 53
0.88 A
-060
2.26 A.
310.42
722.76
612.28
784.82
317.90
85
-043
.60 A.
310.42
311.37
75
-013
.54 A.
-014
.53 A.
311.80
-018
.53A.
311.37
123.81
-047
.90 A.
311.37
30
-071
0.21 A.
311.37
109.90
-072
0.79 A.
-066
1.60 A.
82.28
-065
0.40 A.
75
SEE 7-00-024-A
07-00-025-104-
PRIOR INST. 823/666
SURVEYED BY: K. E.
McCARTNEY & ASSOC.
WILLIAM L. FOX REG. SUR
(1) C=1:50000.
(2) C=1:200000.
-075
3.550 A.
-009
11.38 A.
1103.85
-076
3.92 A.
0.88 A
0.74 A.
942.84
976.34
174.37
-074
40
150.01
443.34
253.33
311.37
200.03
APPROVED
LORAIN CO.
MAP DEPT.
DATE 1-17-89
PAGE 7-00-025-B
BY Carl Francis
#18289
2/15/89
#18289