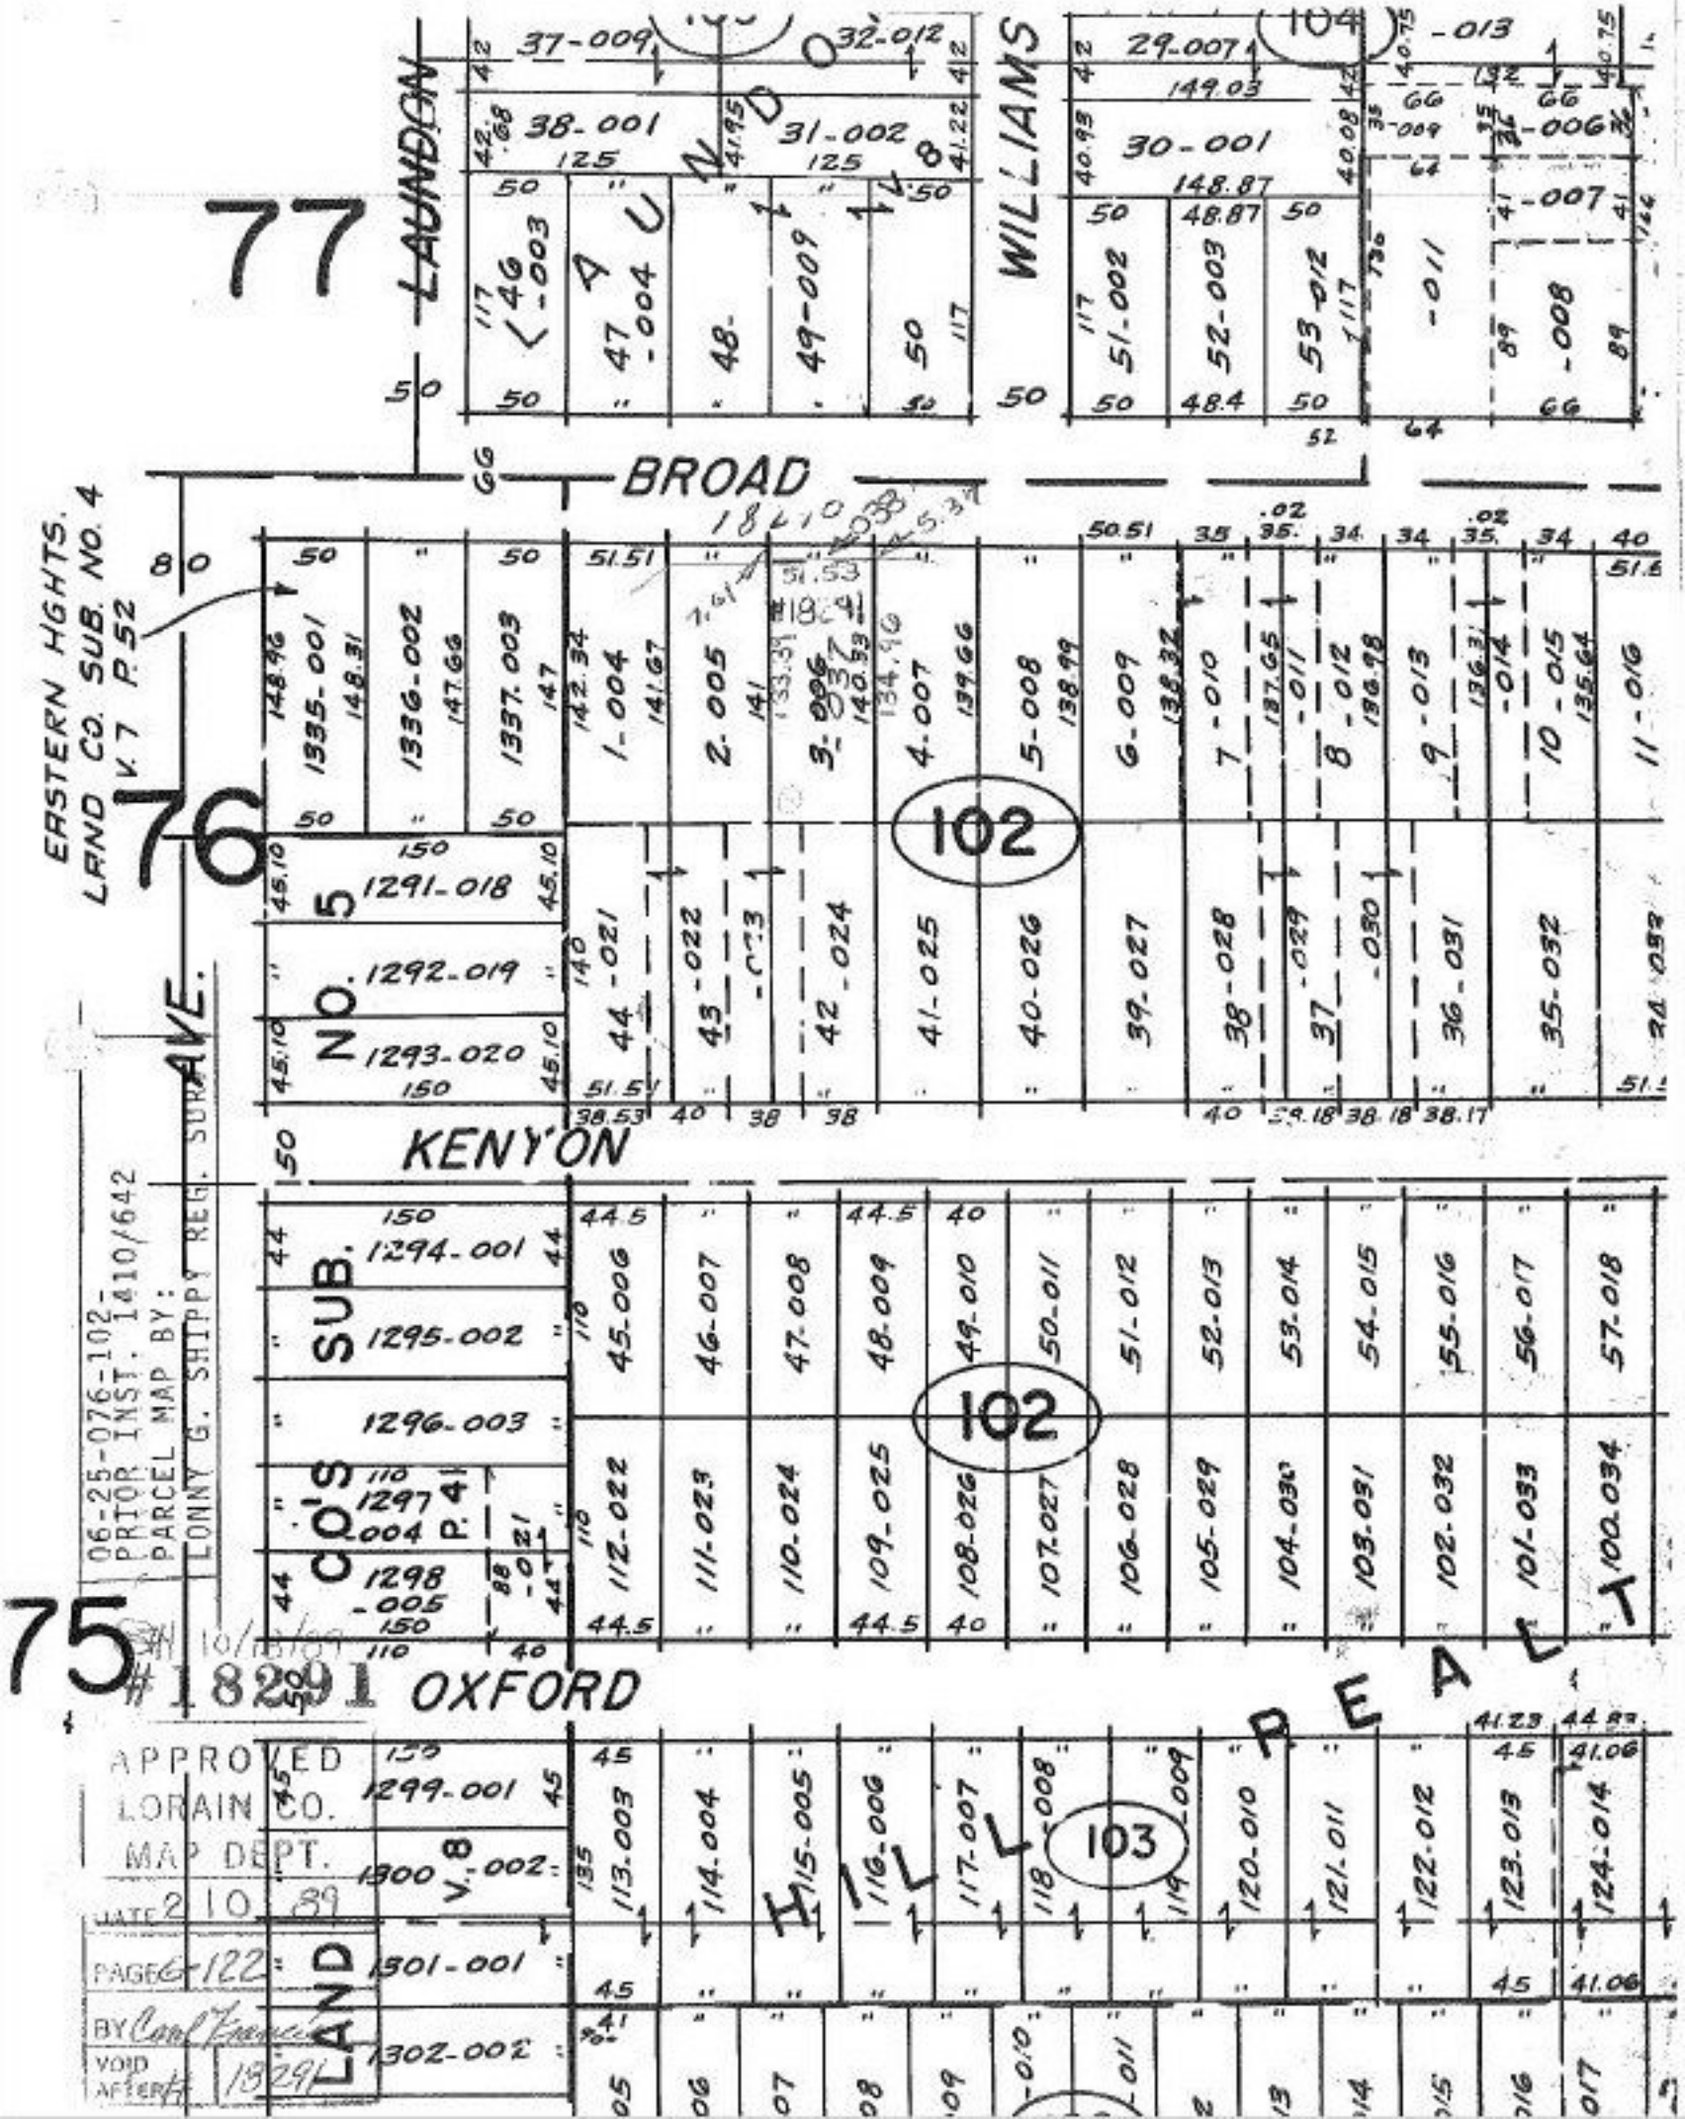
77
76
75
LAUNDON
WILLIAMS
BROAD
KENYON
OXFORD
AVE.
EASTERN HGHTS.
LAND CO. SUB. NO. 4
V. 7 P. 52
LAND CO'S SUB. NO. 5
HILL REALT
102
103
104
06-25-076-102-
PRIOR INST. 1410/642
PARCEL MAP BY:
LONNY G. SHIPPY REG. SUR.
#18291
APPROVED
LORAIN CO.
MAP DEPT.
DATE 2 10 89
PAGE 6-122
BY Carl Francis
VOID AFTER 18291