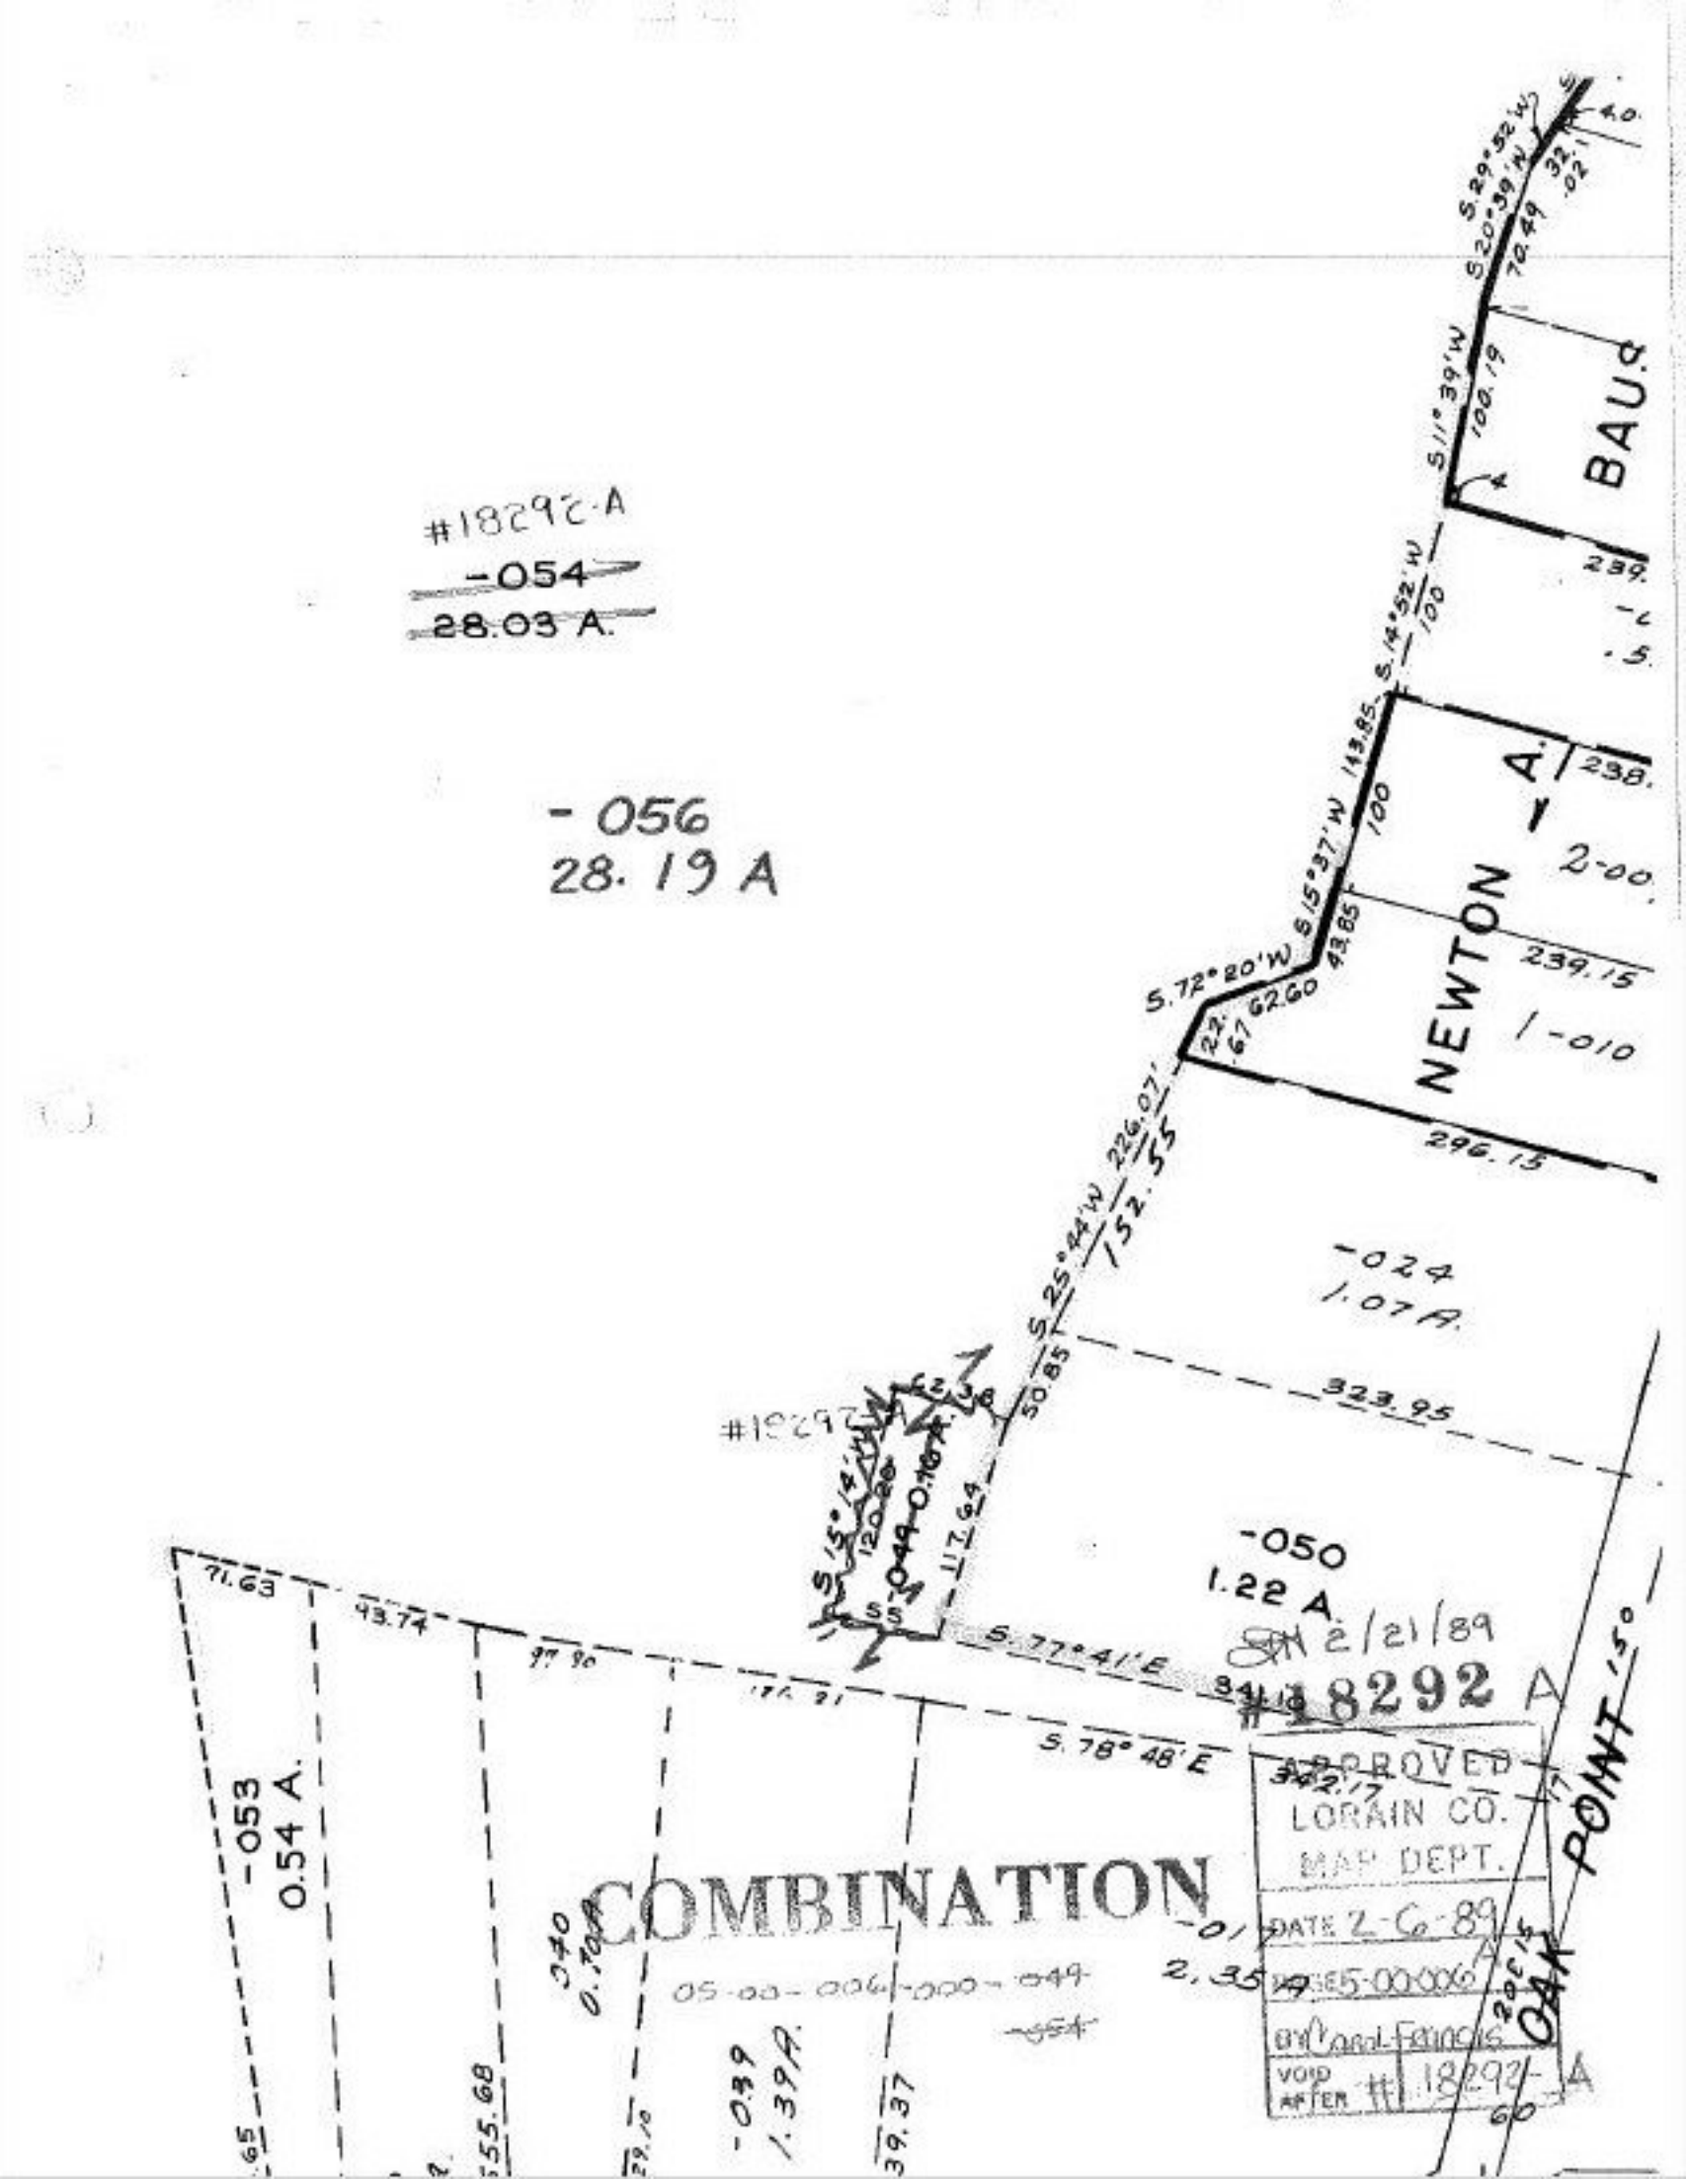
#18292-A
-054
28.03 A.
-056
28.19 A
NEWTON - A.
BAUD
-024
1.07 A.
-050
1.22 A
-053
0.54 A.
-039
1.39 A.
-040
0.70 A.
-01
2.35 A
#18292
#18292-A
2/21/89
COMBINATION
05-00-004-000-049
APPROVED
LORAIN CO.
MAP DEPT.
DATE 2-6-89
OAK POINT
S.29°52'W 70.49
S.11°39'W 100.19
S.14°52'W 100
S.15°37'W 143.85
S.72°20'W 43.85
S.25°44'W 226.07
152.55
S.15°14'W 120.26
S.78°48'E
S.77°41'E
323.95
296.15
239.15
238.
71.63
93.74
97.96
55.68
39.37