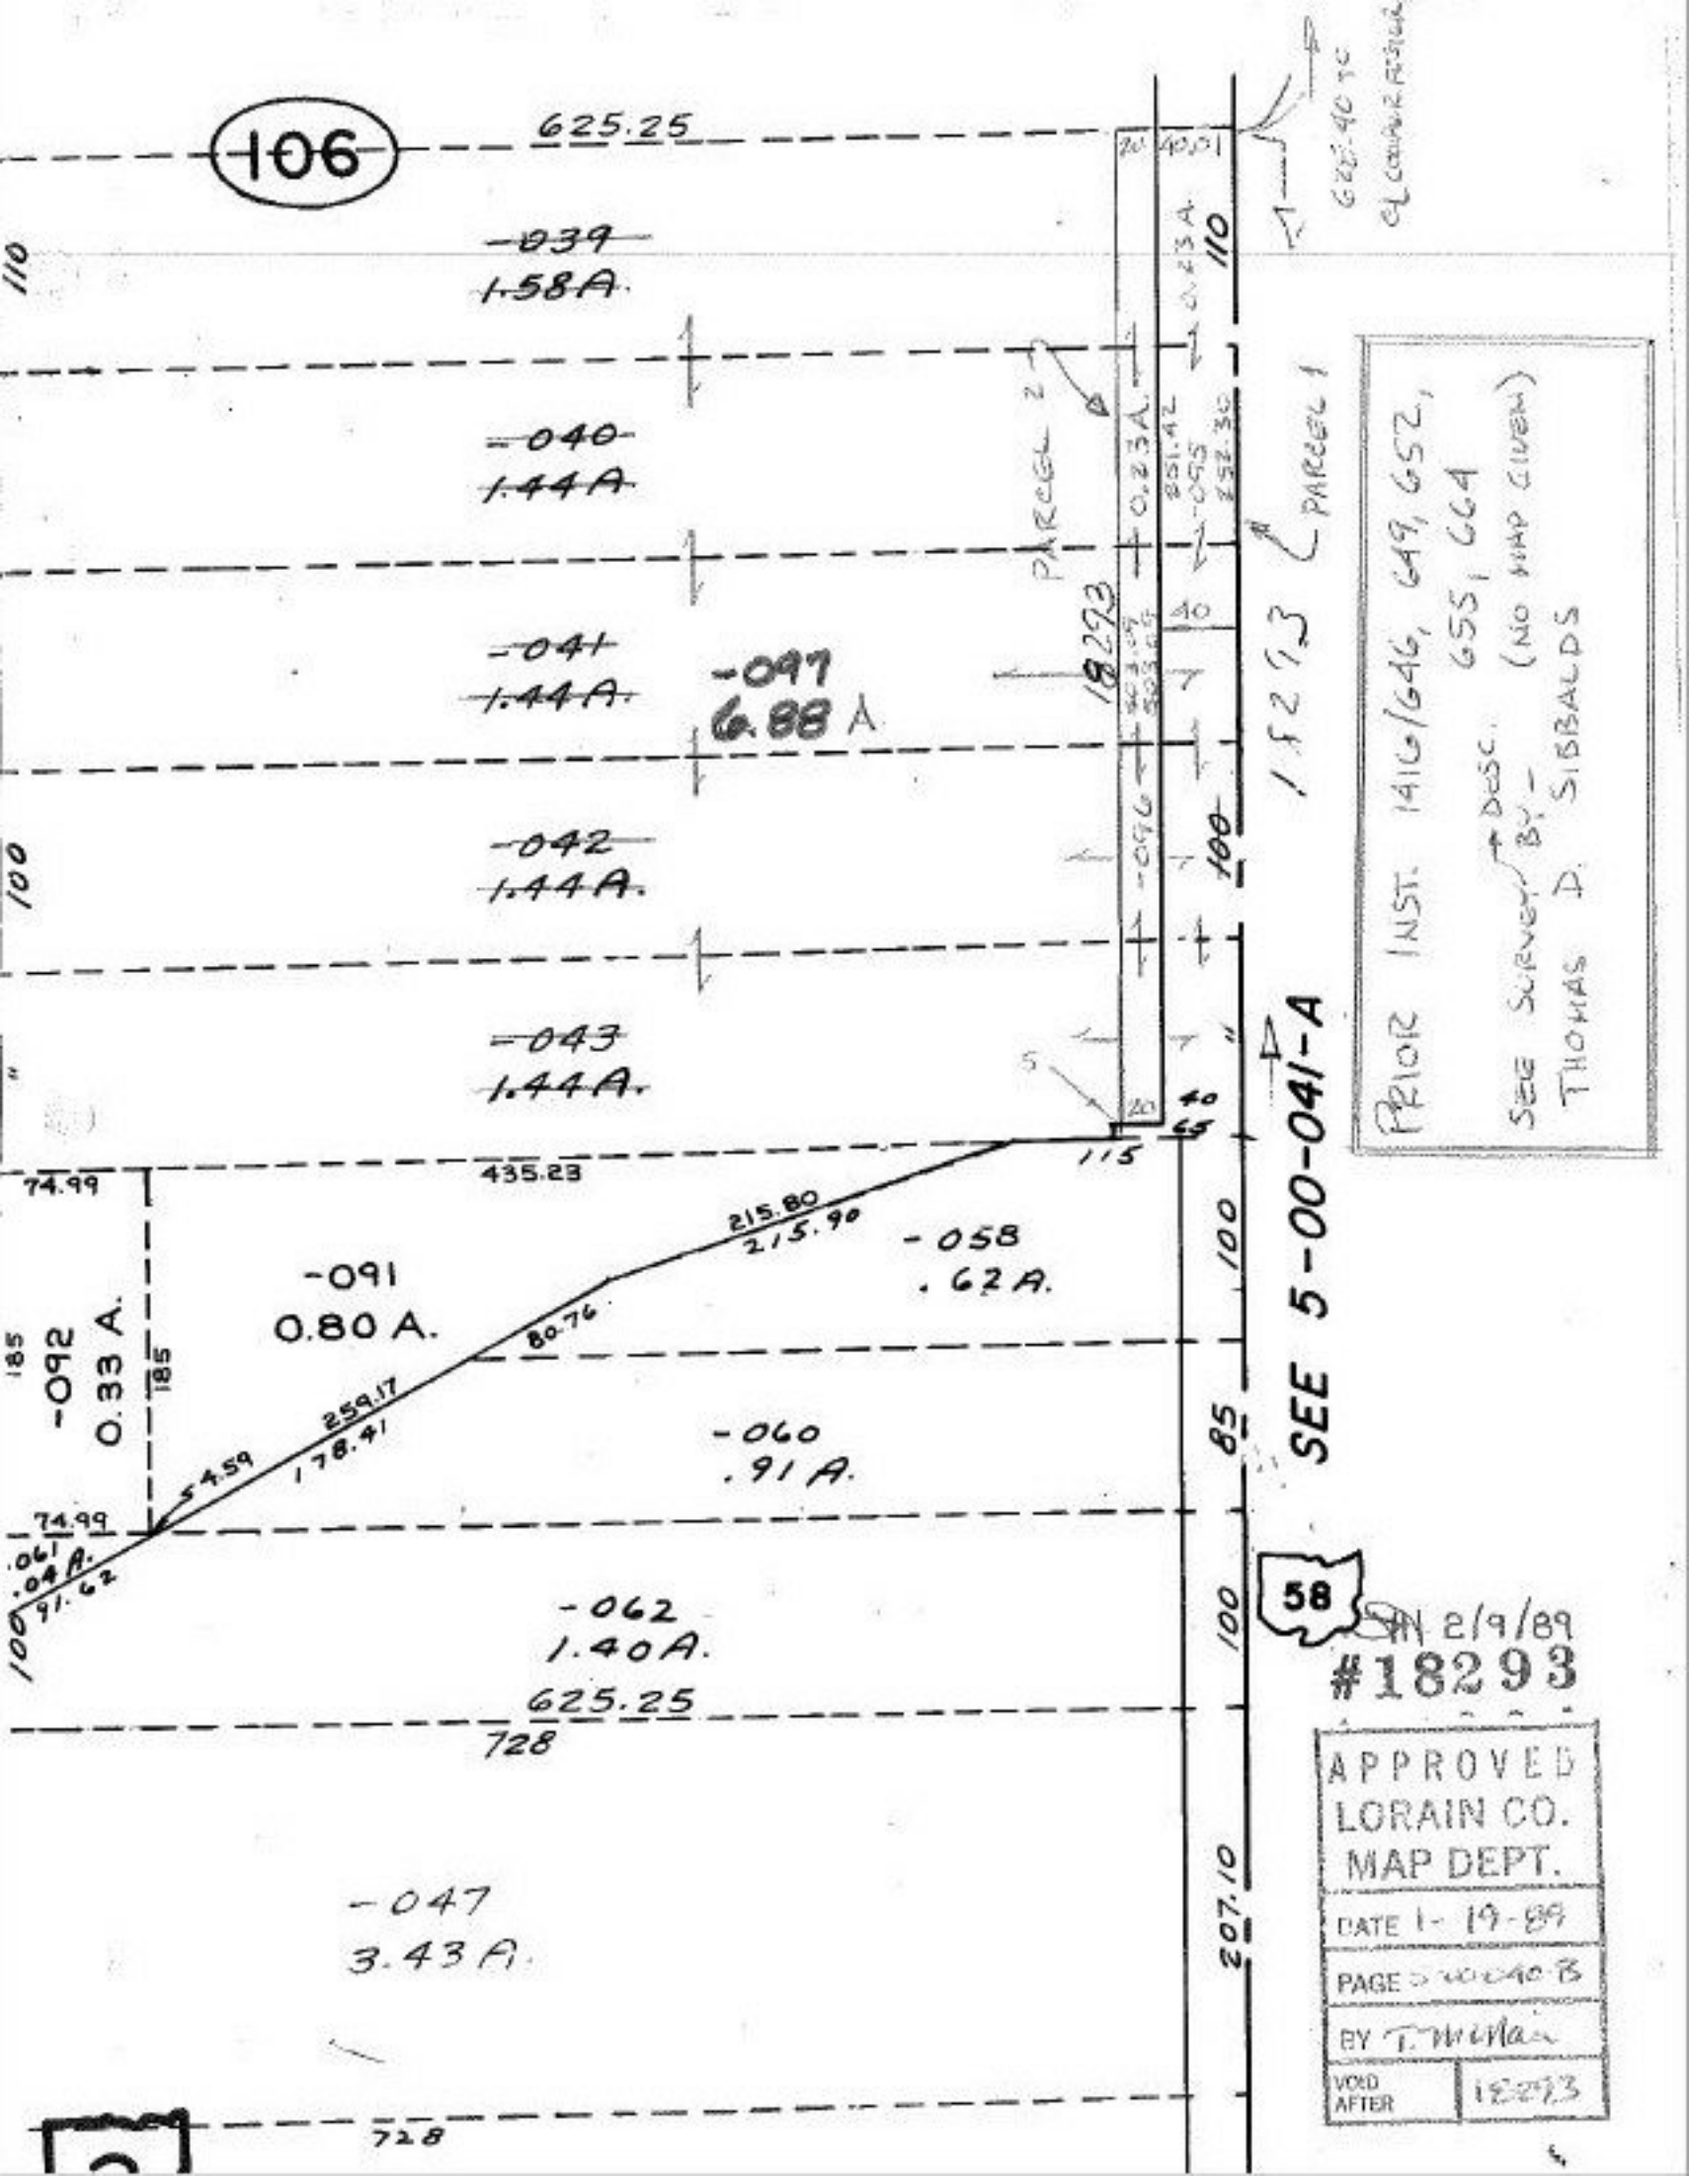
106
625.25
-039
1.58A.
-040
1.44A.
-041
1.44A.
-097
6.88 A
-042
1.44A.
-043
1.44A.
PARCEL 2
PARCEL 1
18293
0.23A.
-096
-095
PRIOR INST. 1416/646, 649, 652, 655, 664
SEE SURVEY BY DESC. (NO MAP GIVEN)
THOMAS D. SIBBALDS
SEE 5-00-041-A
435.23
74.99
-091
0.80 A.
-092
0.33 A.
215.80
215.90
-058
.62 A.
80.76
259.17
178.41
54.59
-060
.91 A.
.061
.04 A.
91.62
-062
1.40A.
625.25
728
-047
3.43 A.
207.10
58
2/9/89
#18293
APPROVED
LORAIN CO.
MAP DEPT.
DATE 1-19-89
PAGE 5-00-040-B
BY T. McMain
VOID AFTER 18293