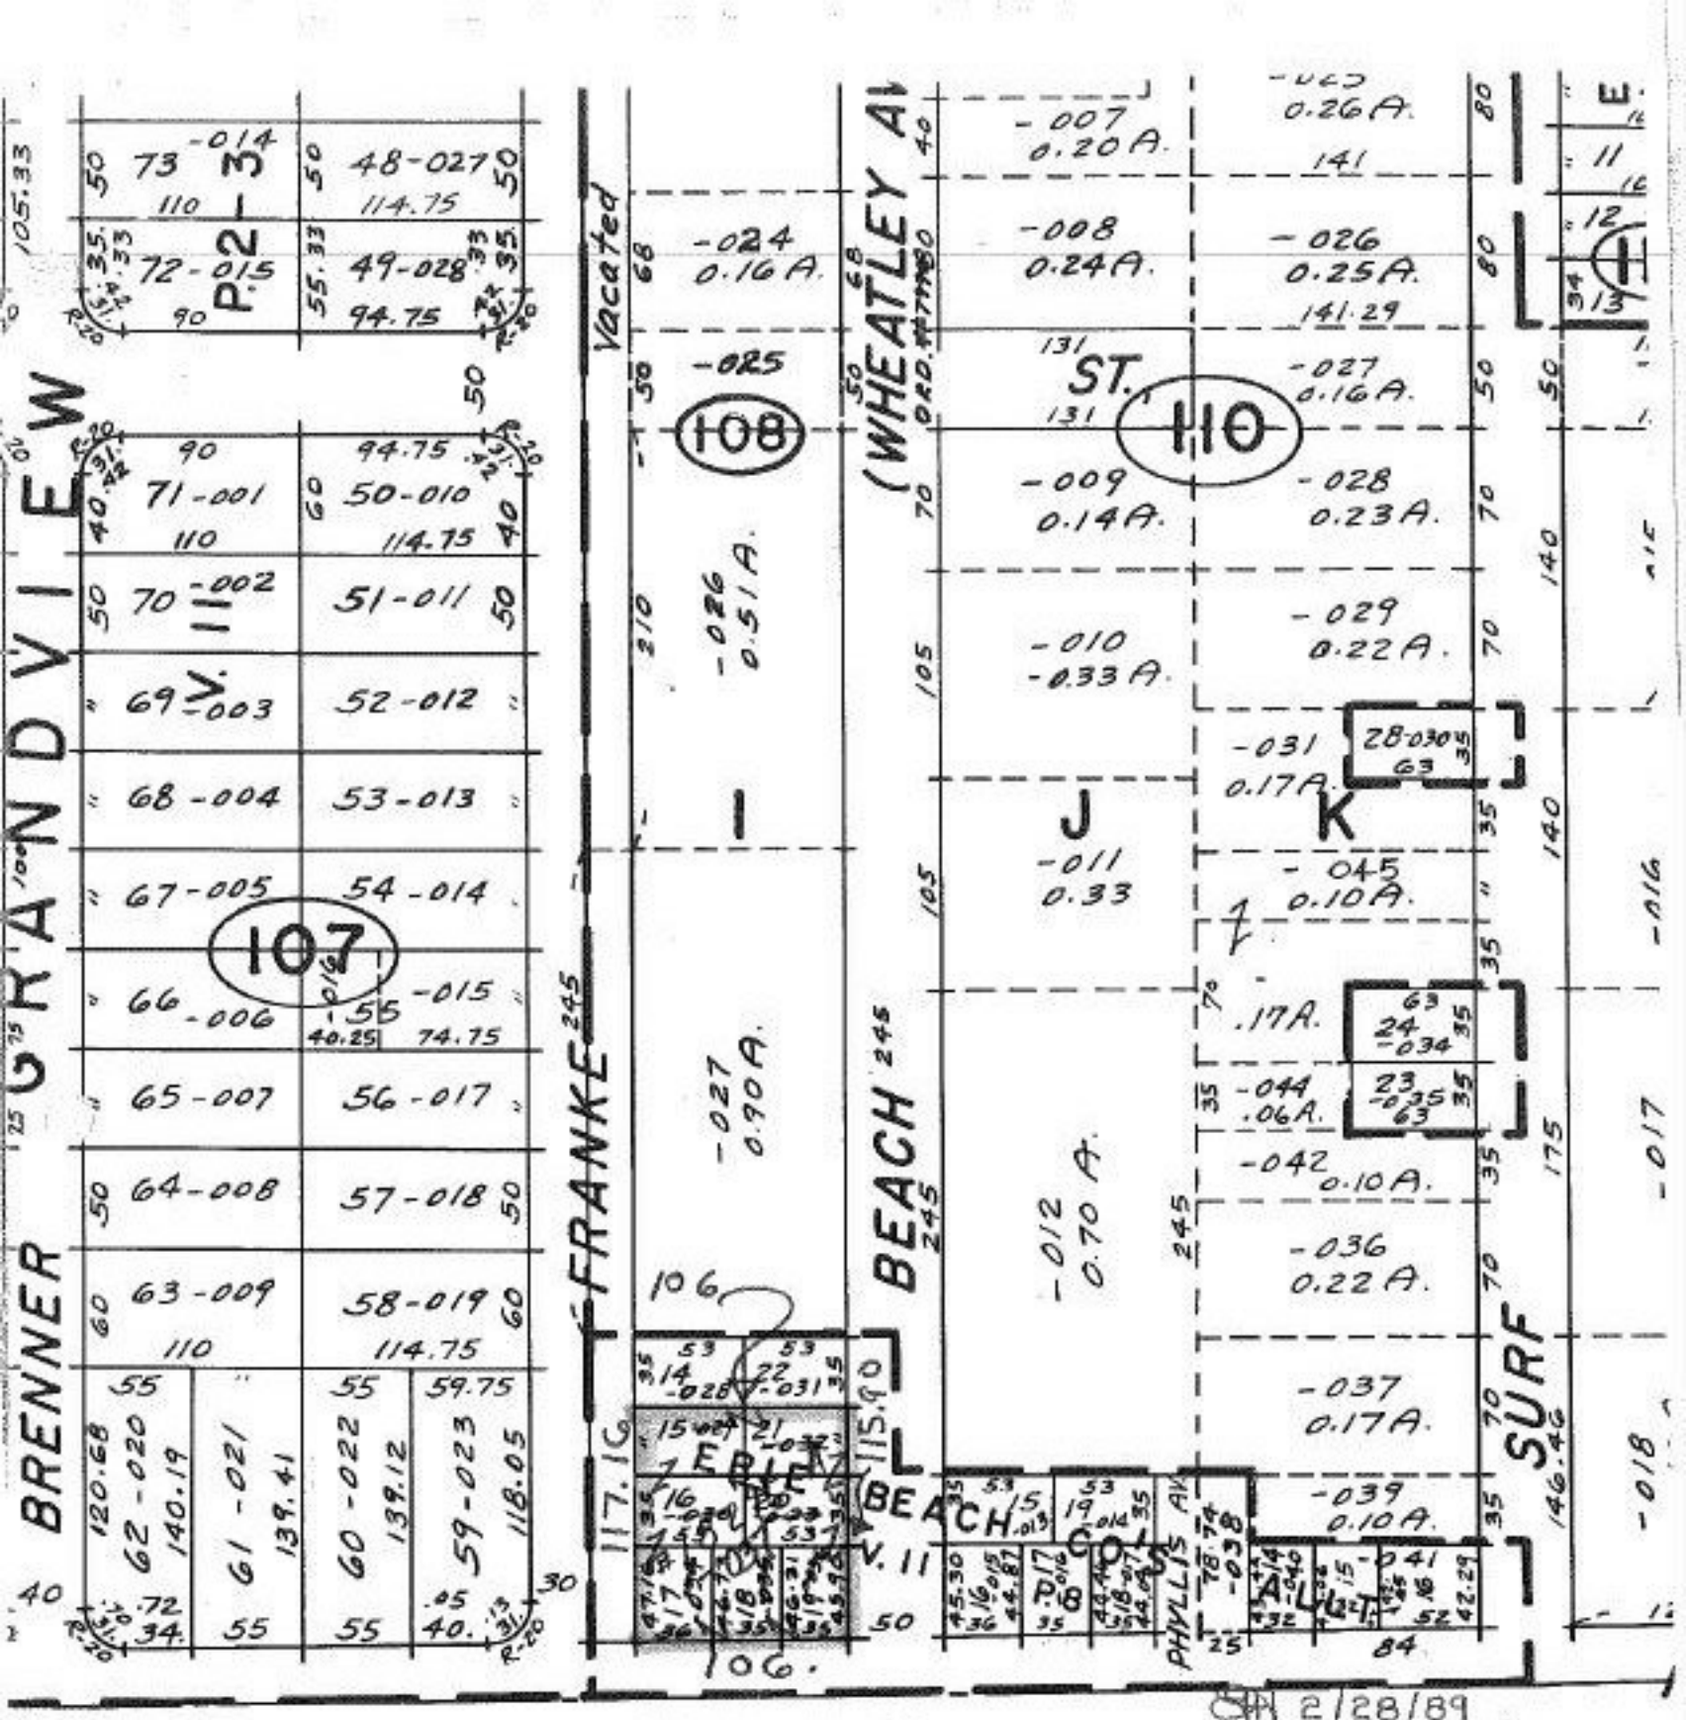

SEE-2-F

COMBINATION

02-02-021-108-~~029,-030~~
-~~032 Thru 036~~

R TWP

CHR 2/28/89
#18295A

APPROVED
LORAIN CO.
MAP DEPT.
DATE 1-25-89
PAGE 2-02-021-A
BY Carl Grandis
VOID AFTER # 18295-A