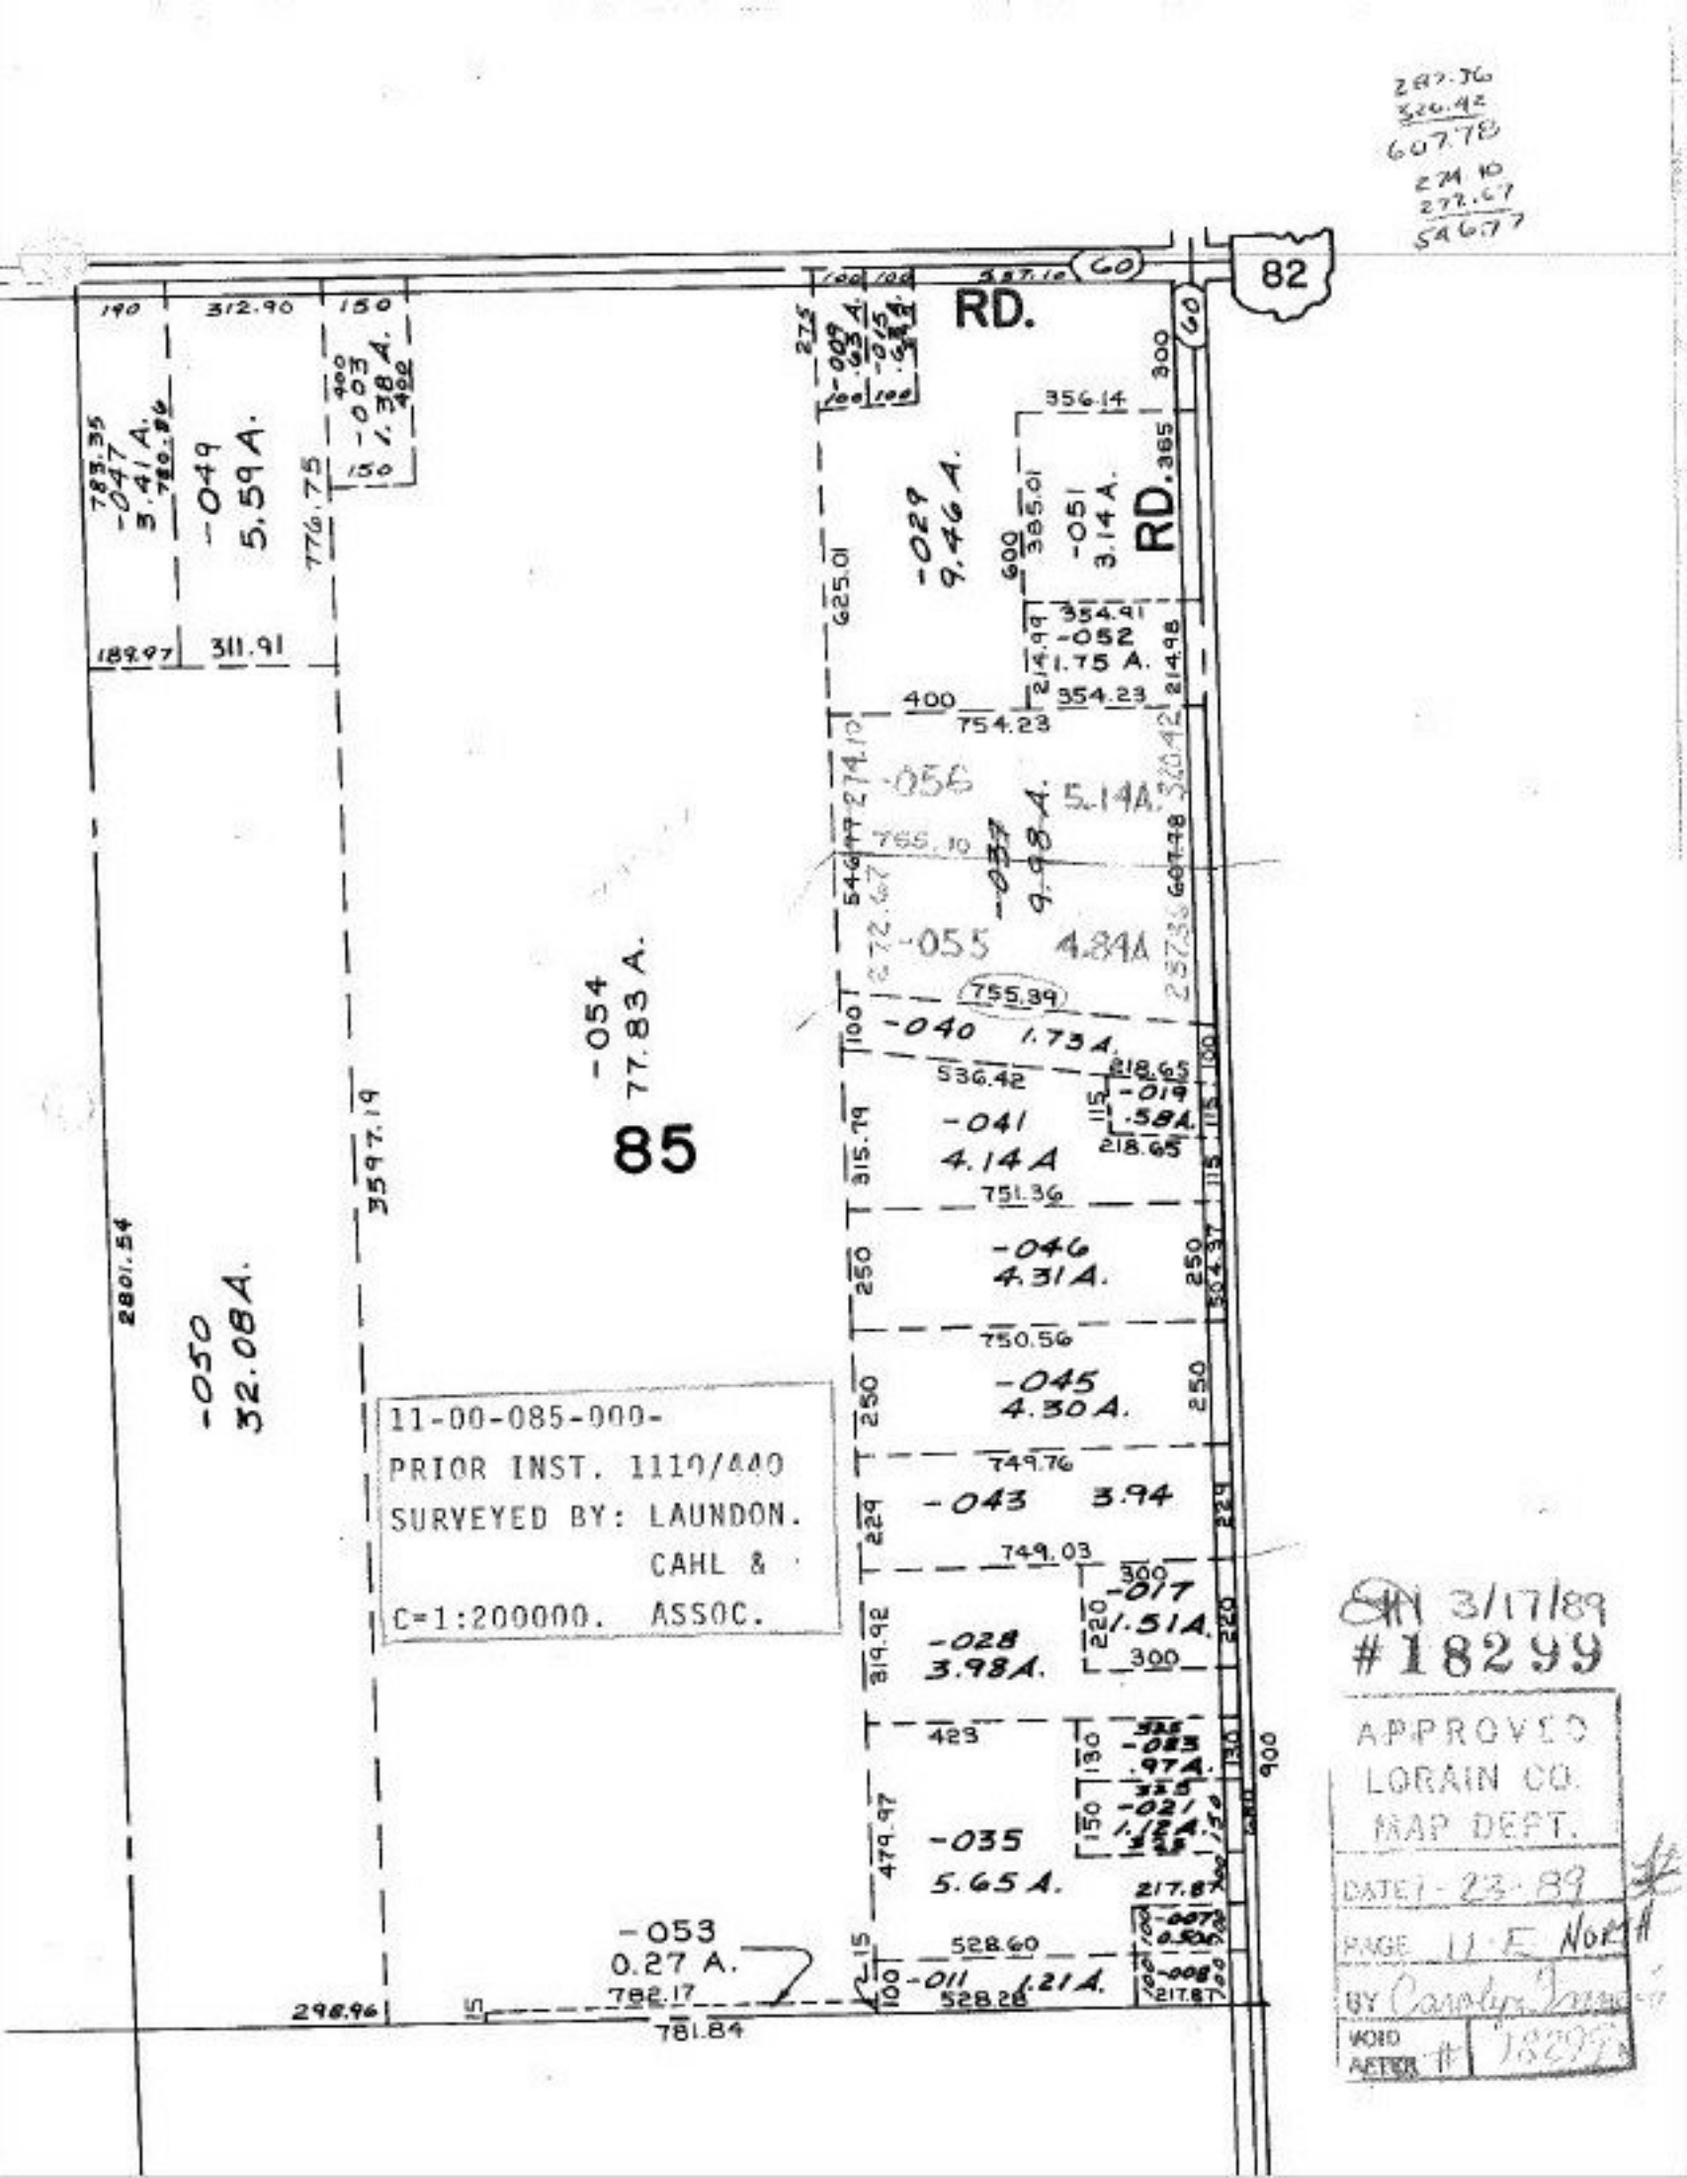
RD.
82
85
-054
77.83 A.
-050
32.08A.
-049
5.59 A.
-047
3.41 A.
-003
1.38 A.
-029
9.46 A.
-051
3.14 A.
-052
1.75 A.
-056
5.14A
-039
9.98 A.
-055
4.84A
-040
1.73A.
-019
.58A.
-041
4.14A
-046
4.31A.
-045
4.30A.
-043
3.94
-017
1.51A.
-028
3.98A.
-035
5.65 A.
-053
0.27 A.
-011
1.21A.
11-00-085-000-
PRIOR INST. 1110/440
SURVEYED BY: LAUNDON. CAHL & ASSOC.
C=1:200000.
3/17/89
#18299
APPROVED
LORAIN CO.
MAP DEPT.
DATE 1-23-89
PAGE 11-E North
BY Carolyn Jones
VOID AFTER # 18299