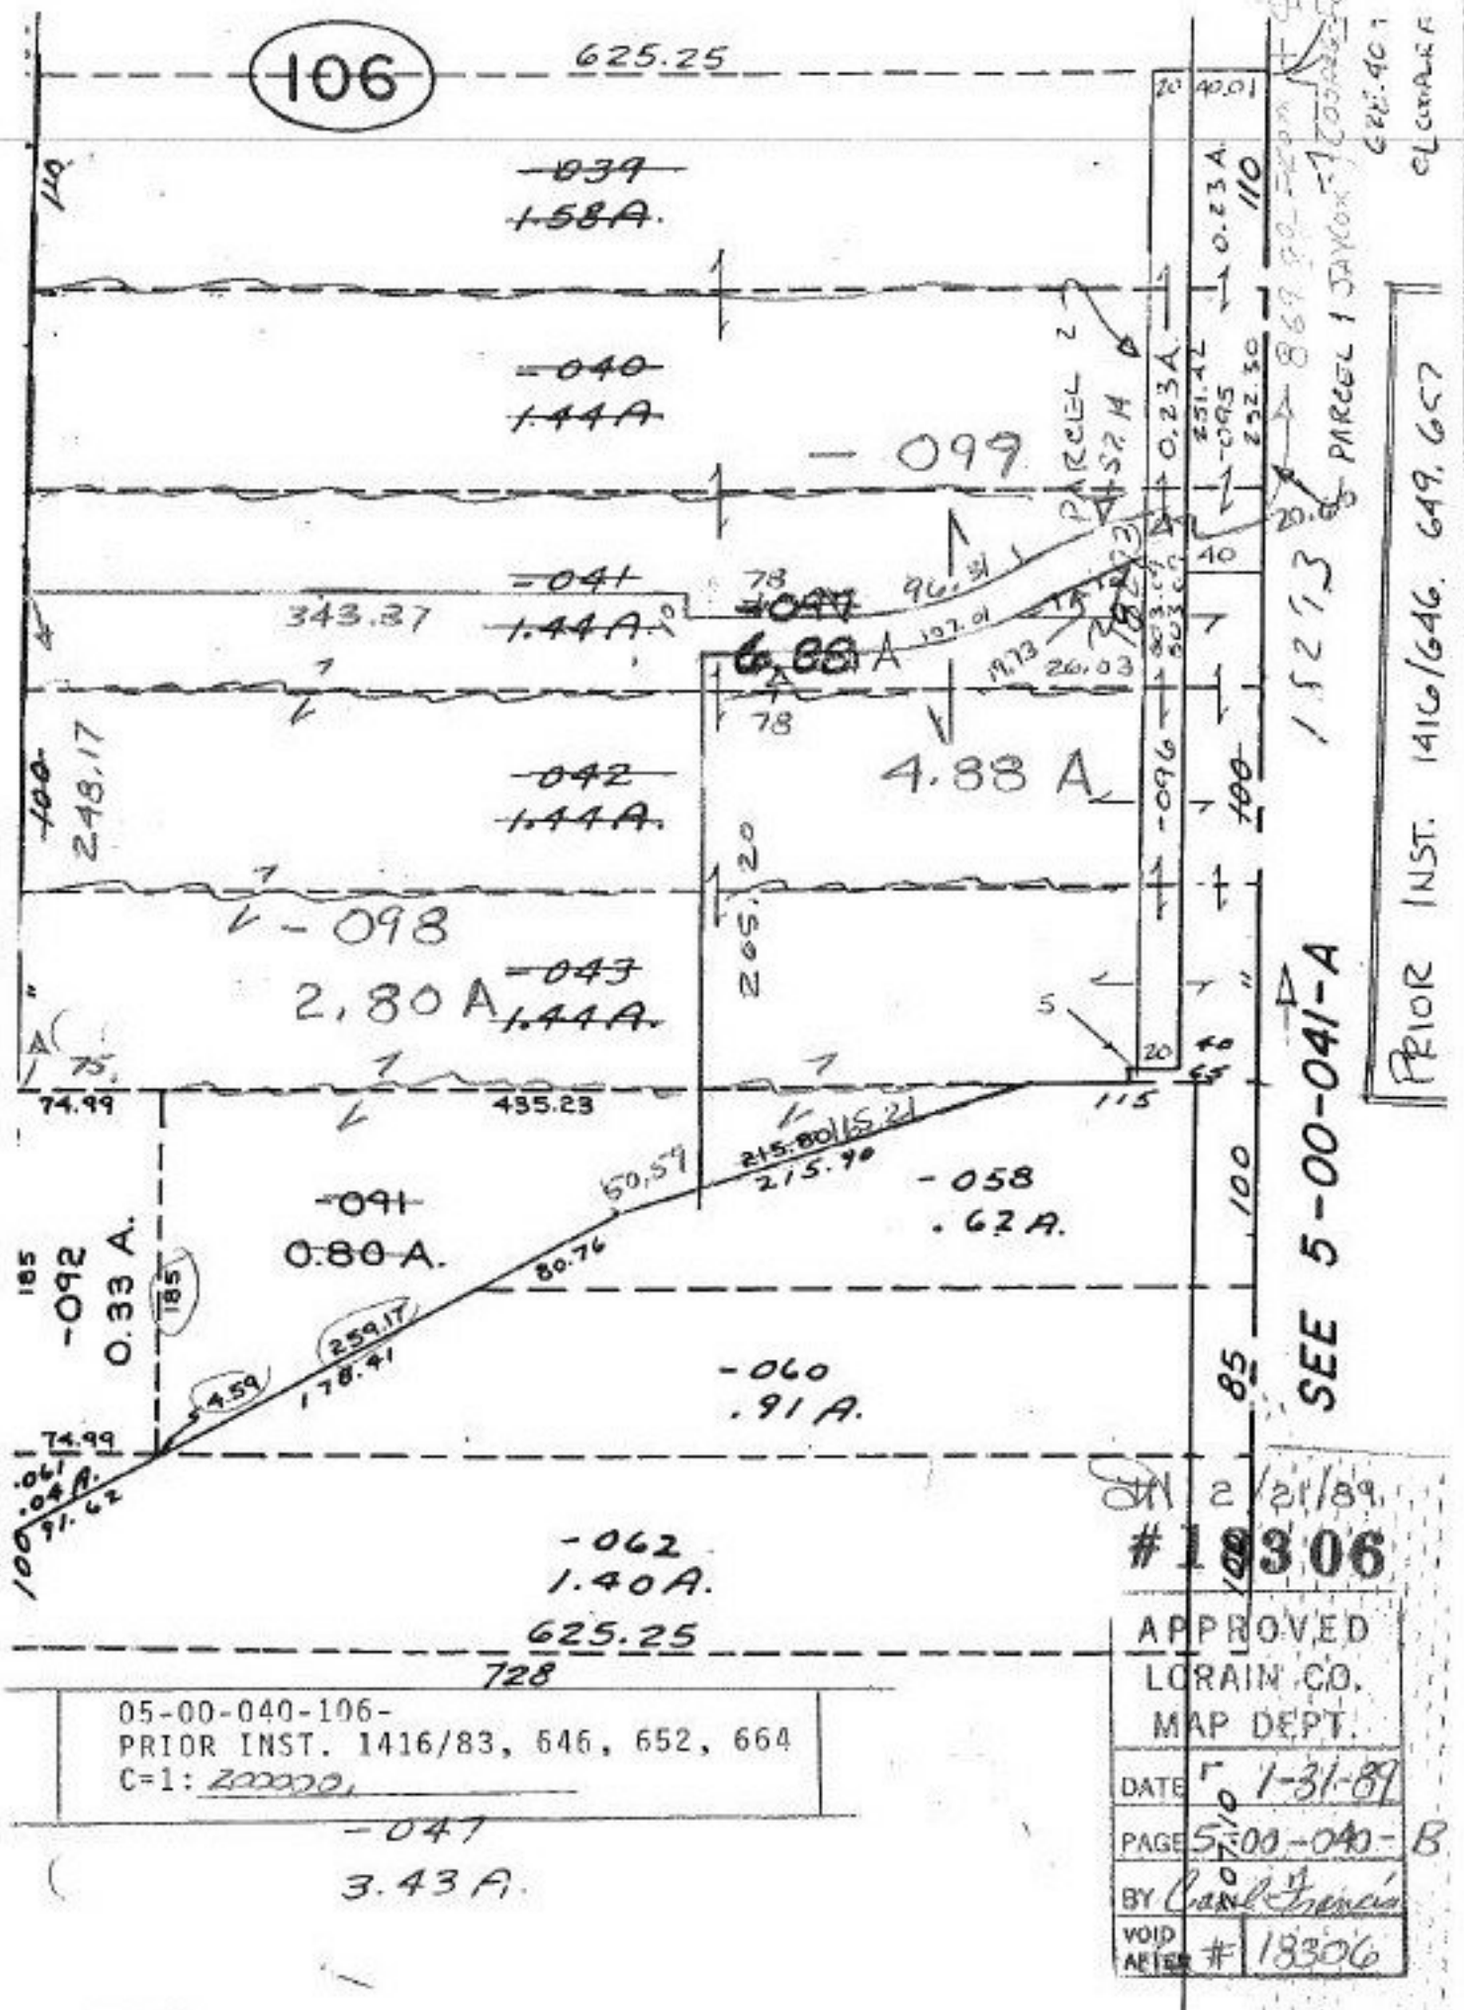

05-00-040-106-
PRIOR INST. 1416/83, 646, 652, 664
C=1: 200000.