2.0000
- .1549
1.8451
- .6676
1.1775
- .4634
0.7141

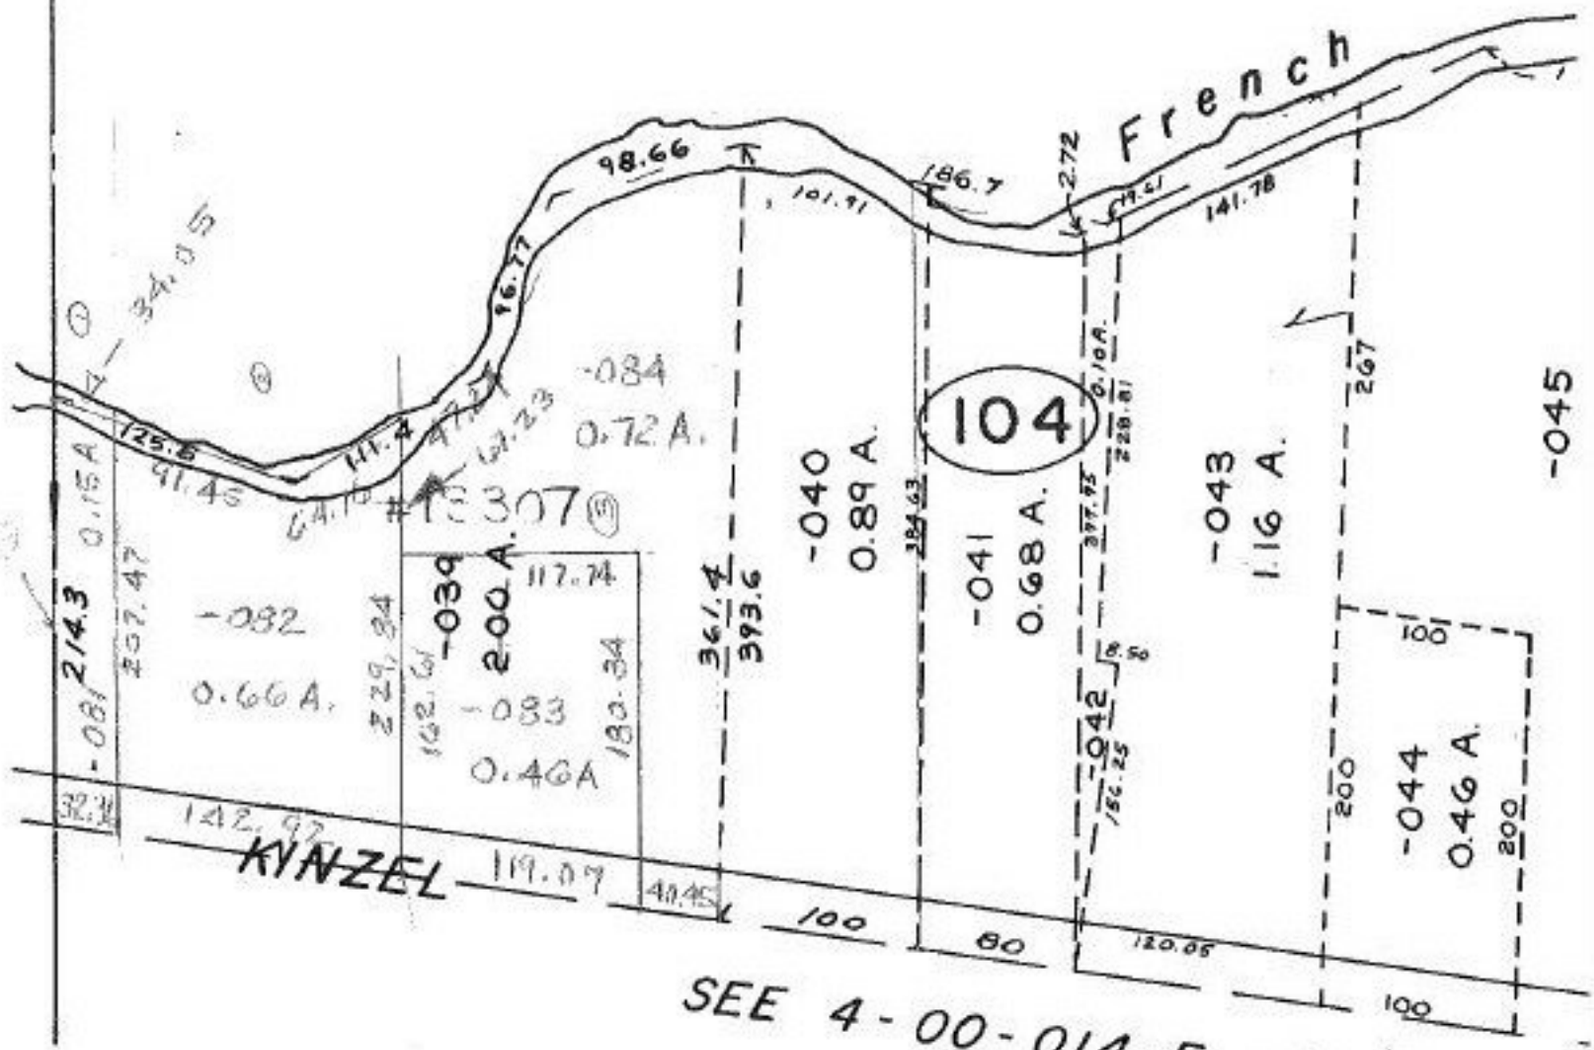

6/15/89
#18307

04-00-014-104-
PRIOR INST. O.R. 75/335
SURVEYED BY: MARTINI & ASSOC.
(1)C=1: 43478
(2)C=1: 200000.
(3)C=1: 166666.

APPROVED
LORAIN CO.
MAP DEPT.
DATE 2-1-89
PAGE 4-00-014- A
BY Carolyn Jaspers
VOID AFTER # 18307