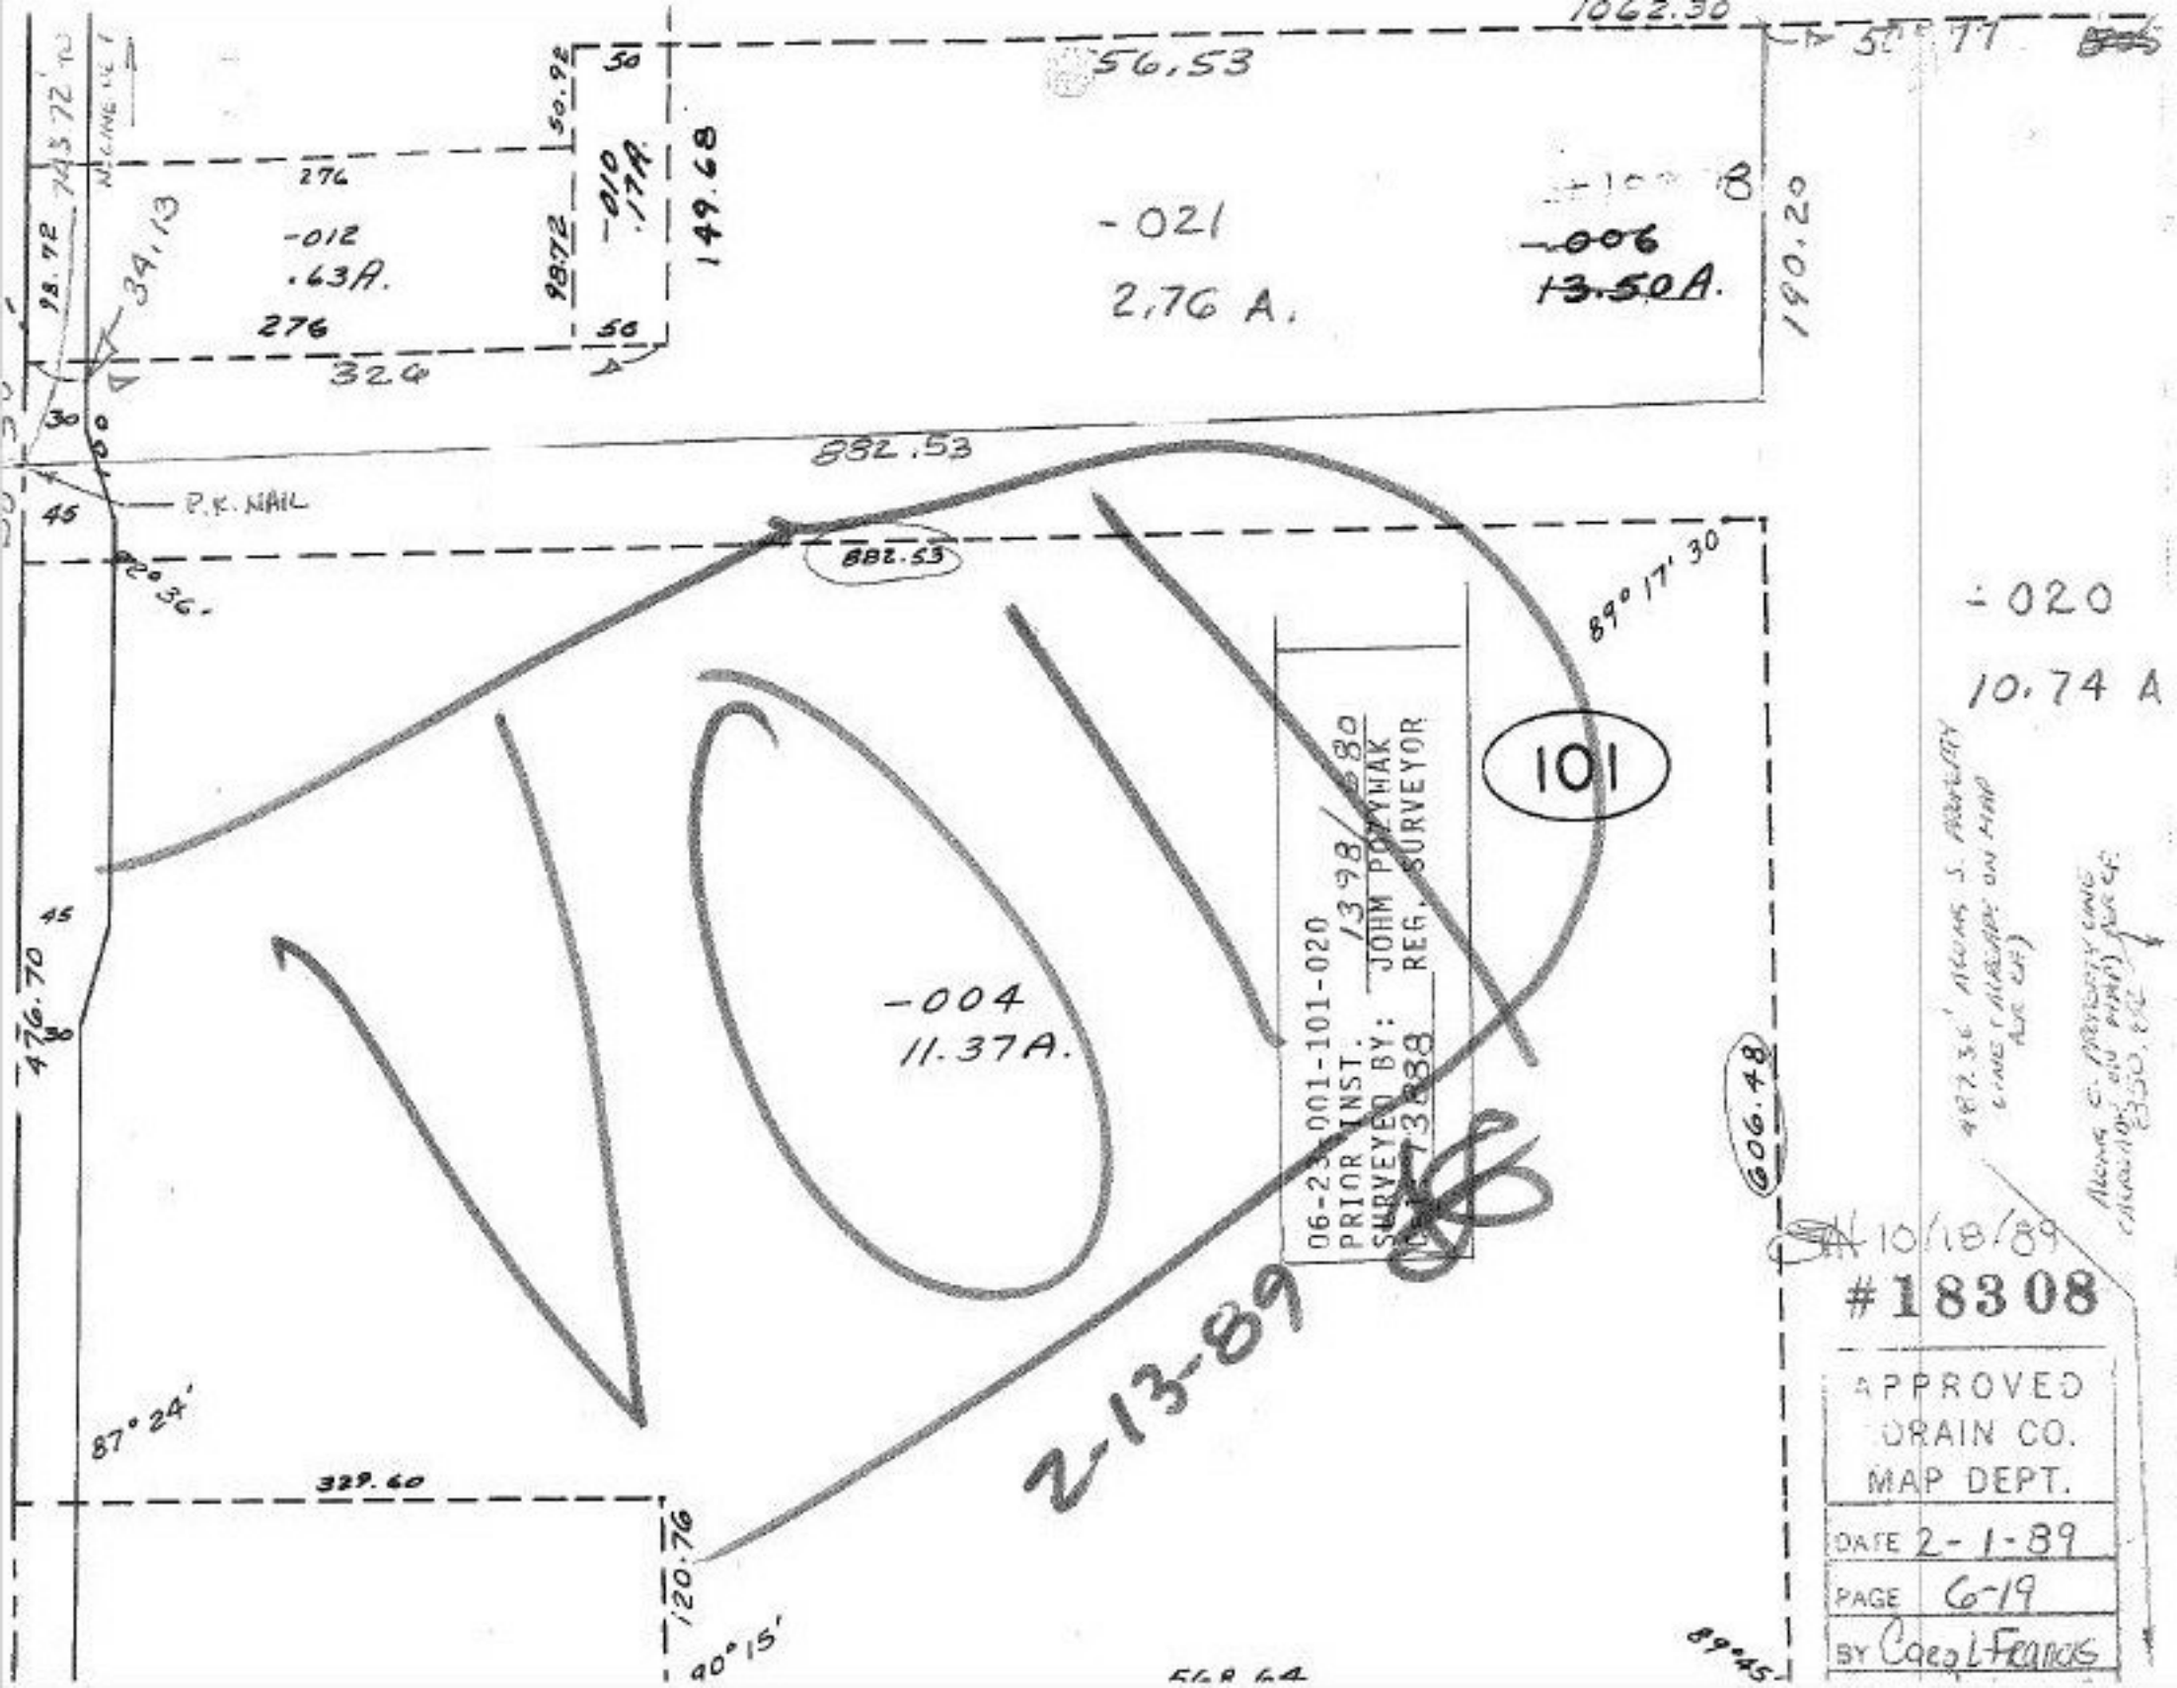

1062.30
56.53
50.92
50
276
-012
.63A.
276
324
98.72
-010
.17A.
149.68
-021
2.76 A.
-006
13.50A.
190.20
882.53
882.53
P.K. NAIL
45
30
45
30
476.70
89° 17' 30
-020
10.74 A
101
-004
11.37A.
606.48
87° 24'
329.60
120.76
90° 15'
568.64
89° 45'
VOID
2-13-89
06-23-001-101-020
PRIOR INST. 1398/680
SURVEYED BY: JOHN POLYWAK
REG. SURVEYOR
10/18/89
#18308
APPROVED
DRAIN CO.
MAP DEPT.
DATE 2-1-89
PAGE 6-19
BY Carol Francis