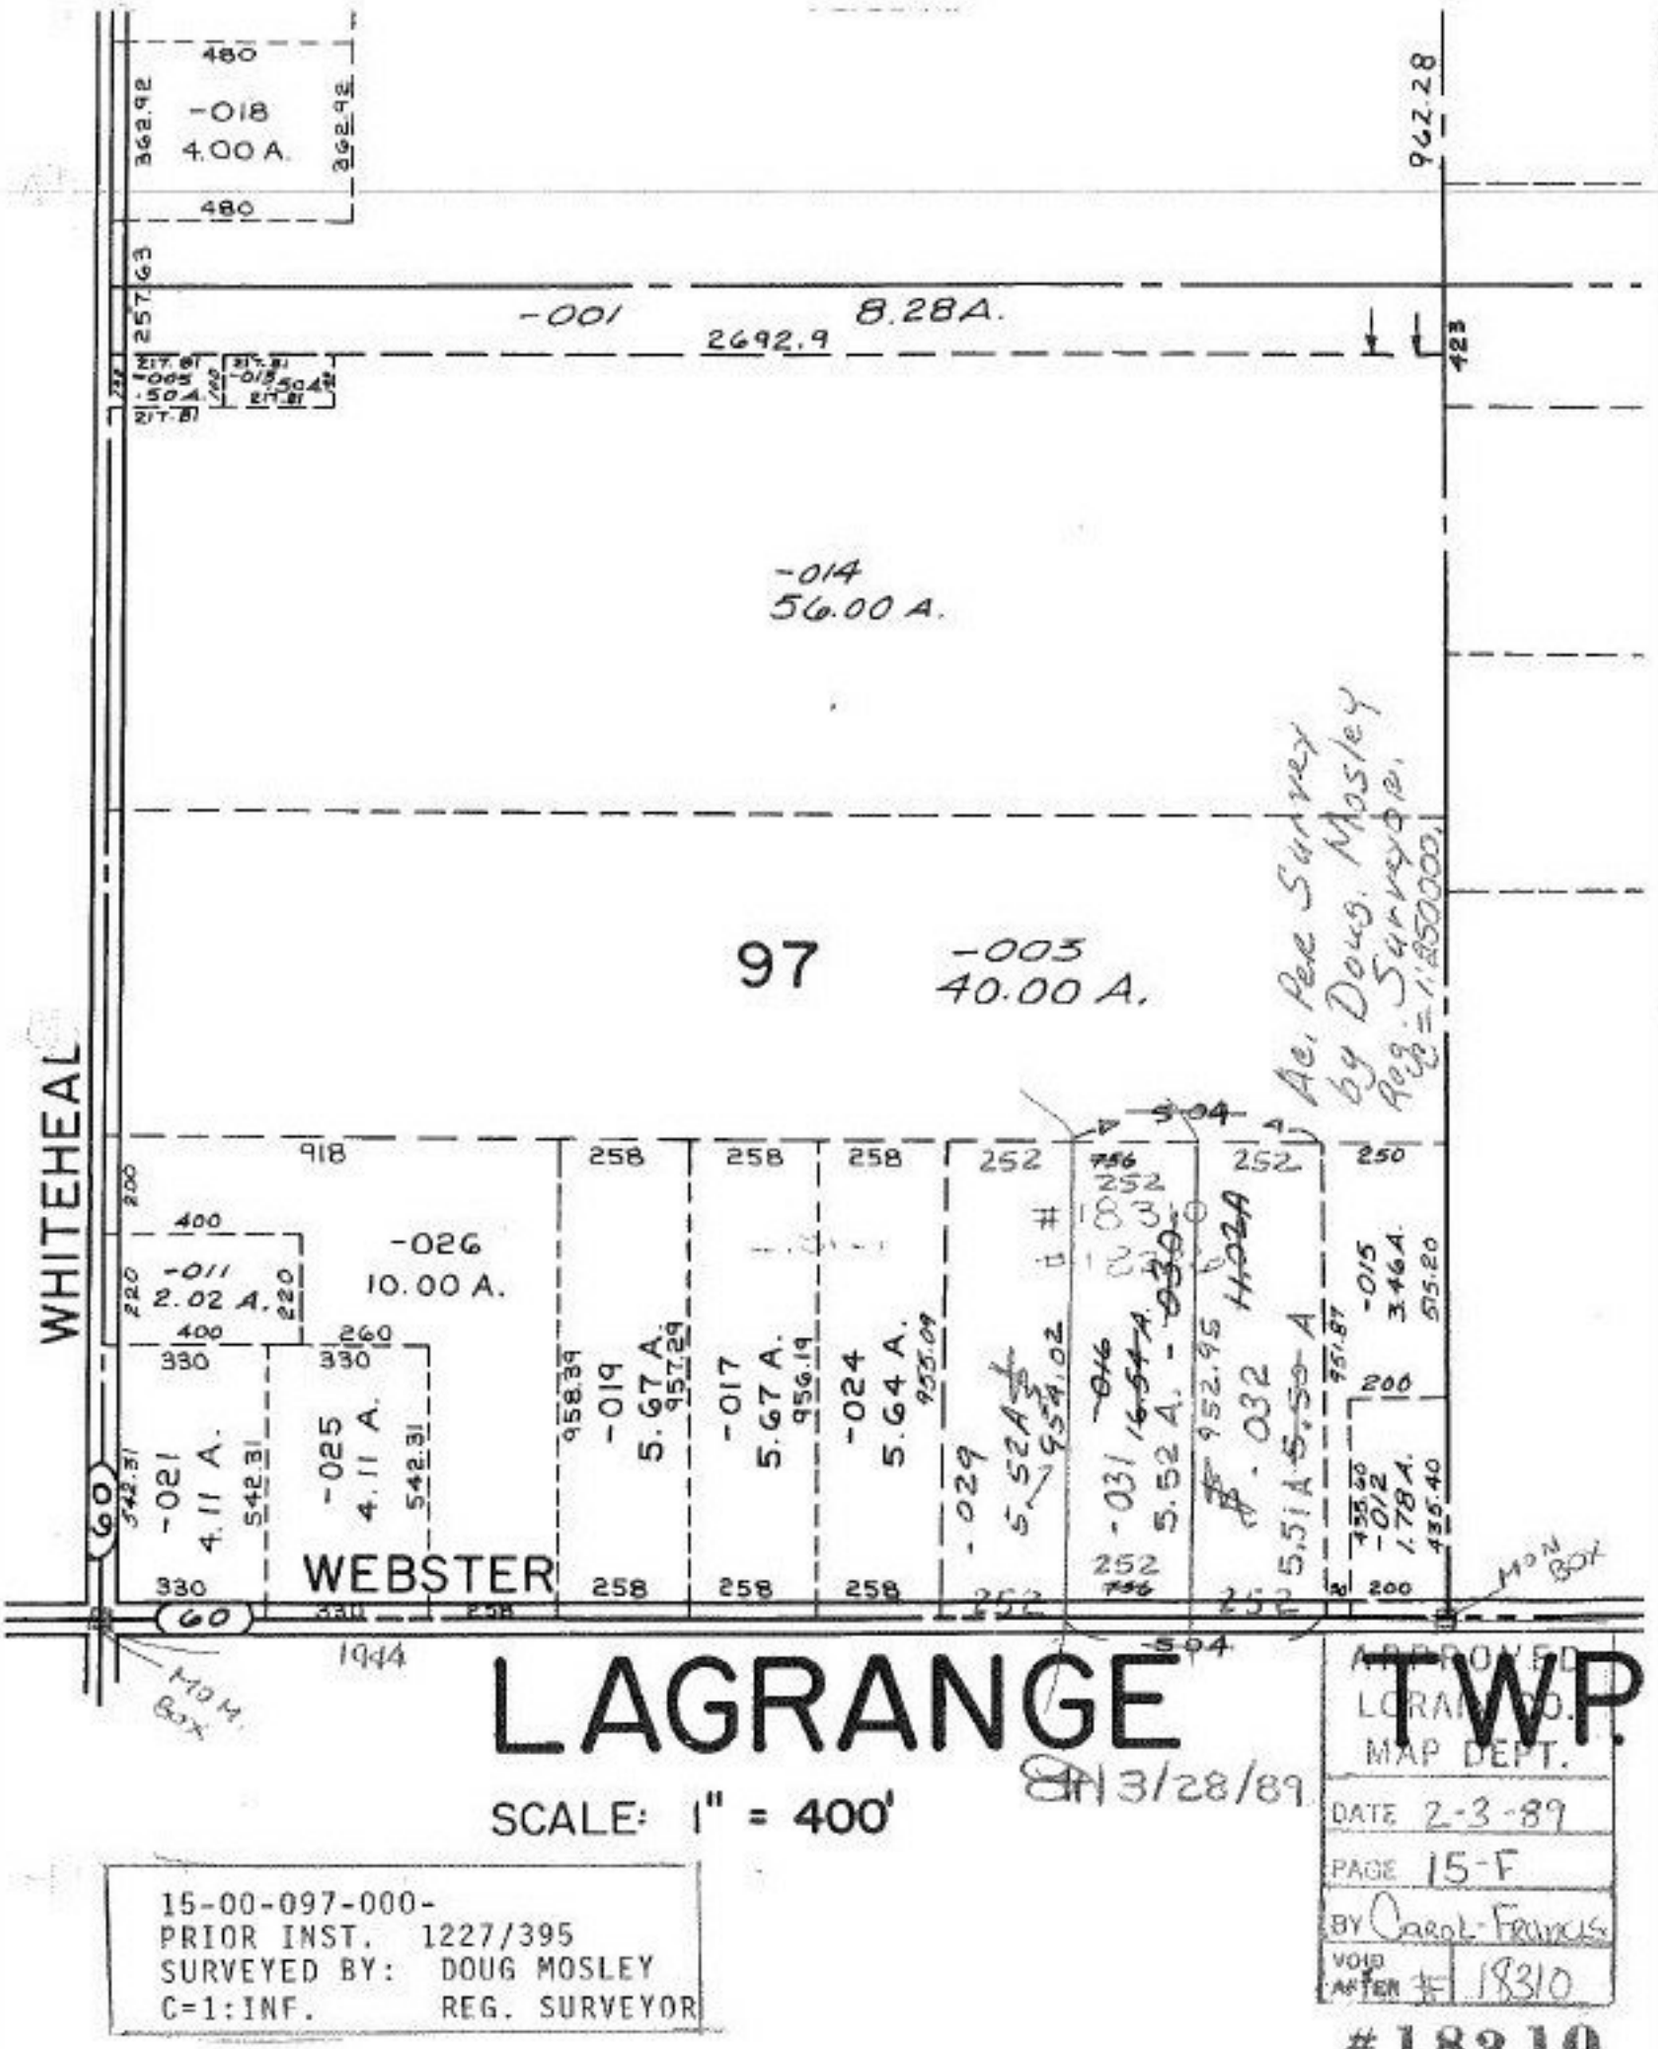

LAGRANGE TWP.

SCALE: 1" = 400'

3/28/89

15-00-097-000-
PRIOR INST. 1227/395
SURVEYED BY: DOUG MOSLEY
C=1:INF. REG. SURVEYOR

APPROVED
LORAIN CO.
MAP DEPT.
DATE 2-3-89
PAGE 15-F
BY Carol-Frances
VOID AFTER #: 18310

#18310