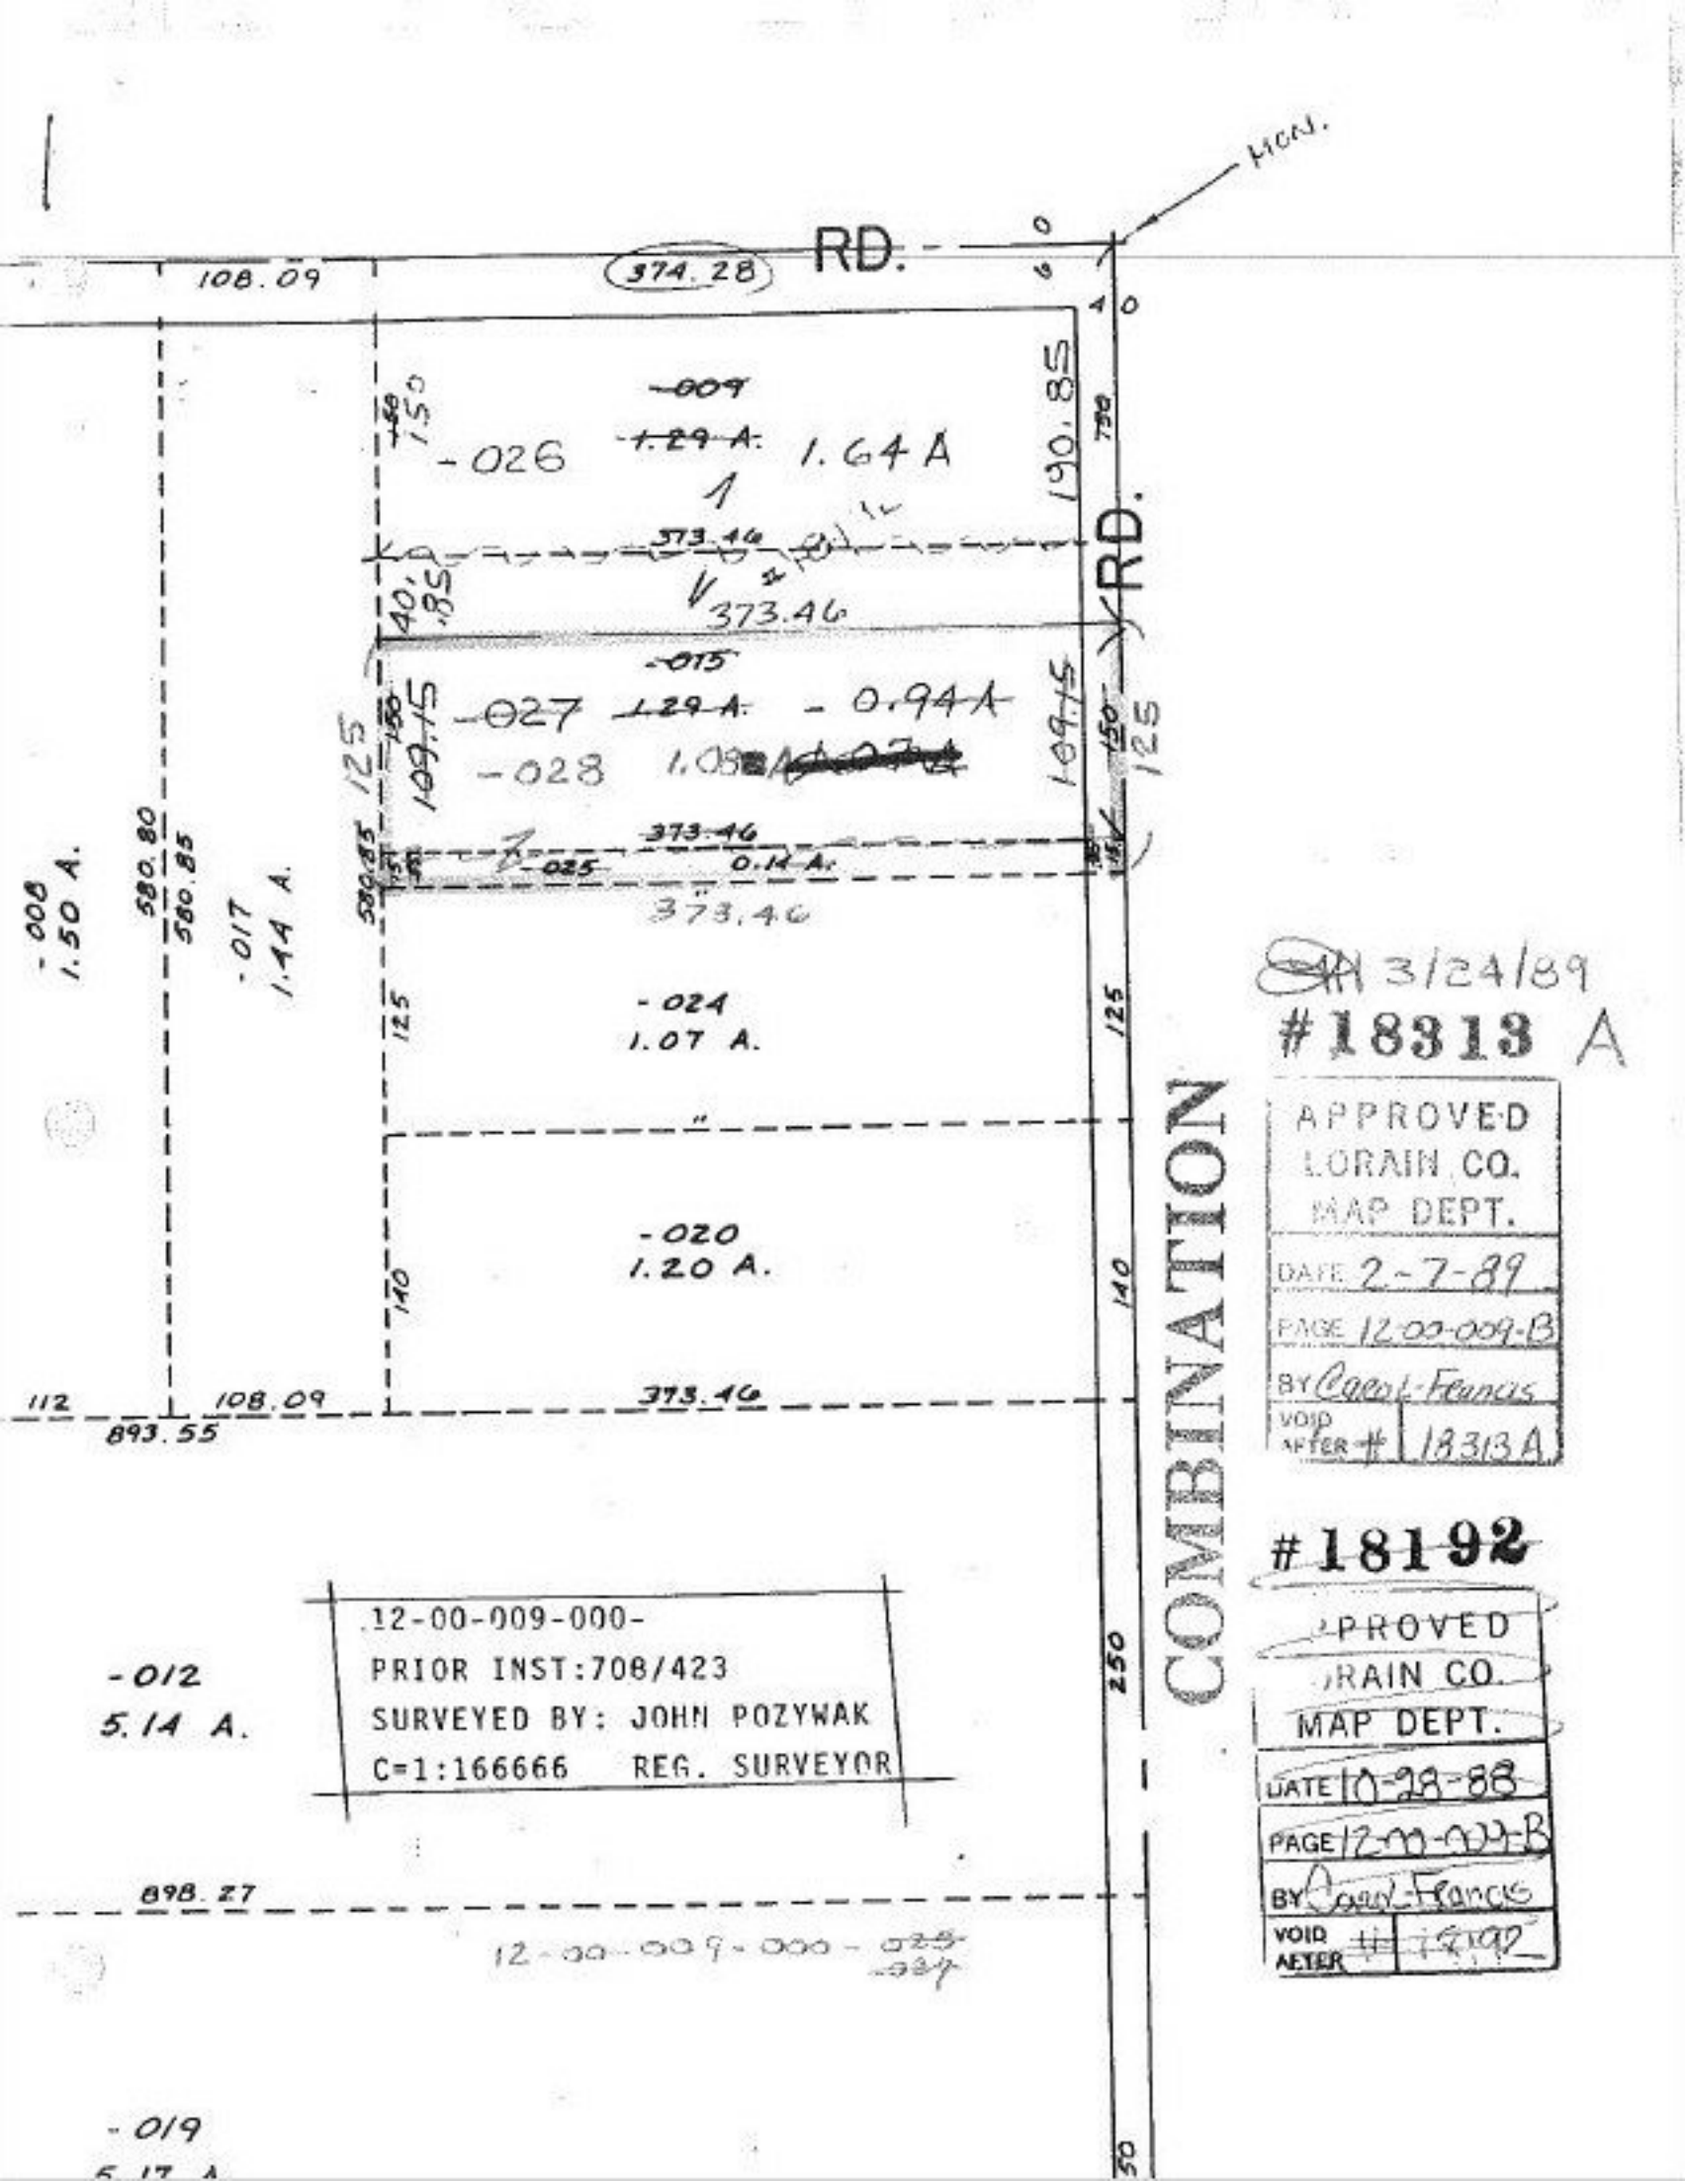

3/24/89

#18313 A

APPROVED
LORAIN CO.
MAP DEPT.
DATE 2-7-89
PAGE 12-00-009-B
BY Carol Francis
VOID AFTER # 18313A

#18192

APPROVED
LORAIN CO.
MAP DEPT.
DATE 10-28-88
PAGE 12-00-009-B
BY Carol Francis
VOID AFTER # 18192