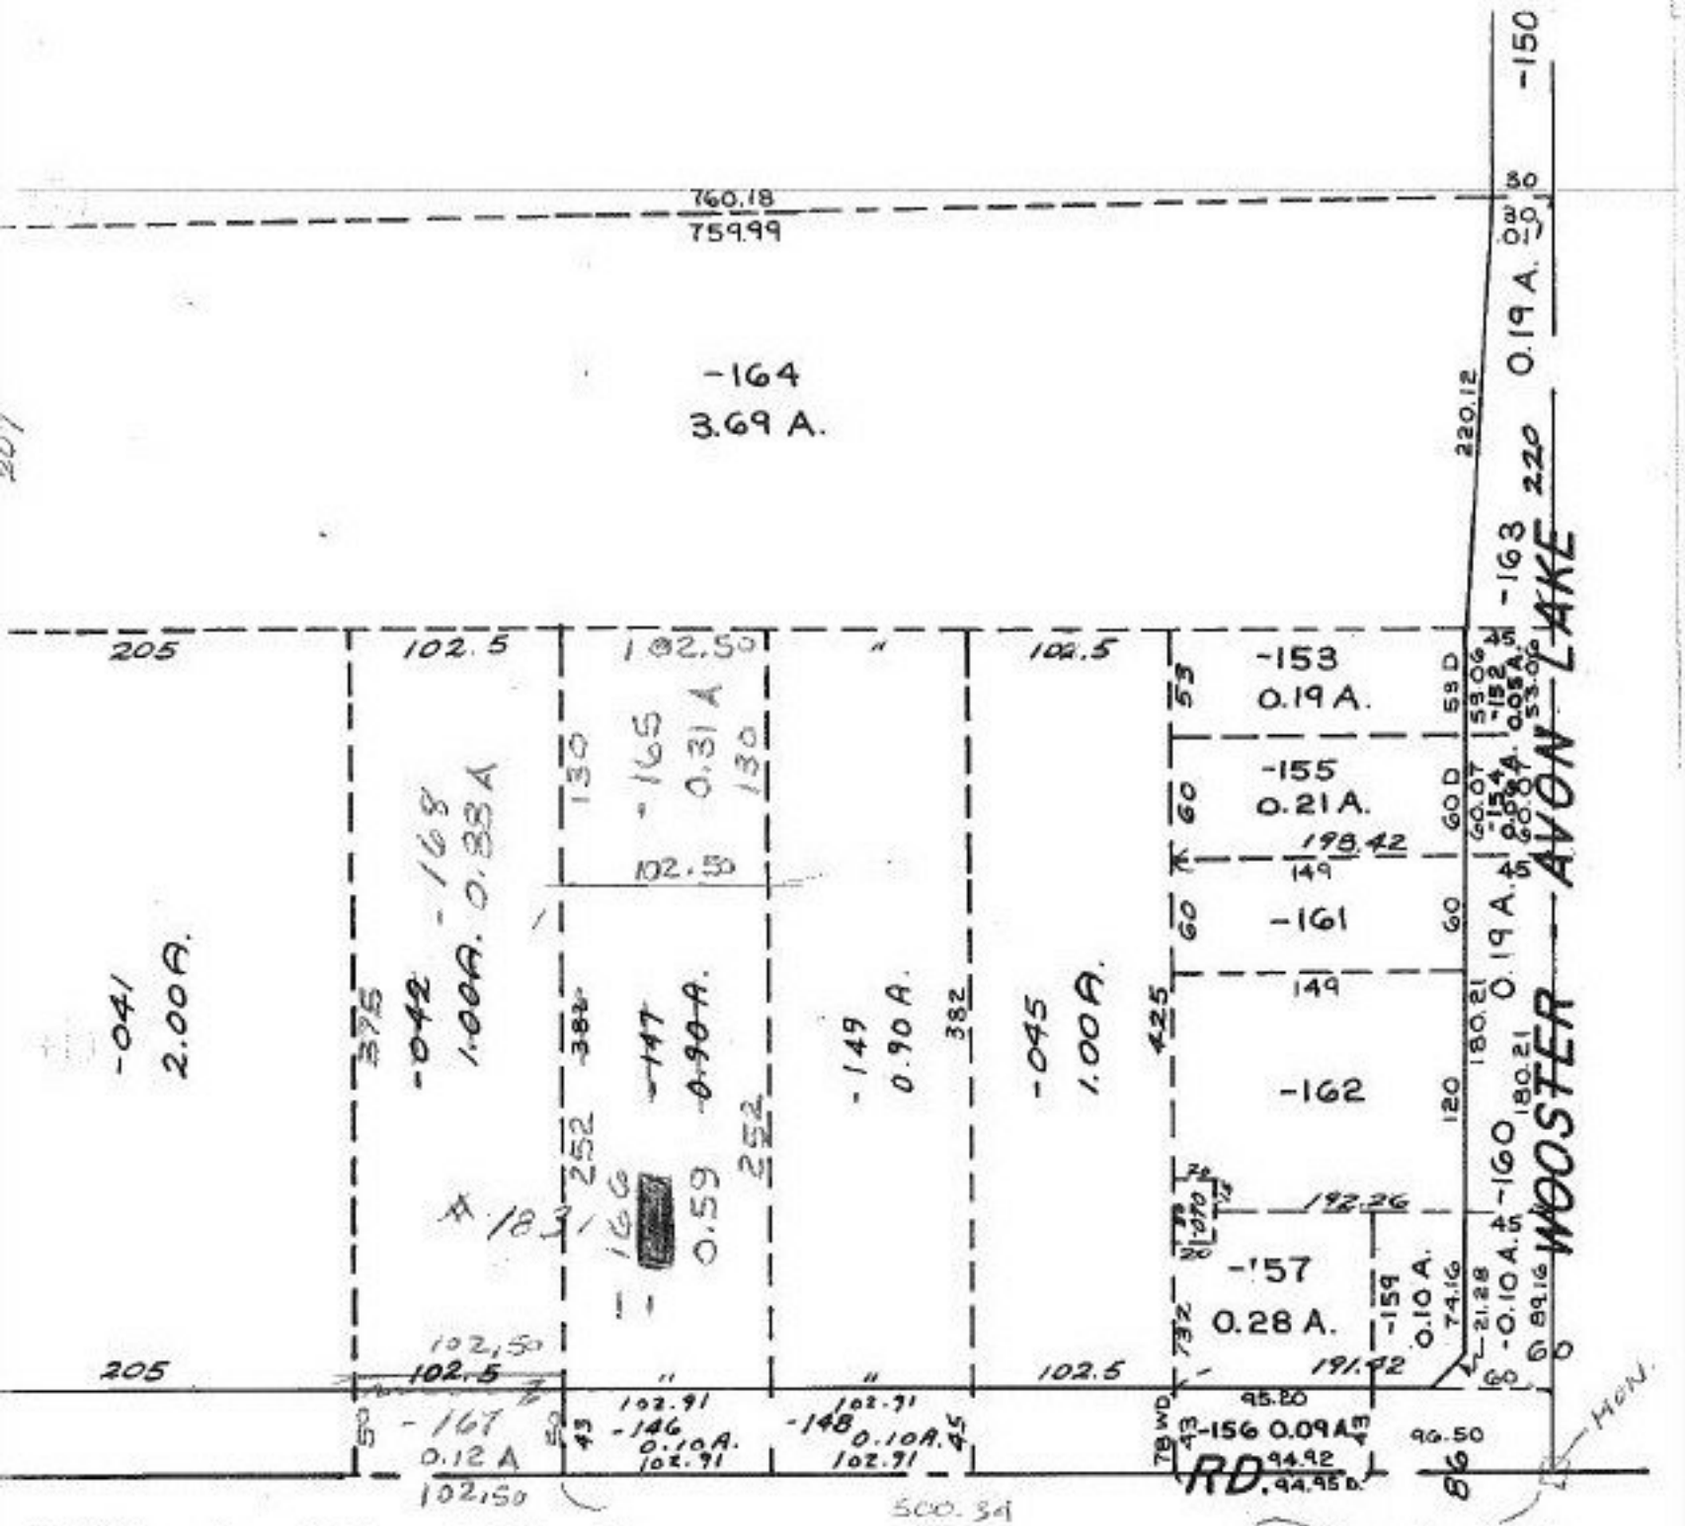

SEE 4 - 00 - 017 - B

6/15/89

#18315

APPROVED
LORAIN CO.
MAP DEPT
DATE 2-7-89
PAGE 4-00-018J
BY CAROL FRANCE
VOID AFTER # 18315

CITY

E 1/2 W 1/2 SLY 1/3 SEC

04-00-018-128-
PRIOR INST. 1045/356
SURVEYED BY: K S A
C=1: INF.