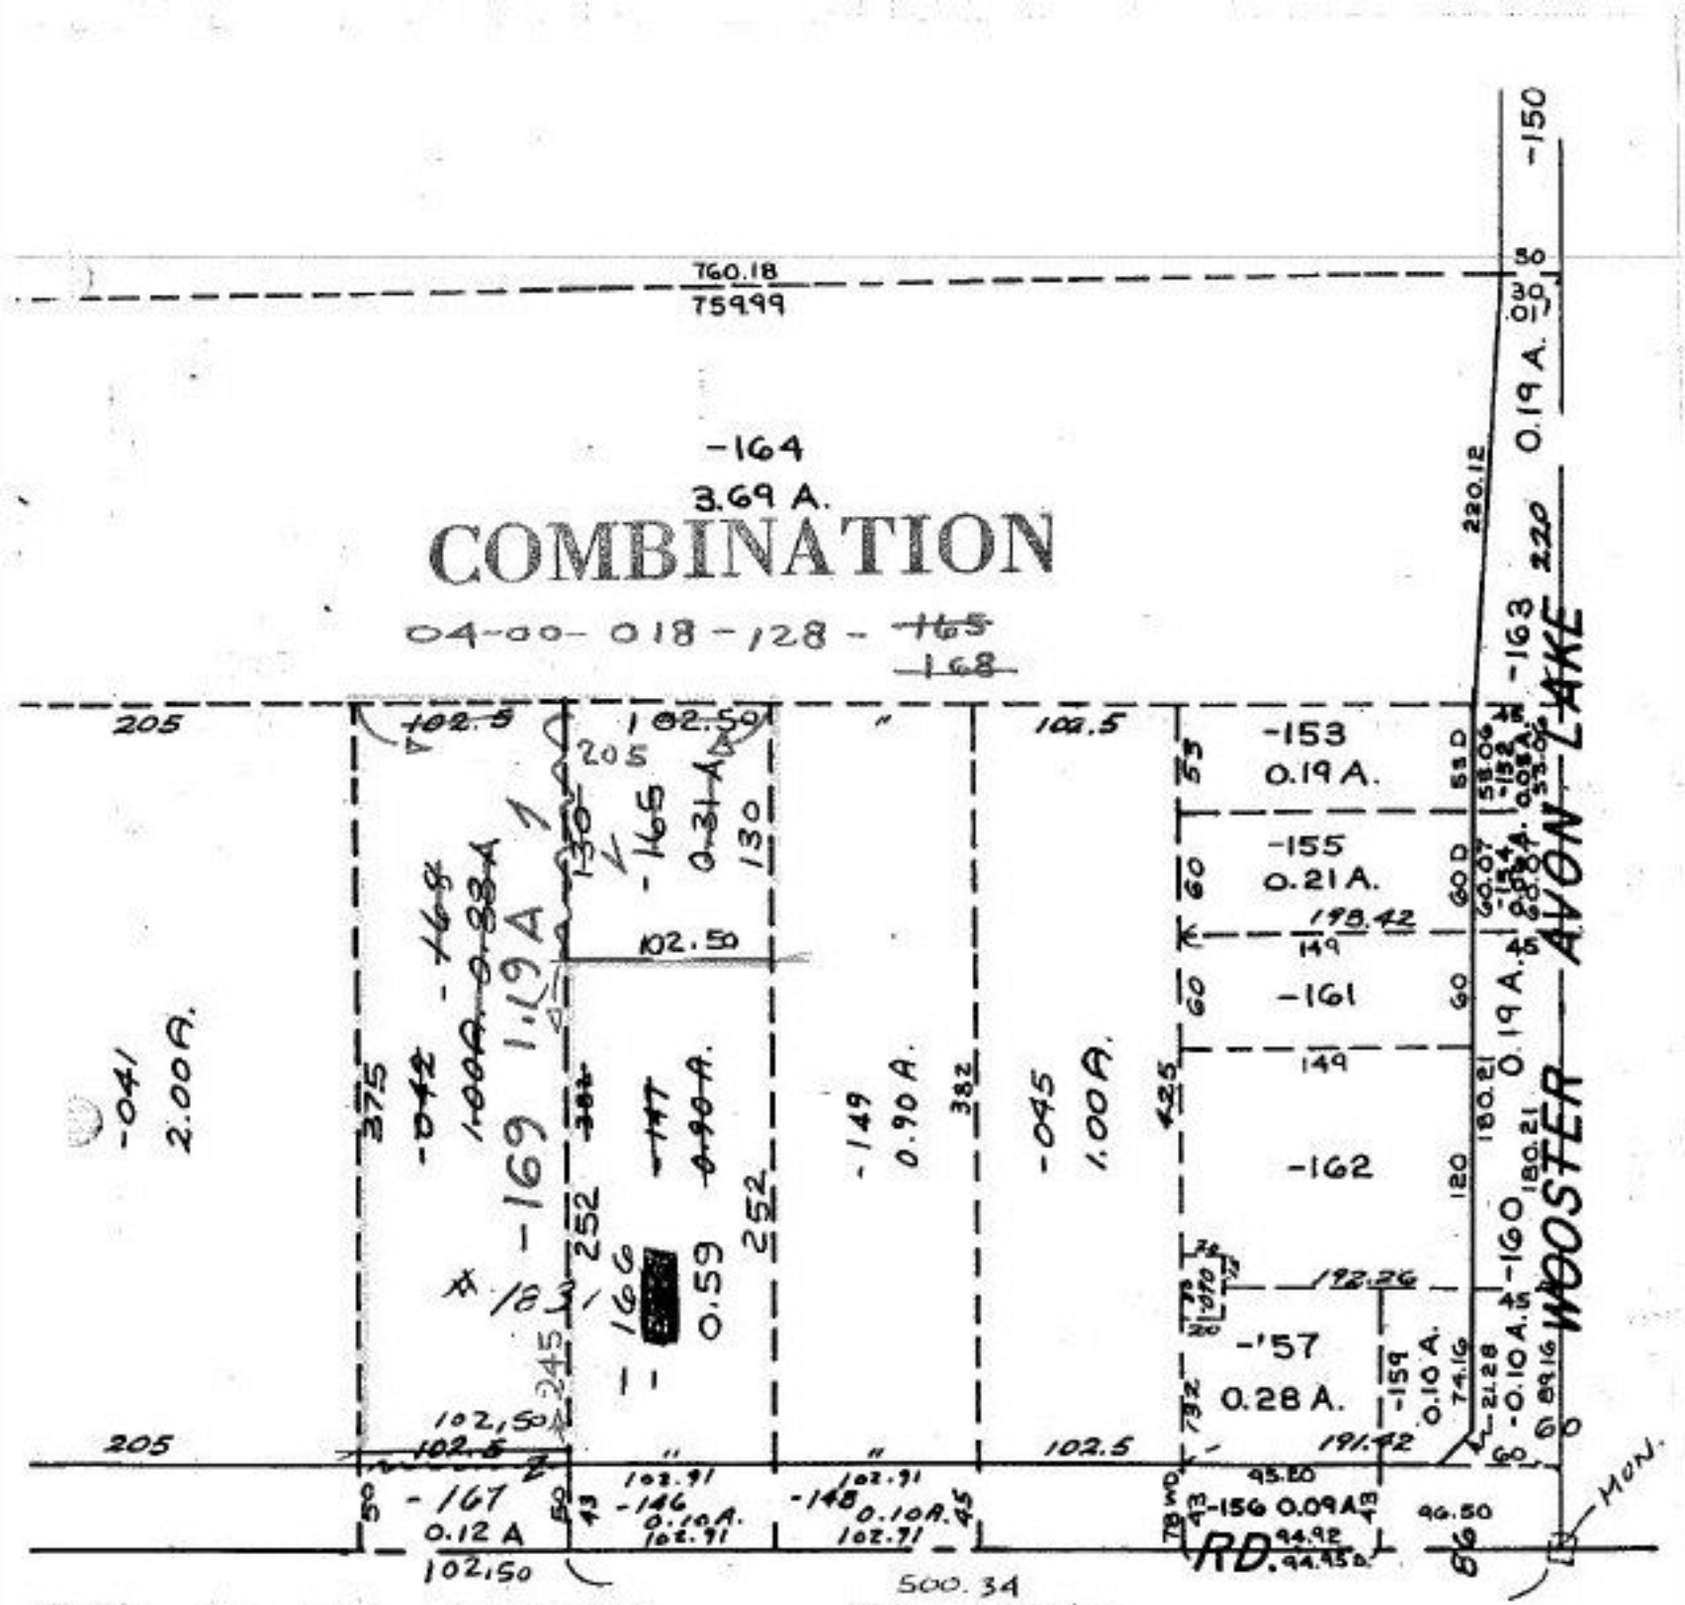

04-00-018-128-
PRIOR INST. 1045/356
SURVEYED BY: K S A
C=1: INF.

6/15/89
#18319A
APPROVED
LORAIN CO.
MAP DEPT.
DATE 2-15-89
PAGE 4-00-018-J
BY Carol Francis
VOID After # 18319-A

#18315
APPROVED
LORAIN CO.
MAP DEPT.
DATE 2-1-89
PAGE 4-00-018J
BY CAROL FRANCIS
VOID After # 18315