EE 2-02-025-B

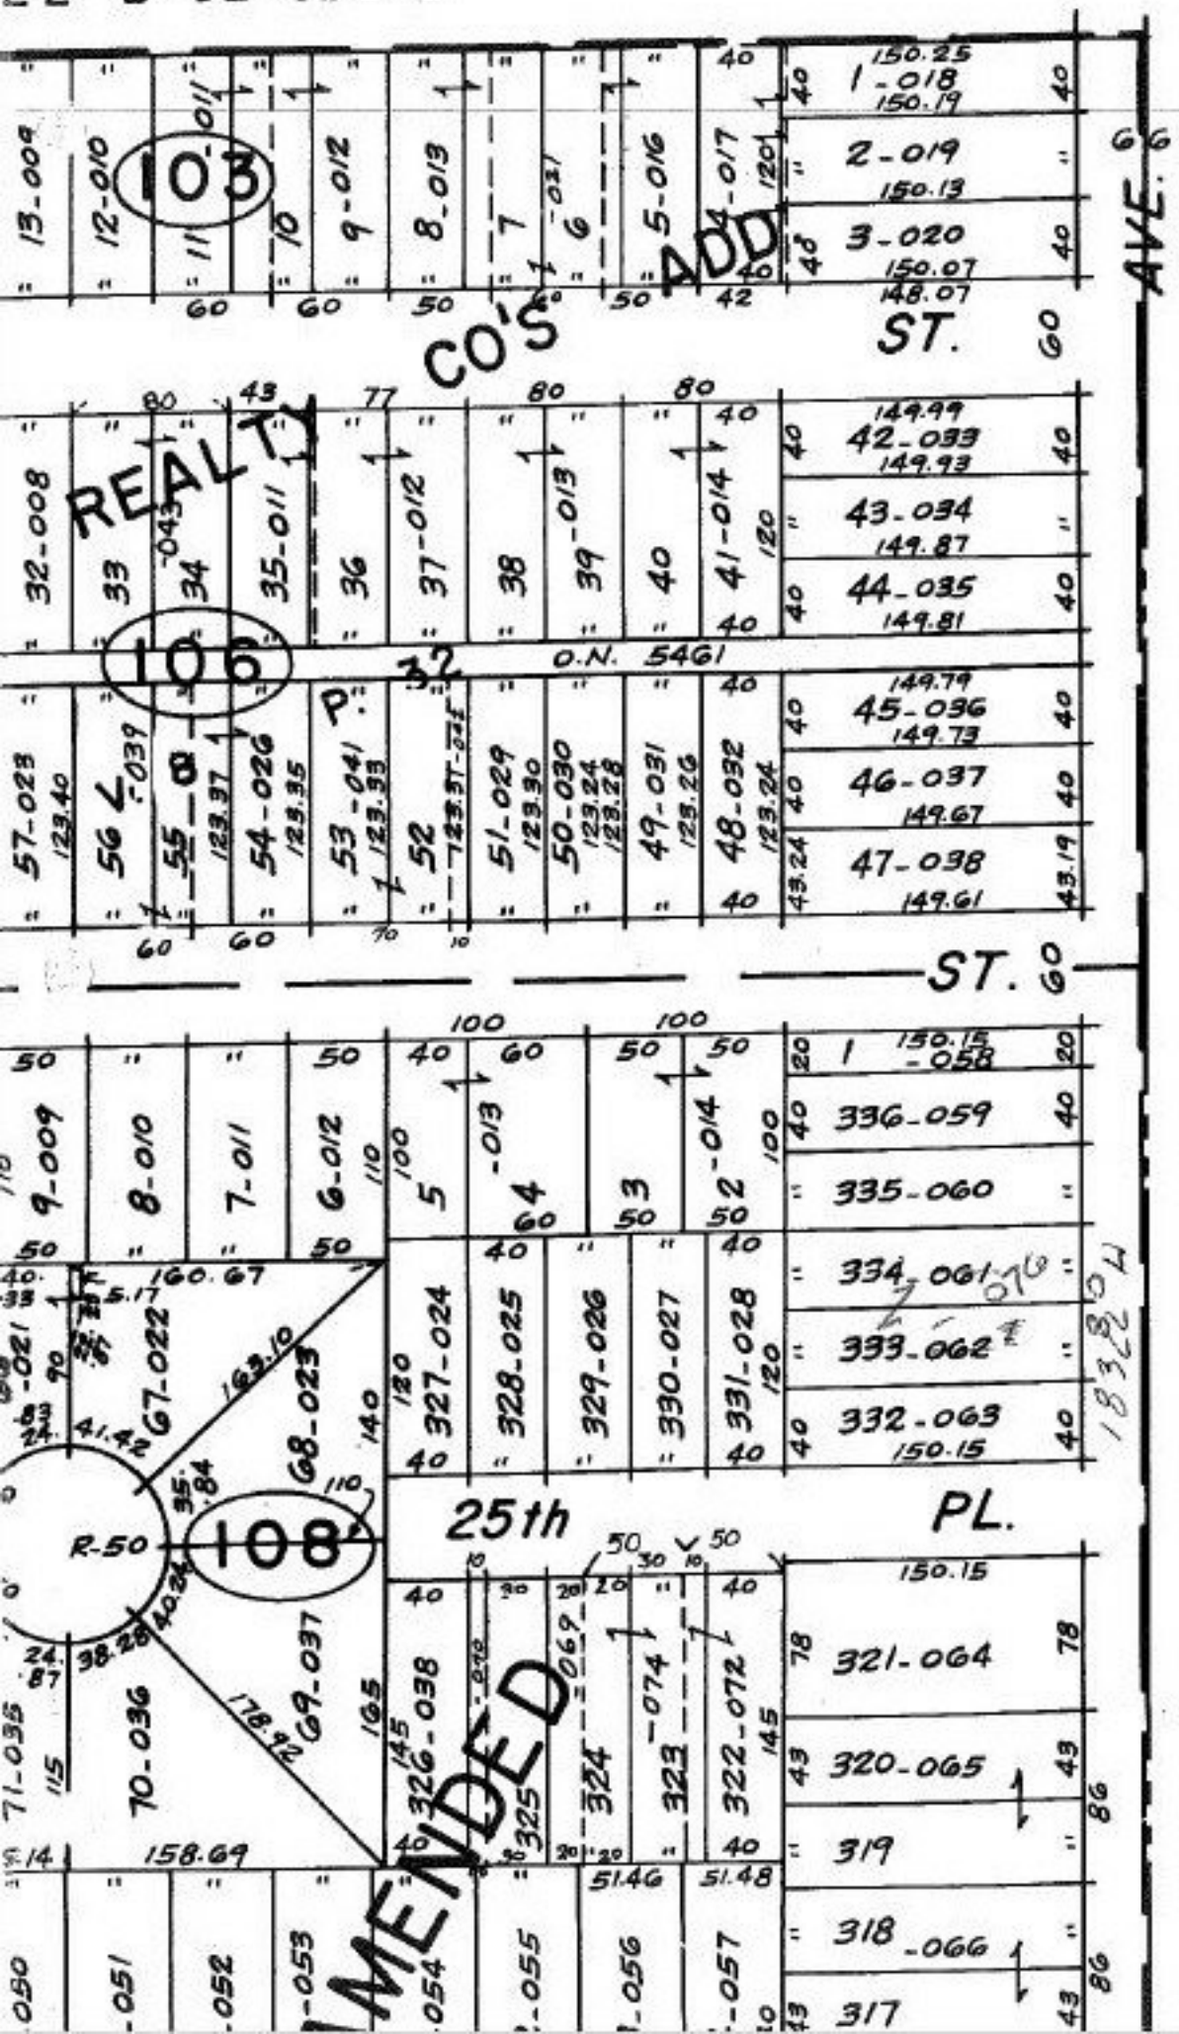

COMBINATION

02-02-016-108-~~064~~ 062

2/28/89

#18322 A

APPROVED
LORAIN CO.
MAP DEPT.

DATE 2-15-89

PAGE 2-02-016-B

BY Carolyn Franc

VOID ACTION # 18322-A