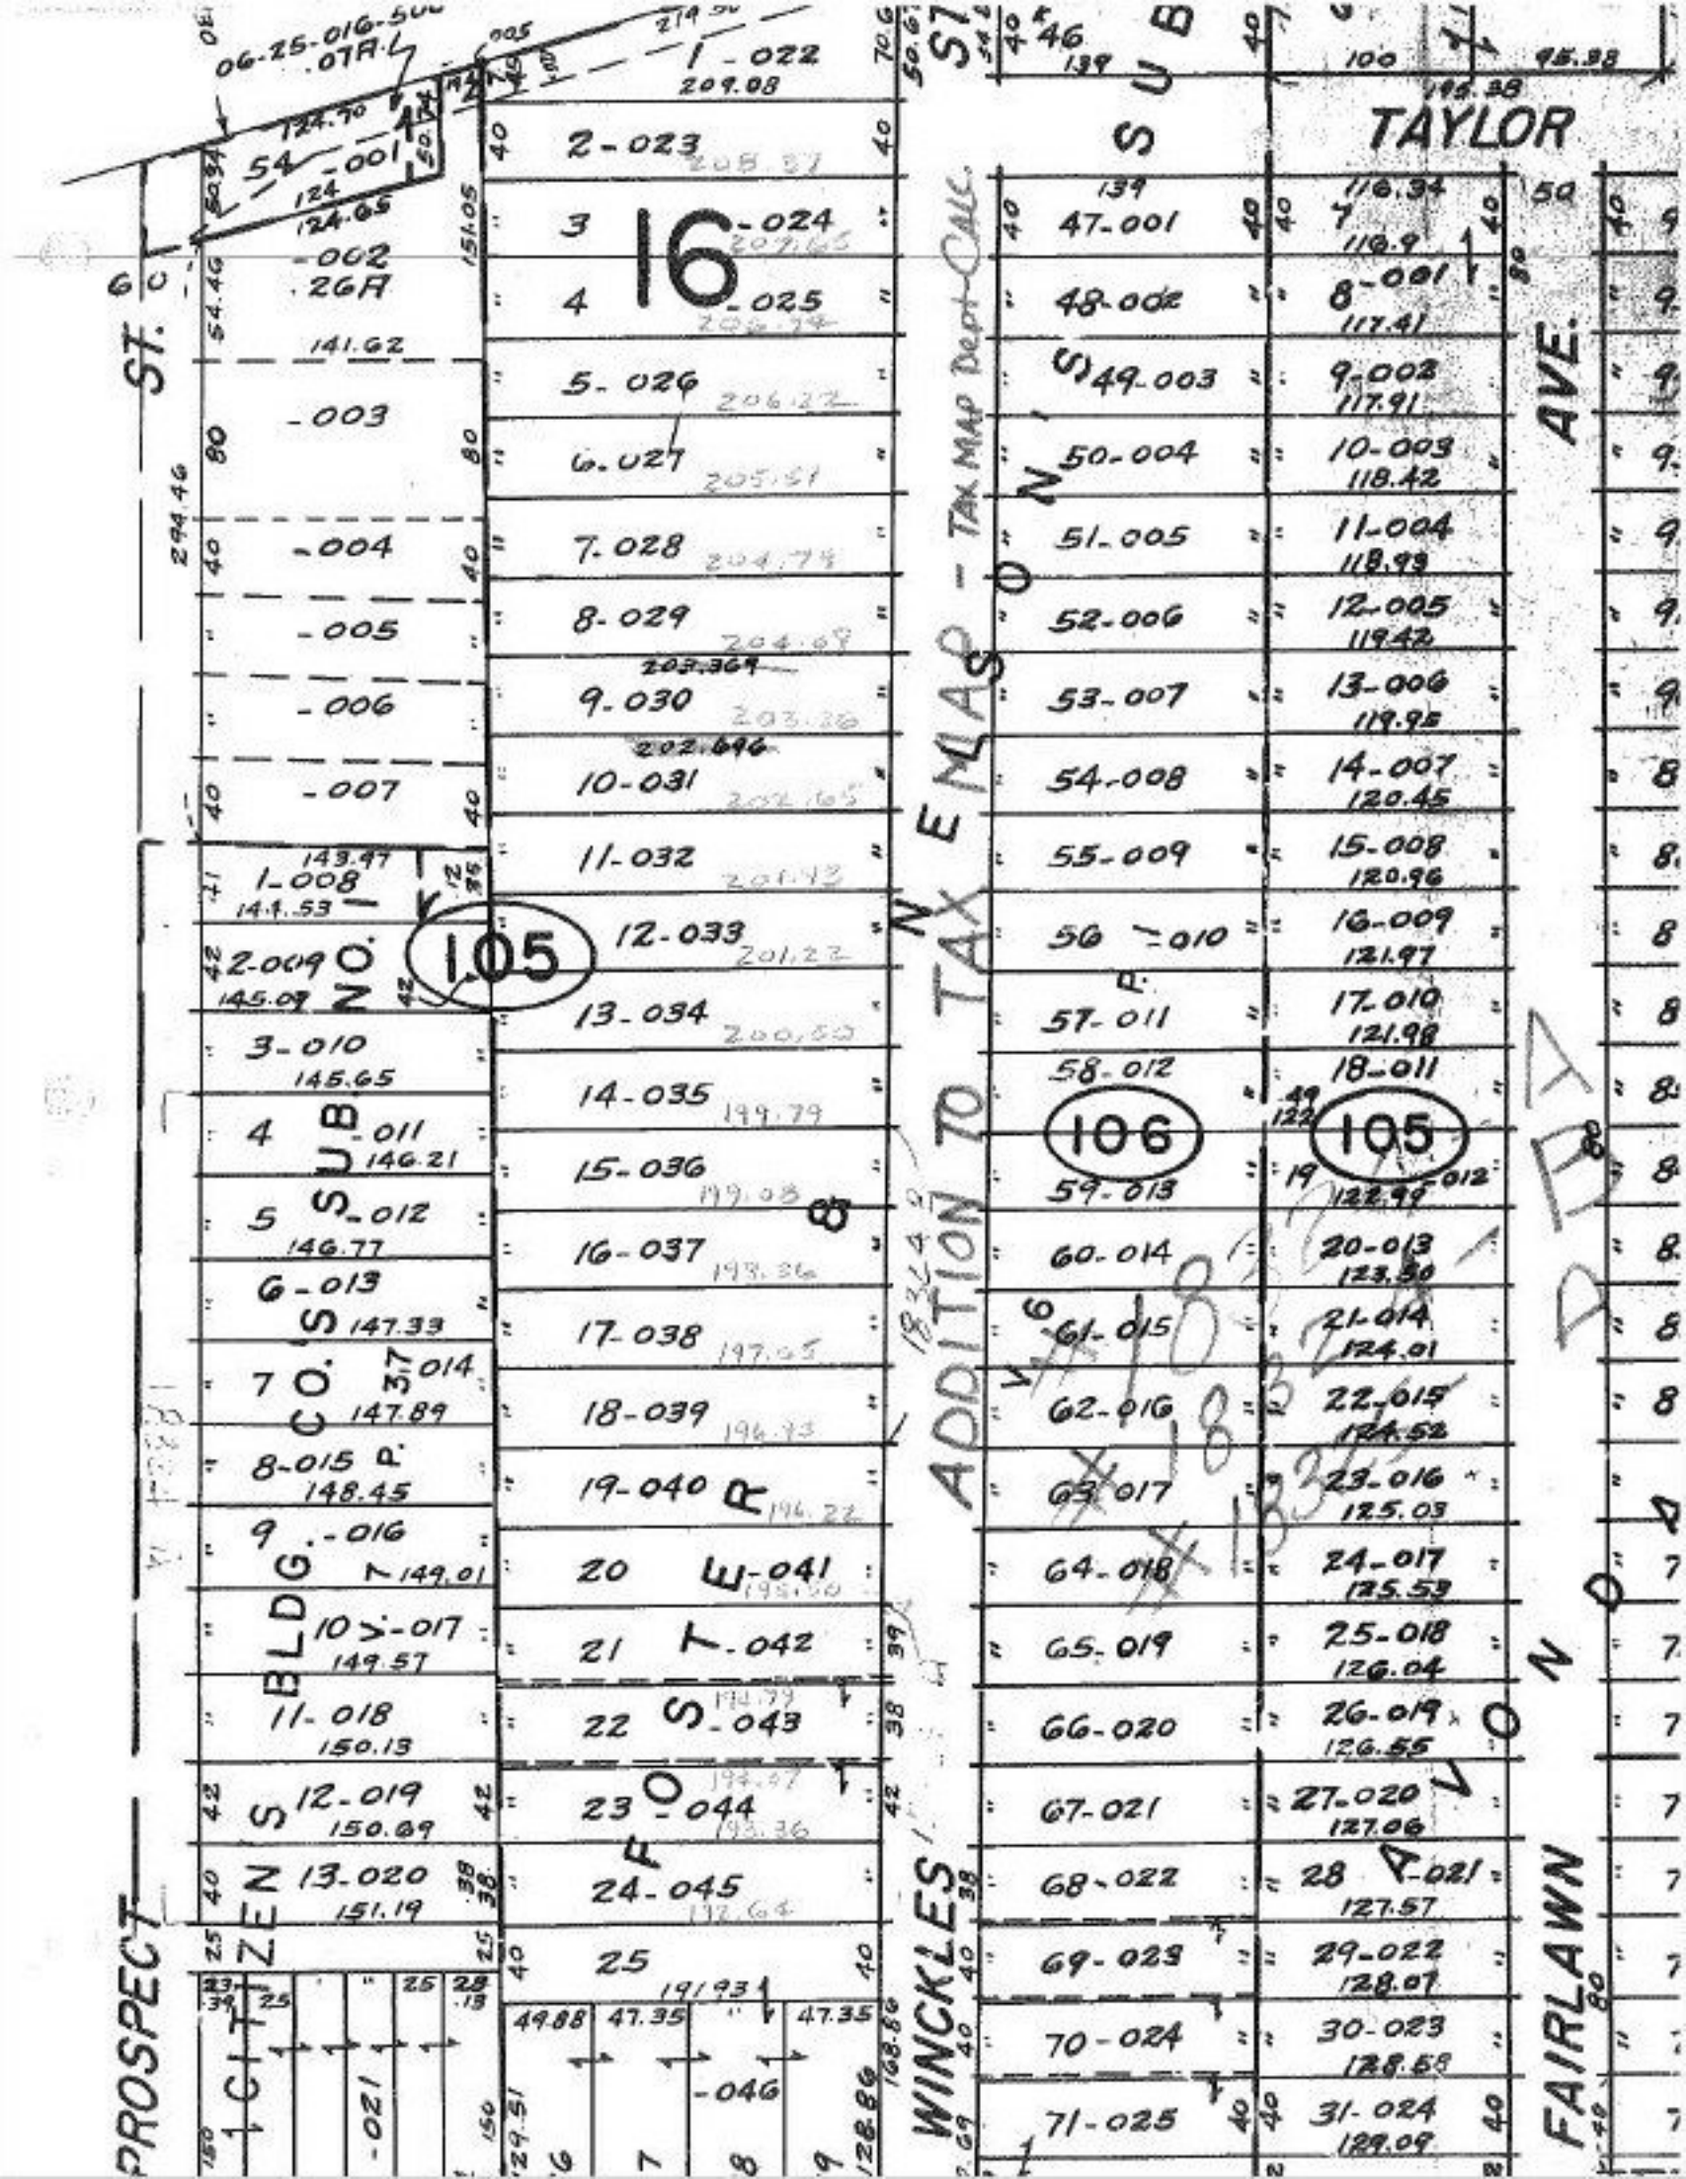
ADDITION TO TAX MAP OF NEMASON
TAX MAP Dept-Calc.
TAYLOR
AVE.
ST.
PROSPECT
WINCKLES
FAIRLAWN
AVE.
105
106
105
16
SUB
SUB
SUB