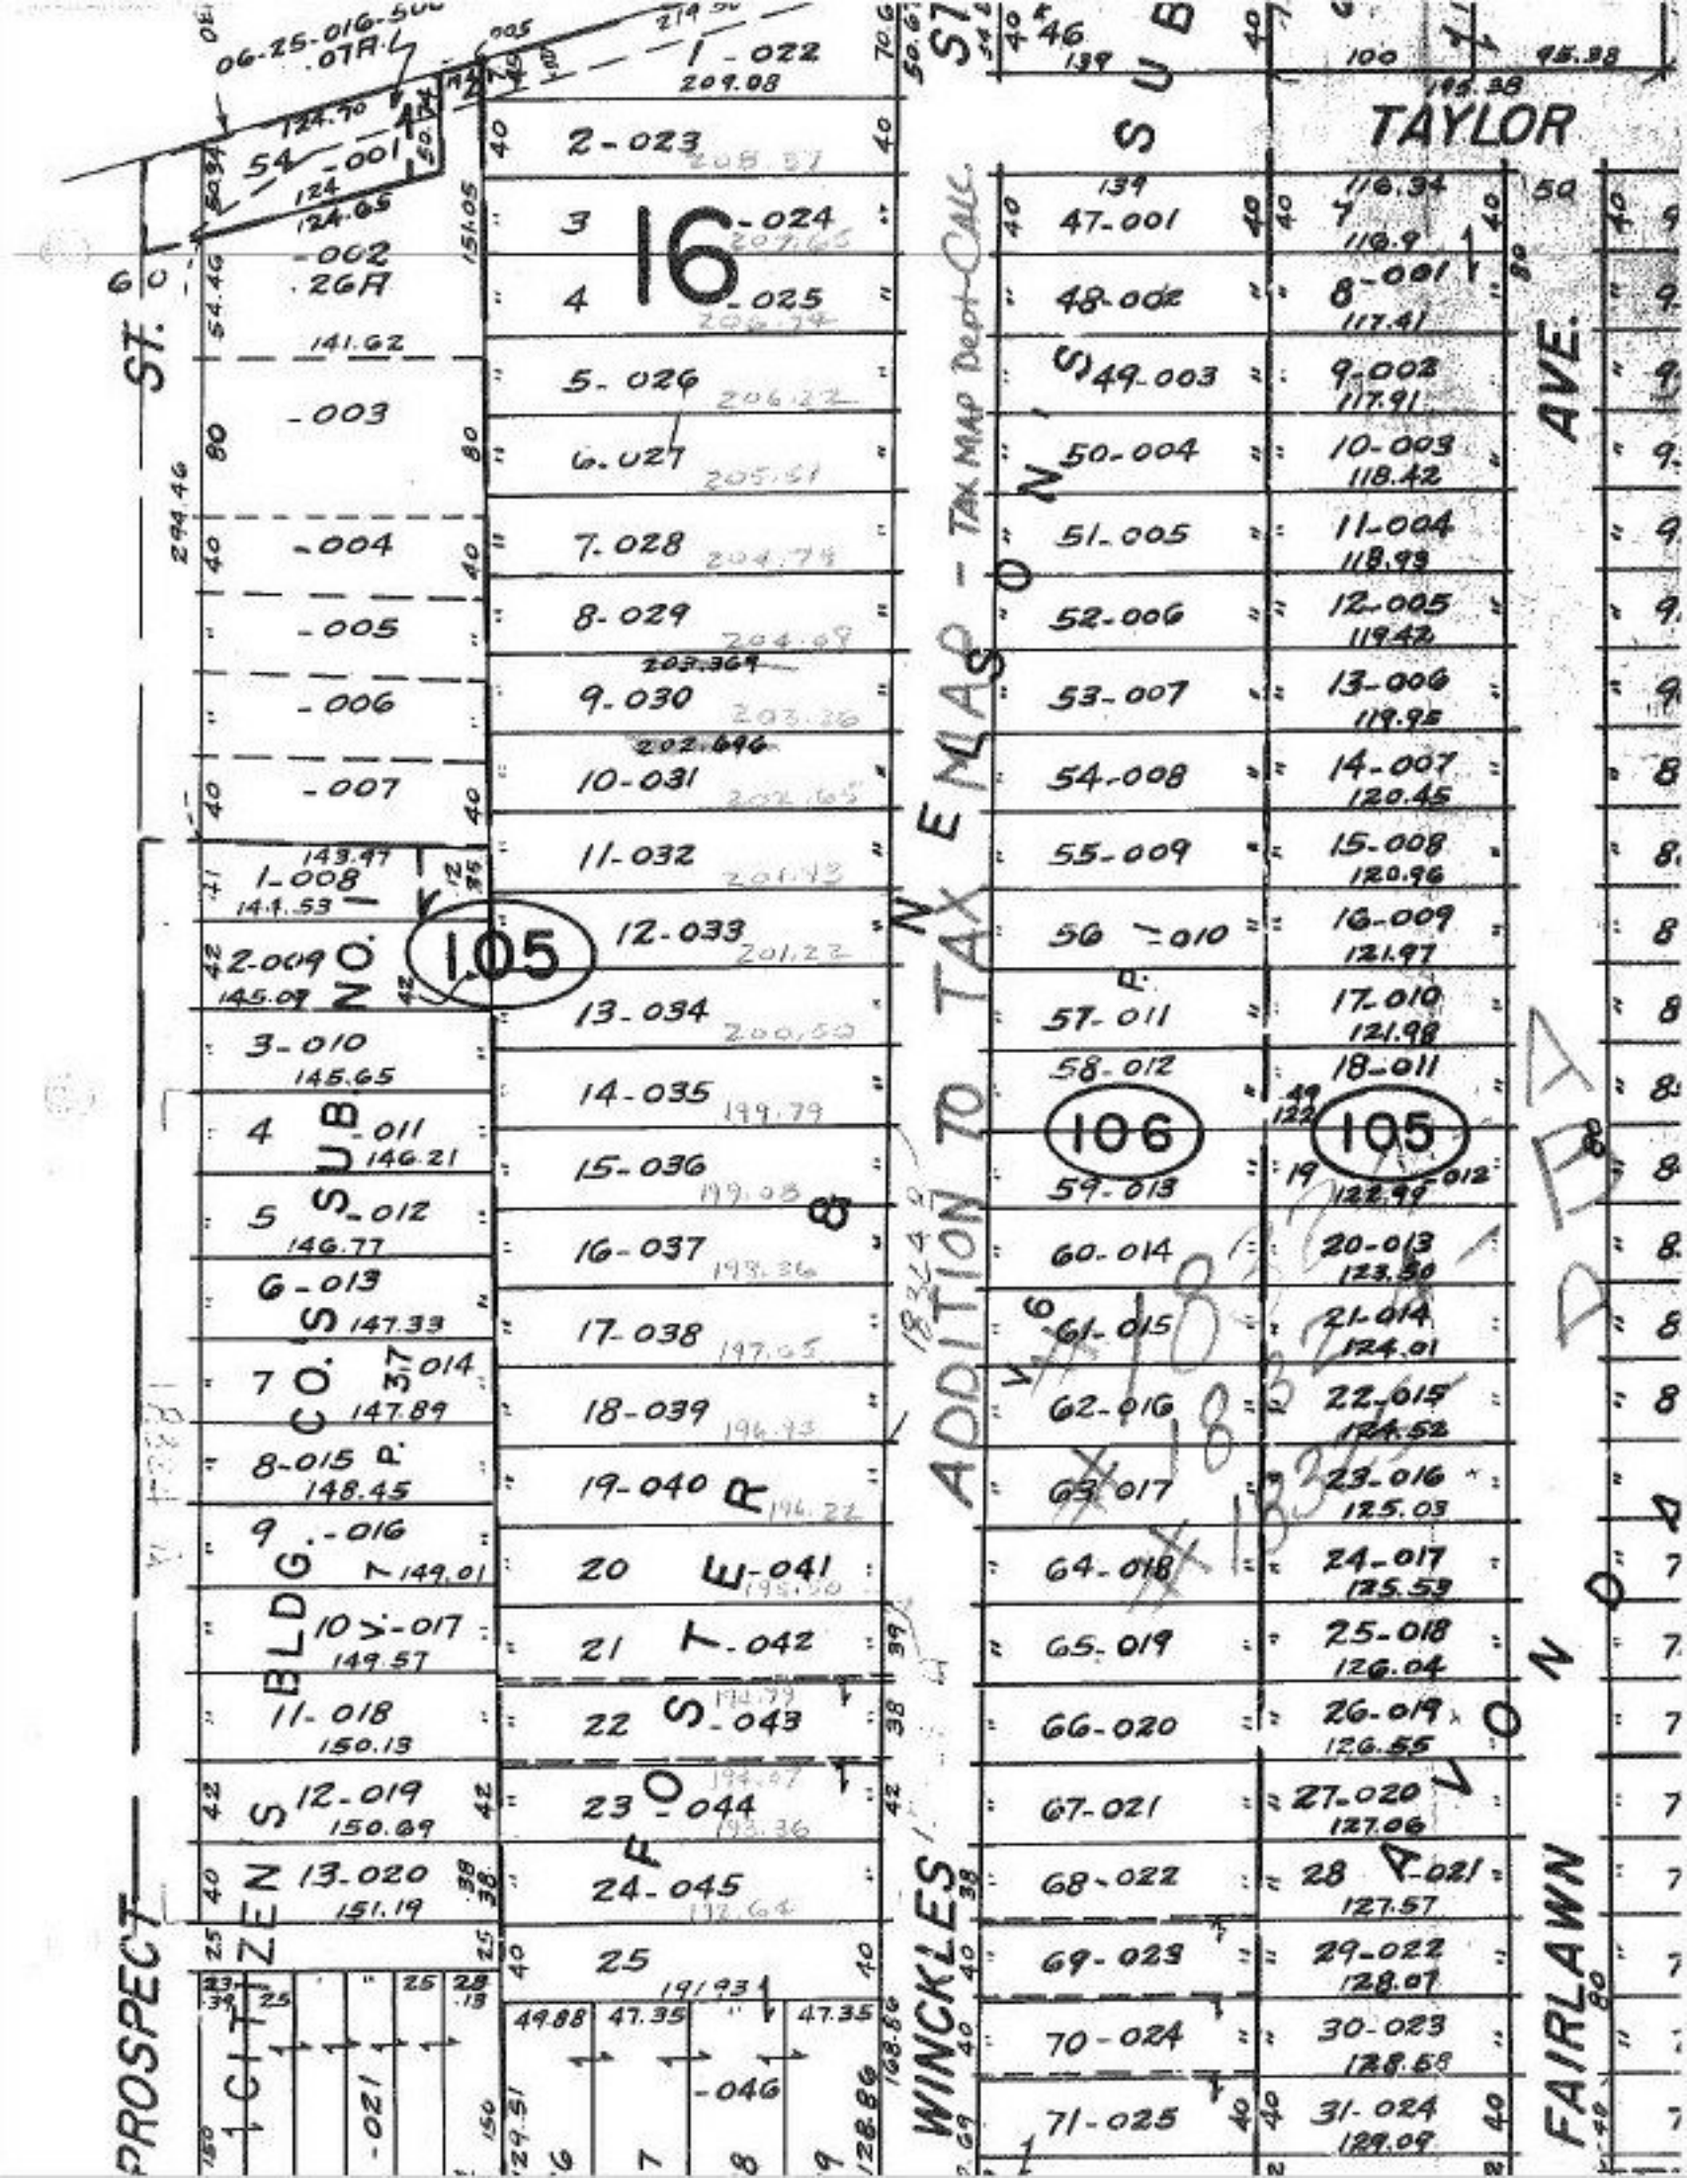
ST.
PROSPECT
CITIZENS
BLDG. CO'S SUB
NEMASO
ADDITION TO TAX MAP - TAX MAP Dept-Calc.
SUB
TAYLOR
AVE.
FAIRLAWN
AVE.
16
105
106
105
06-25-016-500
.07A
54-001
-002
.26A
-003
-004
-005
-006
-007
1-008
2-009
3-010
4-011
5-012
6-013
7-014
8-015
9-016
10-017
11-018
12-019
13-020
1-022
2-023
3-024
4-025
5-026
6-027
7-028
8-029
9-030
10-031
11-032
12-033
13-034
14-035
15-036
16-037
17-038
18-039
19-040
20-041
21-042
22-043
23-044
24-045
25
-021
-046
47-001
48-002
49-003
50-004
51-005
52-006
53-007
54-008
55-009
56-010
57-011
58-012
59-013
60-014
61-015
62-016
63-017
64-018
65-019
66-020
67-021
68-022
69-023
70-024
71-025
8-001
9-002
10-003
11-004
12-005
13-006
14-007
15-008
16-009
17-010
18-011
20-013
21-014
22-015
23-016
24-017
25-018
26-019
27-020
28-021
29-022
30-023
31-024