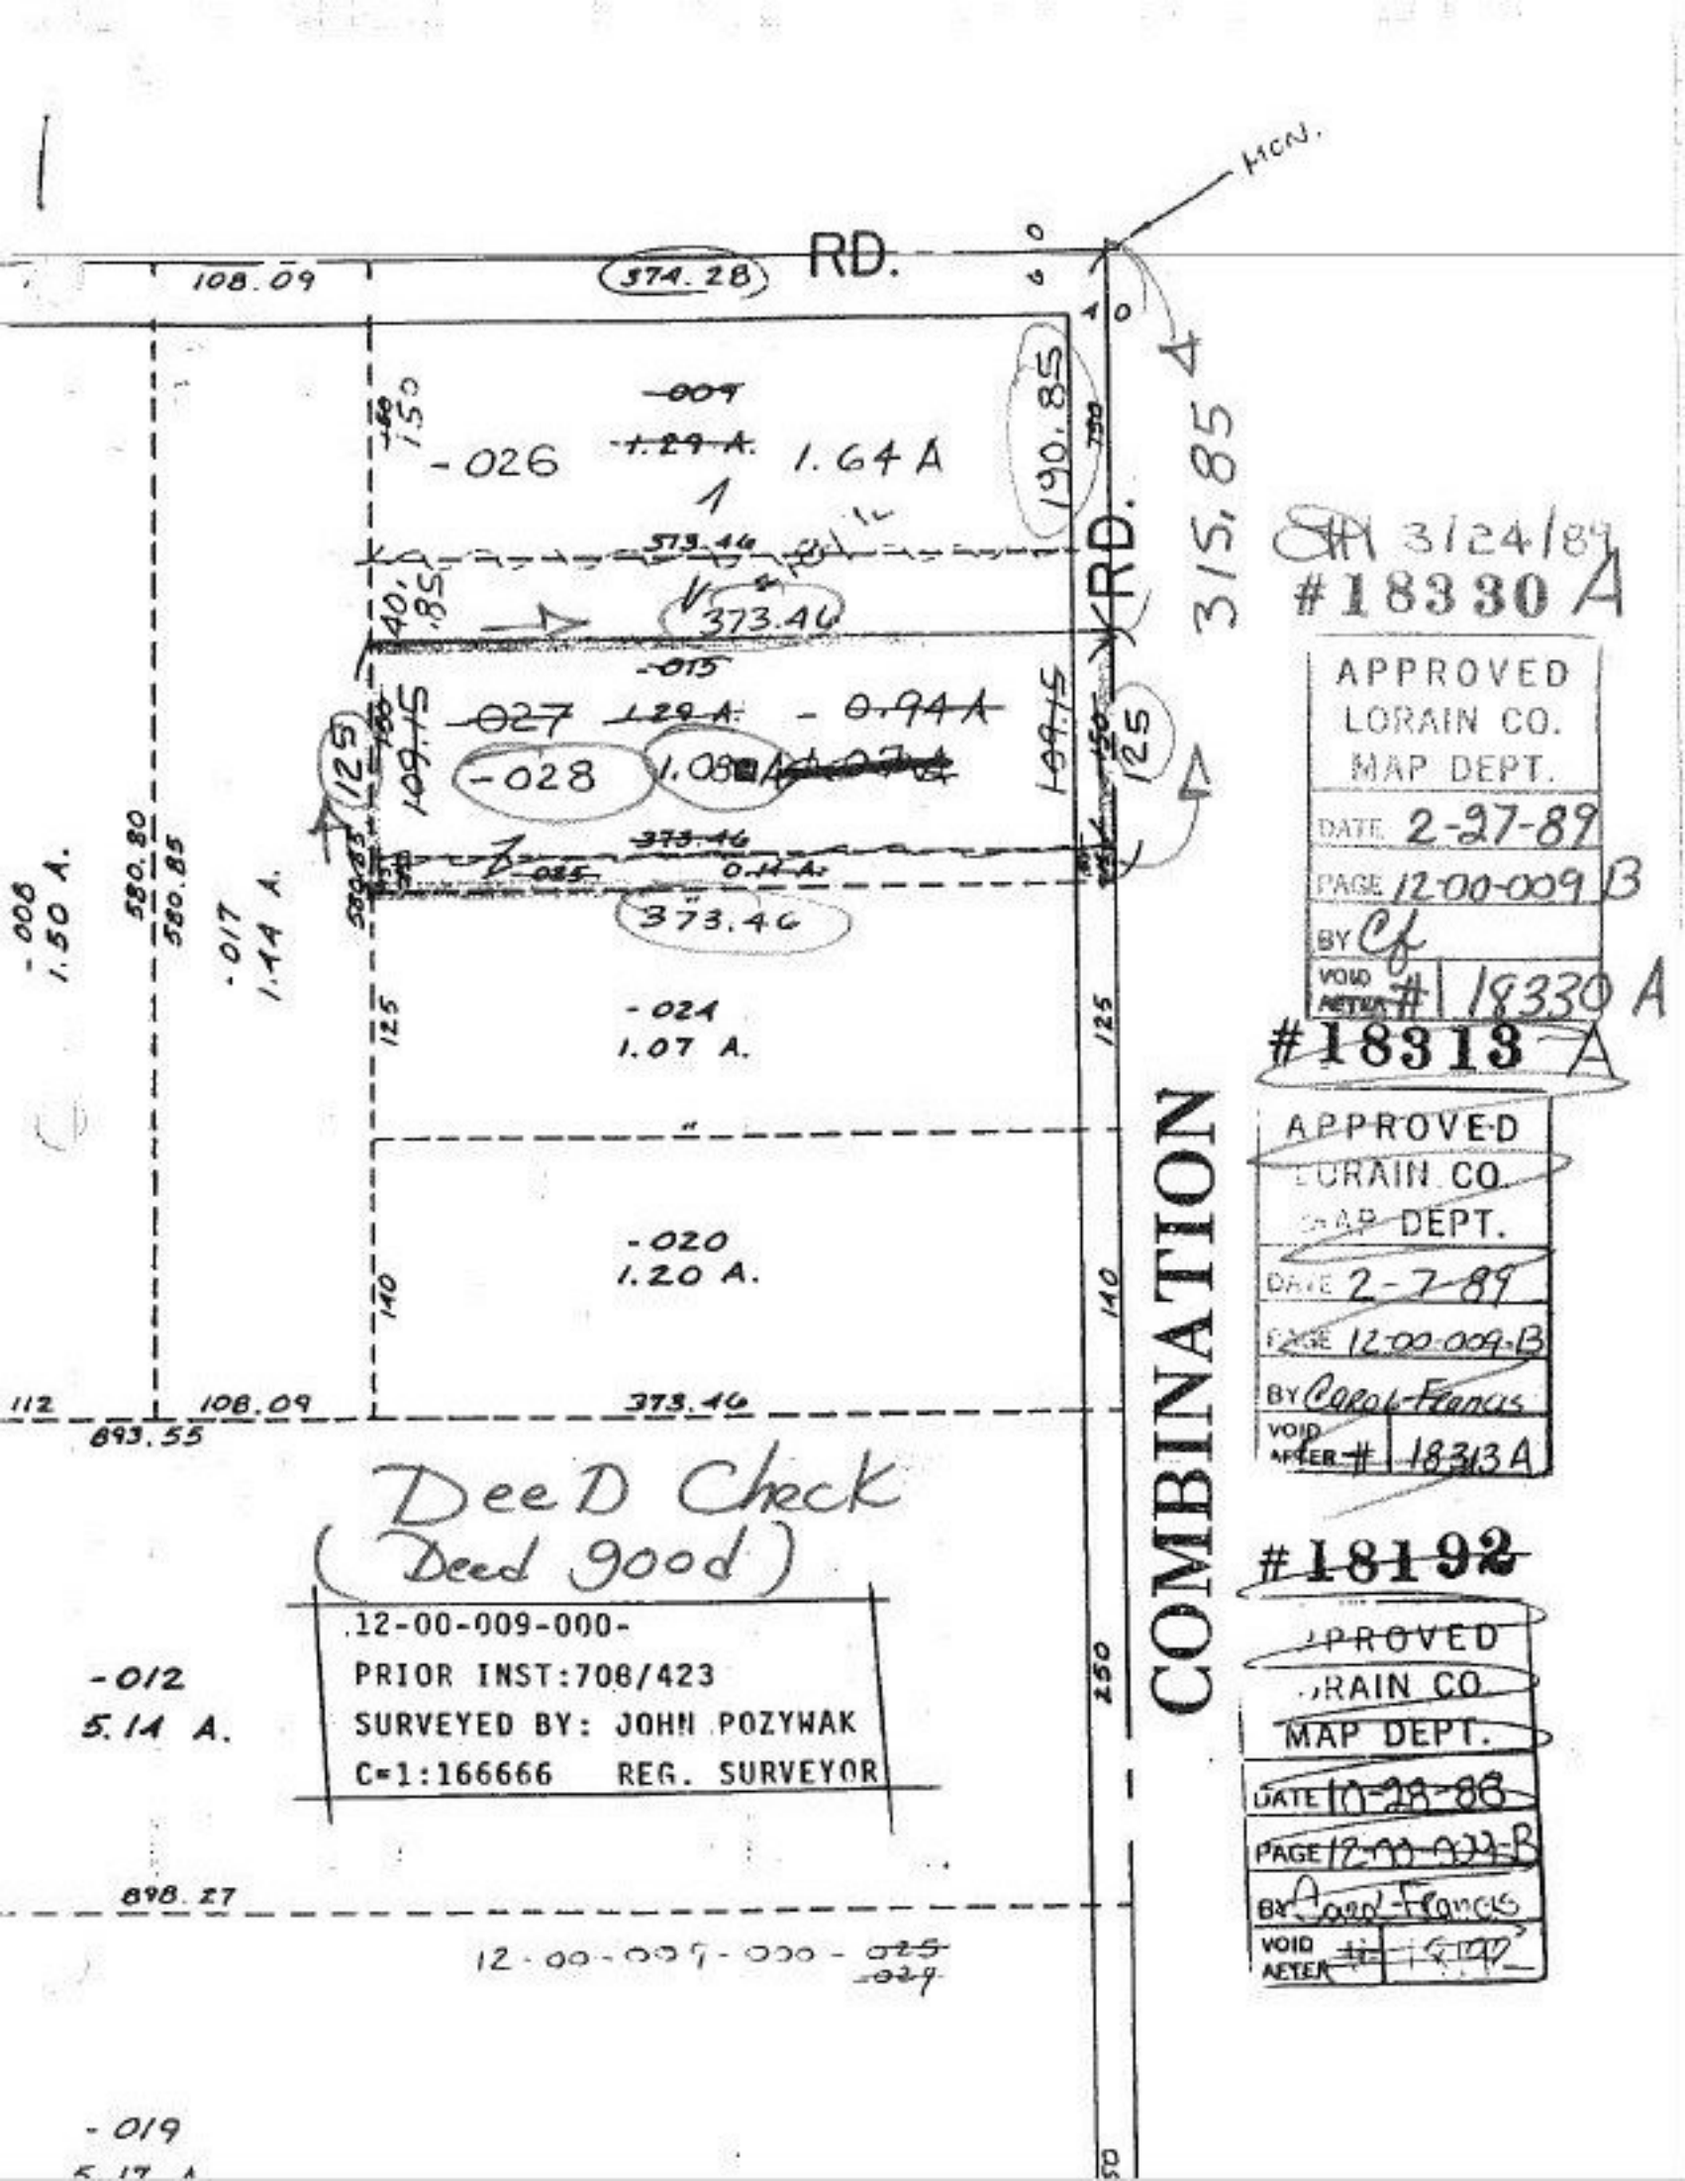

MON.
RD.
108.09
374.28
-009
1.29 A.
-026
1.64 A
190.85
315.85
RD.
373.46
373.46
-015
-027
1.29 A.
-0.94 A
-028
1.08
109.15
125
373.46
0.14 A.
373.46
-008
1.50 A.
580.80
580.85
-017
1.44 A.
-024
1.07 A.
-020
1.20 A.
112
108.09
373.46
893.55
Deed Check
(Deed good)
12-00-009-000-
PRIOR INST:708/423
SURVEYED BY: JOHN POZYWAK
C=1:166666 REG. SURVEYOR
-012
5.14 A.
898.27
12-00-009-000-025
-019
COMBINATION
3/24/89
#18330 A
APPROVED
LORAIN CO.
MAP DEPT.
DATE 2-27-89
PAGE 12-00-009 B
BY Cf
VOID AFTER # 18330 A
#18313 A
APPROVED
LORAIN CO.
MAP DEPT.
DATE 2-7-89
PAGE 12-00-009-B
BY Carol Francis
VOID AFTER # 18313 A
#18192
APPROVED
LORAIN CO.
MAP DEPT.
DATE 10-28-88
PAGE 12-00-009-B
BY Carol Francis
VOID AFTER # 18192