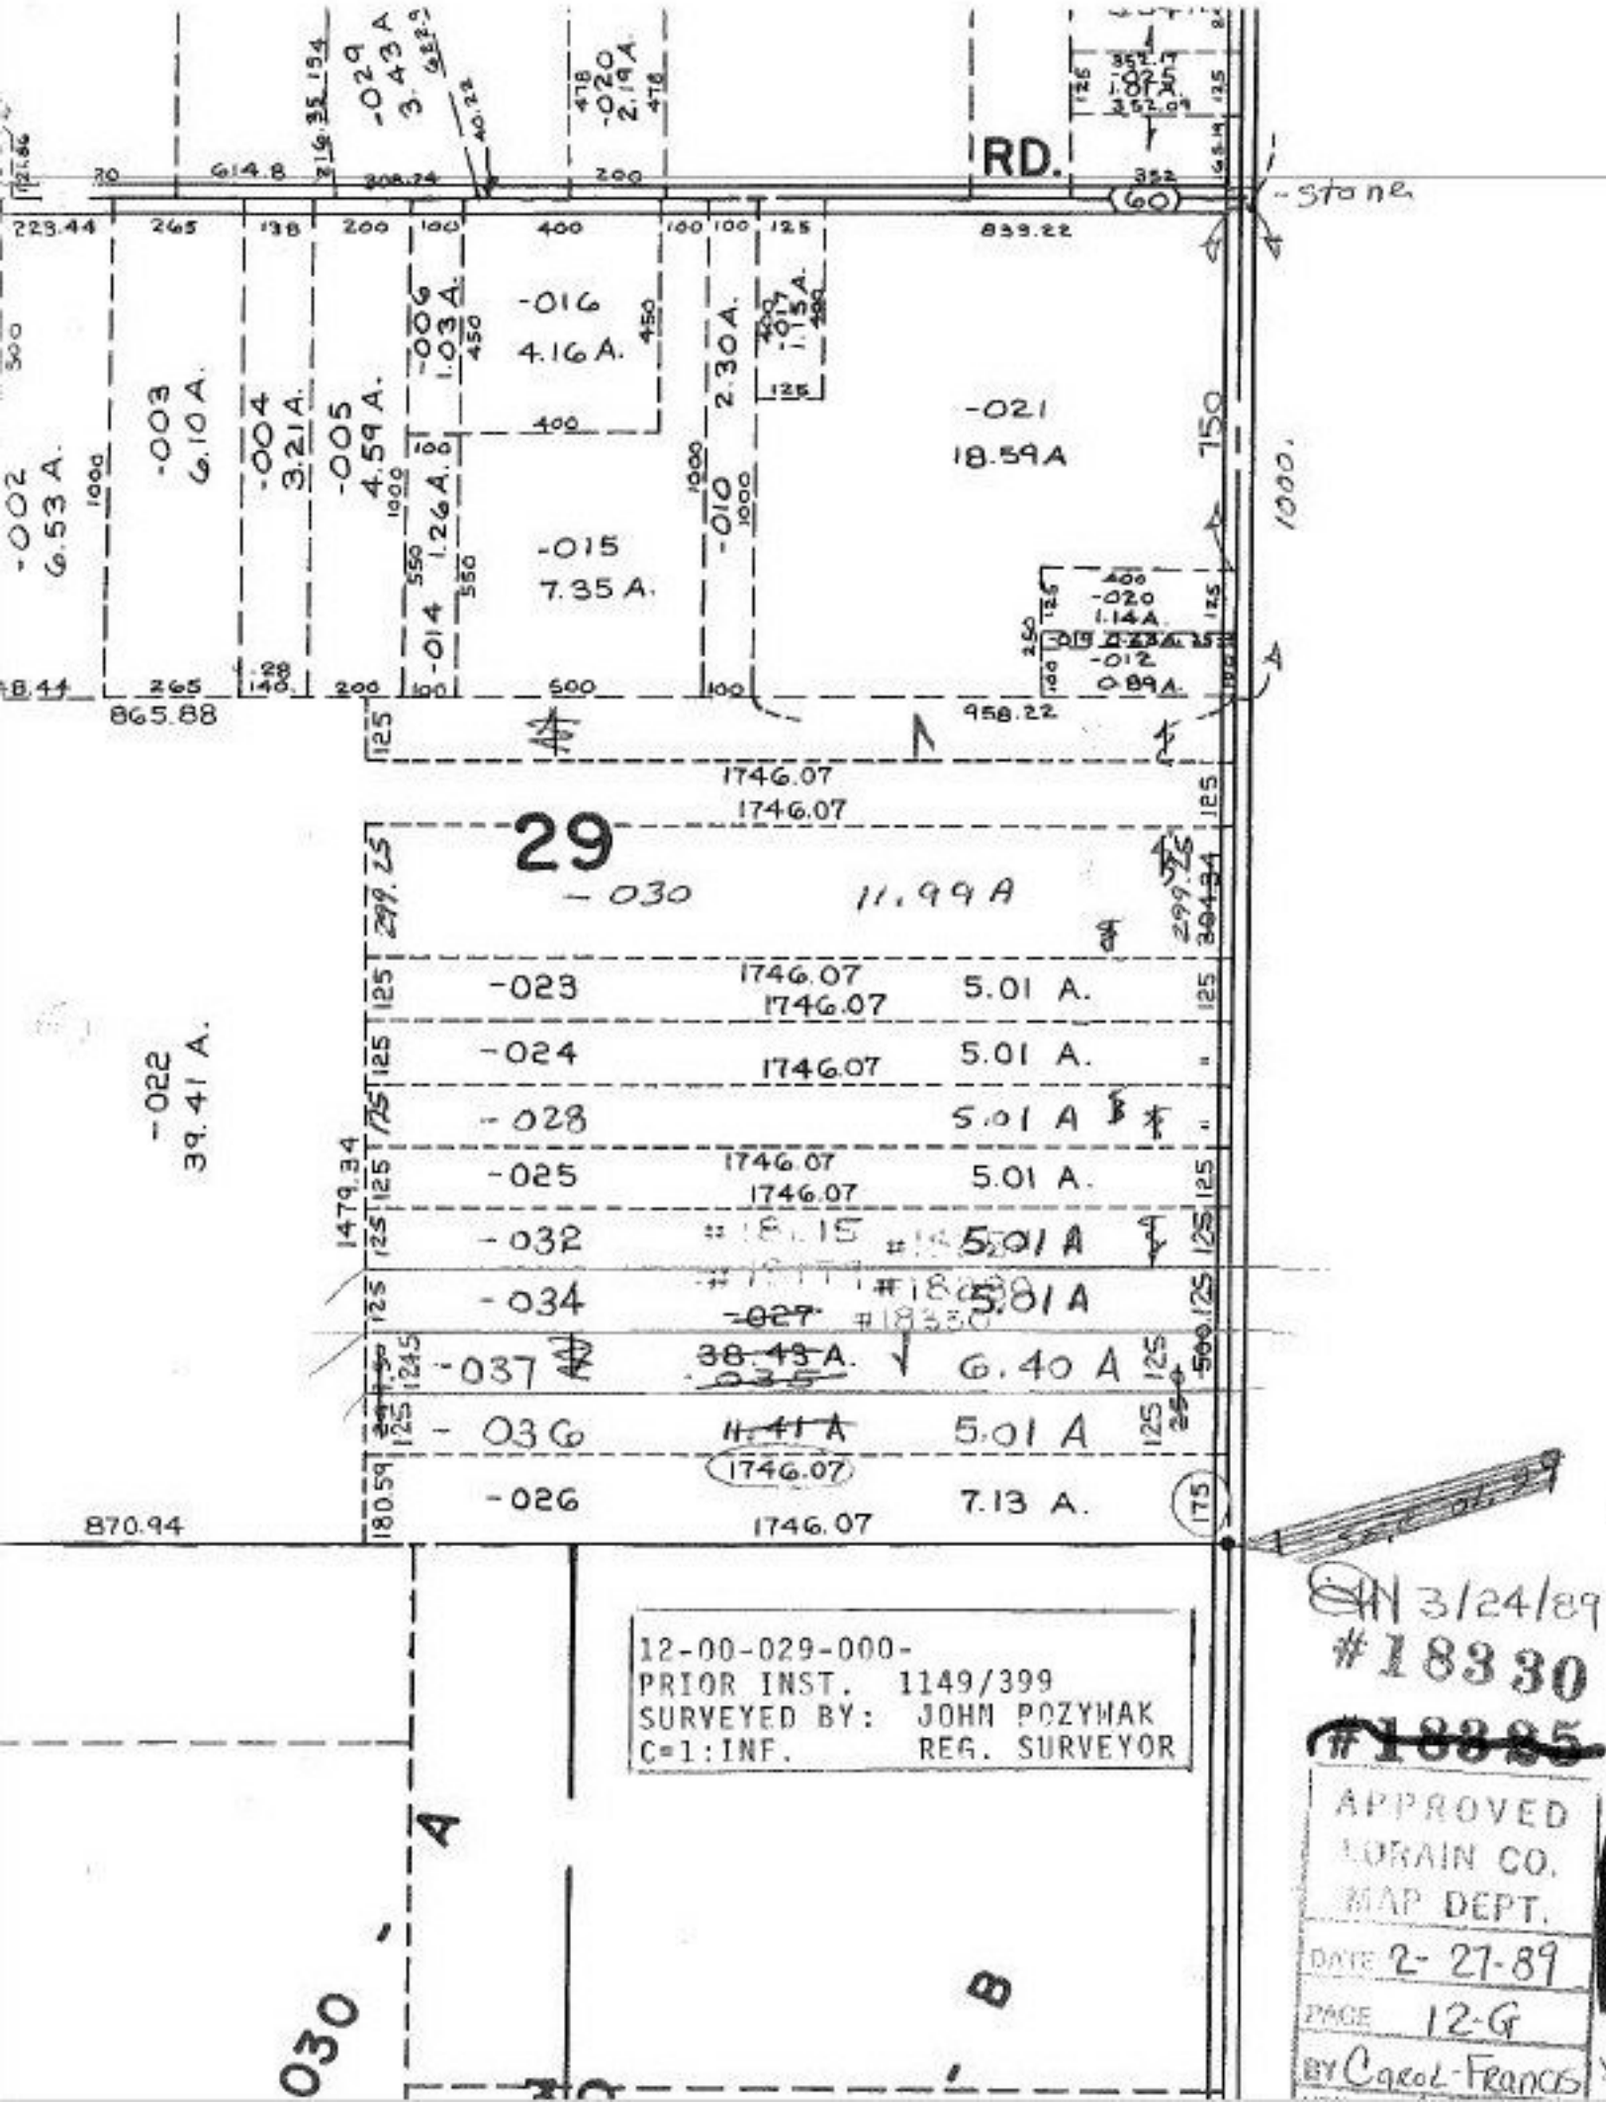
RD.
-029
3.43 A.
-020
2.19 A.
-016
4.16 A.
-006
1.03 A.
-003
6.10 A.
-004
3.21 A.
-005
4.59 A.
-002
6.53 A.
-015
7.35 A.
-014
1.26 A.
-010
2.30 A.
-021
18.59 A
-020
1.14 A.
-012
0.89 A.
29
-030
11.99 A
-023
5.01 A.
-024
5.01 A.
-028
5.01 A
-025
5.01 A.
-032
5.01 A
-034
5.01 A
-037
6.40 A
-036
5.01 A
-026
7.13 A.
-022
39.41 A.
1746.07
stone
12-00-029-000-
PRIOR INST. 1149/399
SURVEYED BY: JOHN POZYWAK
C=1:INF. REG. SURVEYOR
3/24/89
#18330
#18885
APPROVED
LORAIN CO.
MAP DEPT.
DATE 2-27-89
PAGE 12-G
BY Carol-Frances
#18330