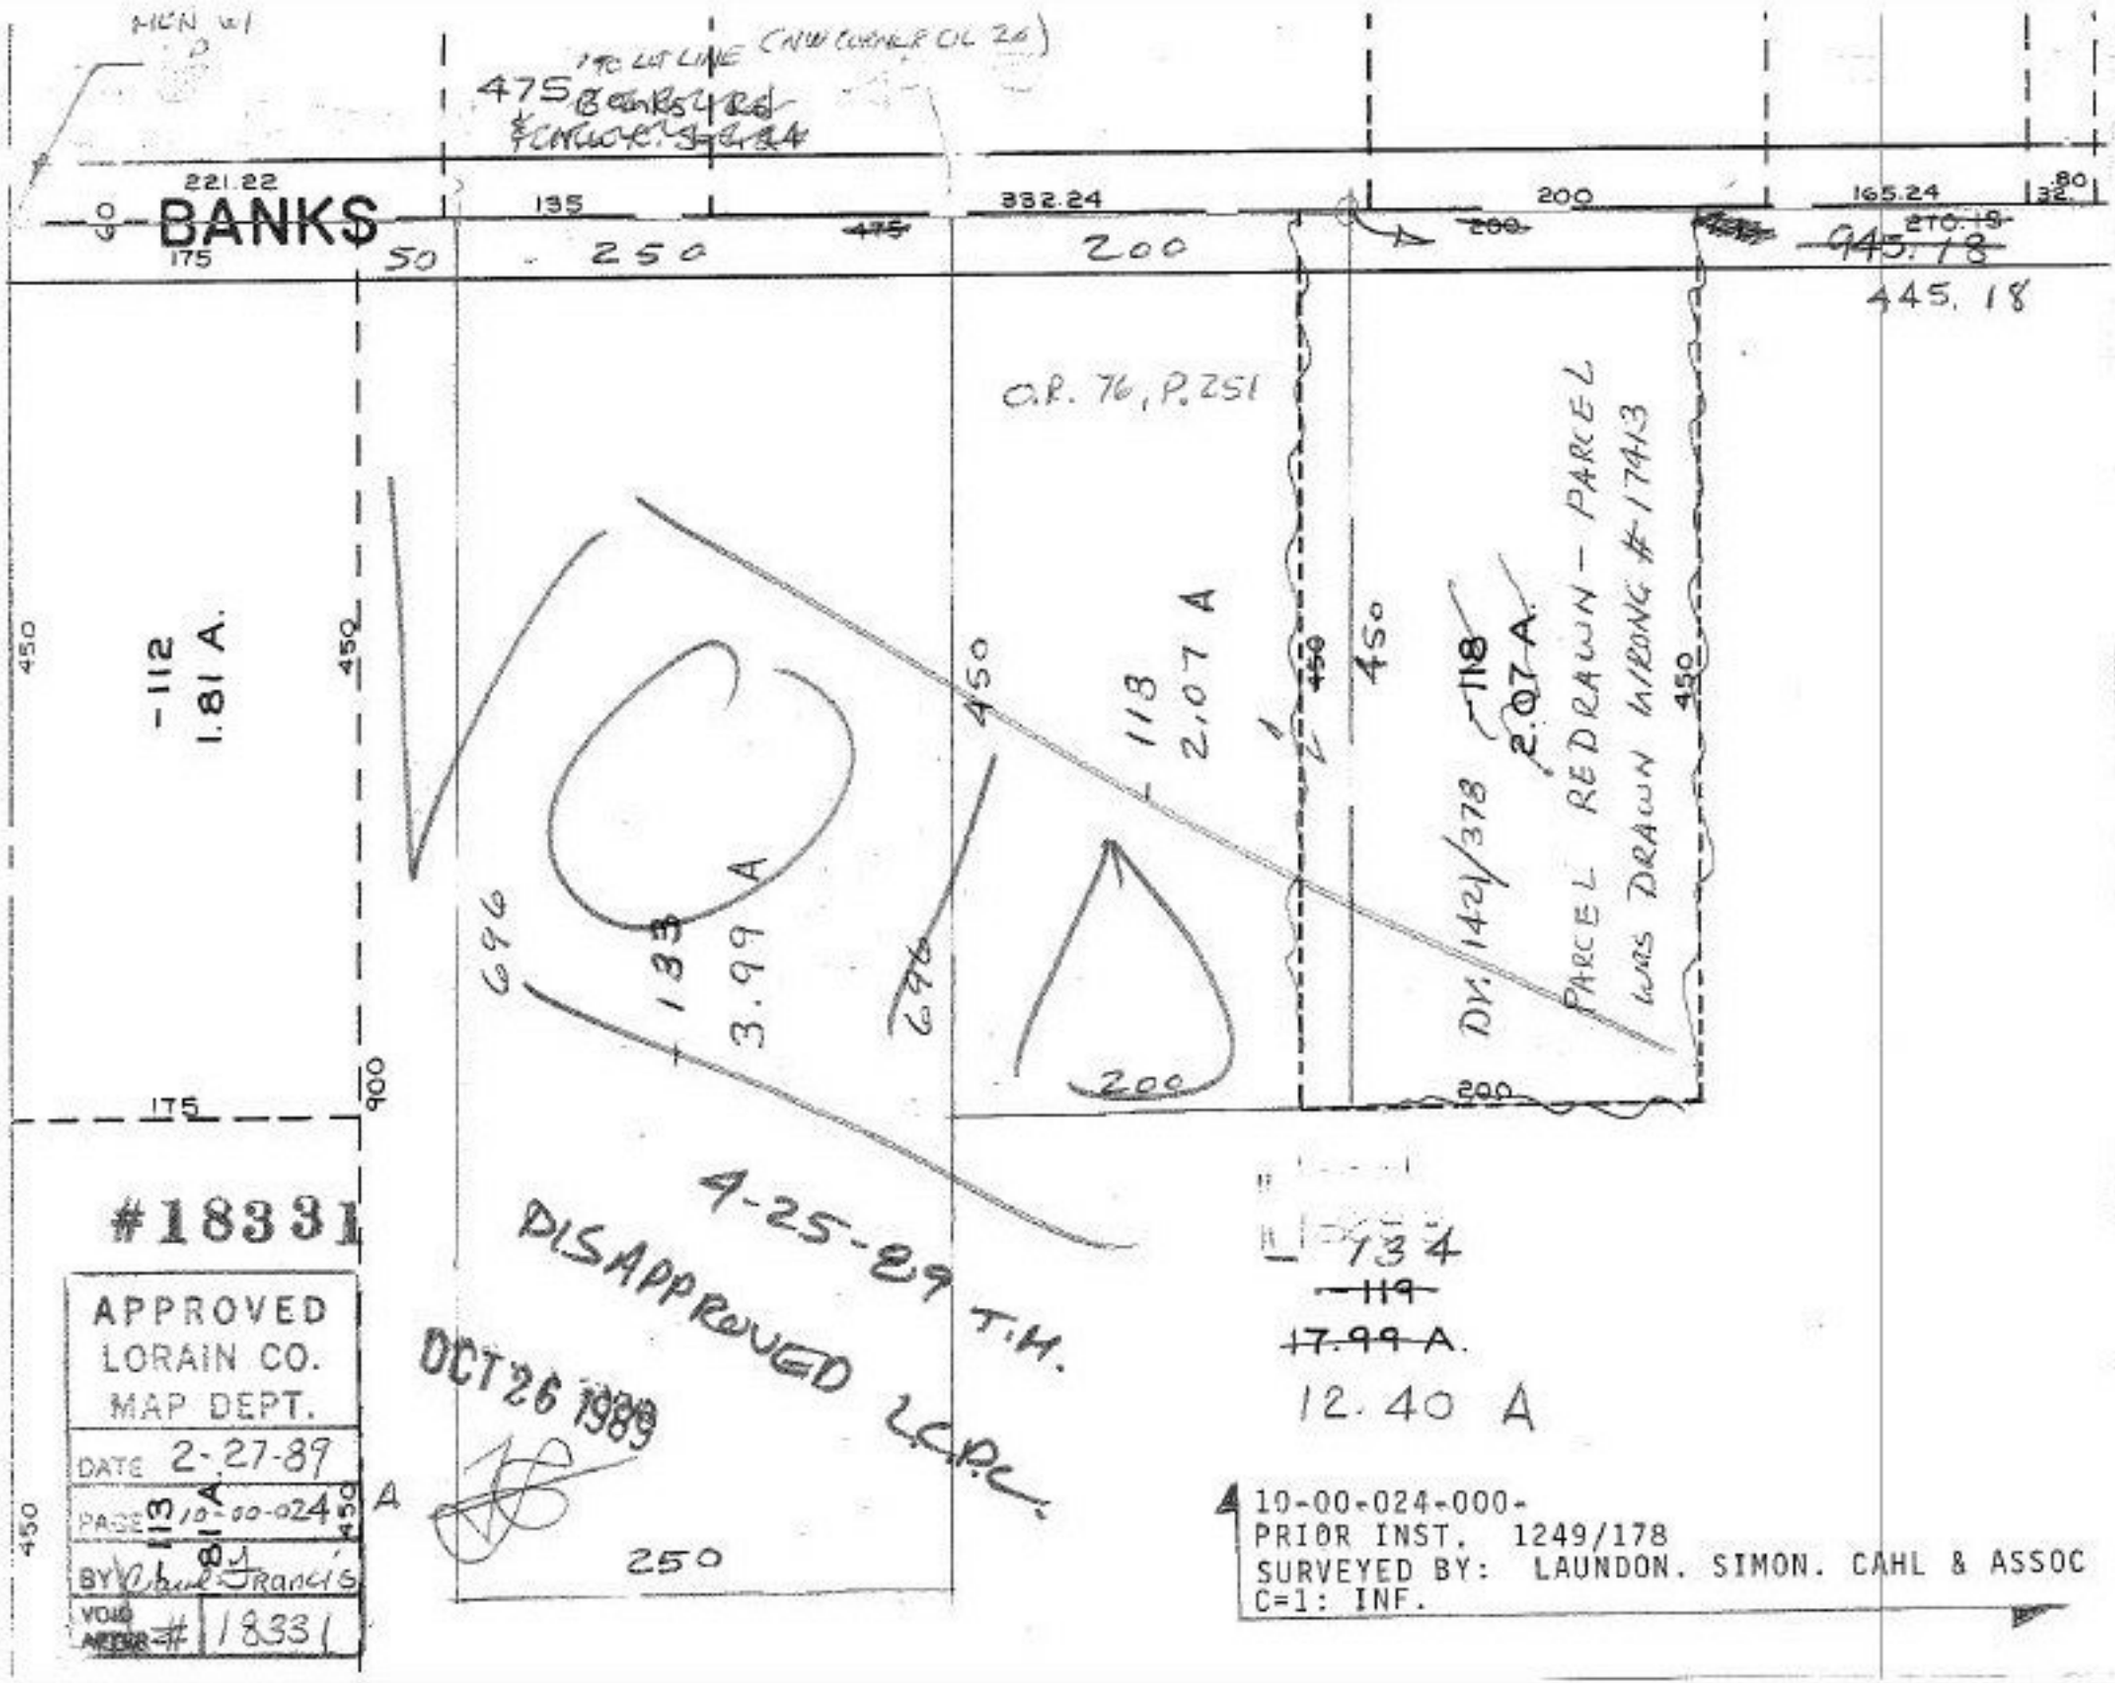

BANKS
221.22
135
332.24
200
165.24
175
50
250
200
945.18
445.18
O.R. 76, P.251
-112
1.81 A.
450
113
2.07 A
118
2.07 A.
PARCEL REDRAWN - PARCEL
WAS DRAWN WRONG #17413
DV. 1421/378
696
133
3.99 A
200
175
900
#18331
4-25-89 T.H.
DISAPPROVED L.C.P.C.
OCT 26 1989
134
~~119~~
~~17.99 A.~~
12.40 A
APPROVED
LORAIN CO.
MAP DEPT.
DATE 2-27-89
PAGE 113 10-00-024
BY Paul Francis
VOID AFTER # 18331
10-00-024-000-
PRIOR INST. 1249/178
SURVEYED BY: LAUNDON. SIMON. CAHL & ASSOC
C=1: INF.