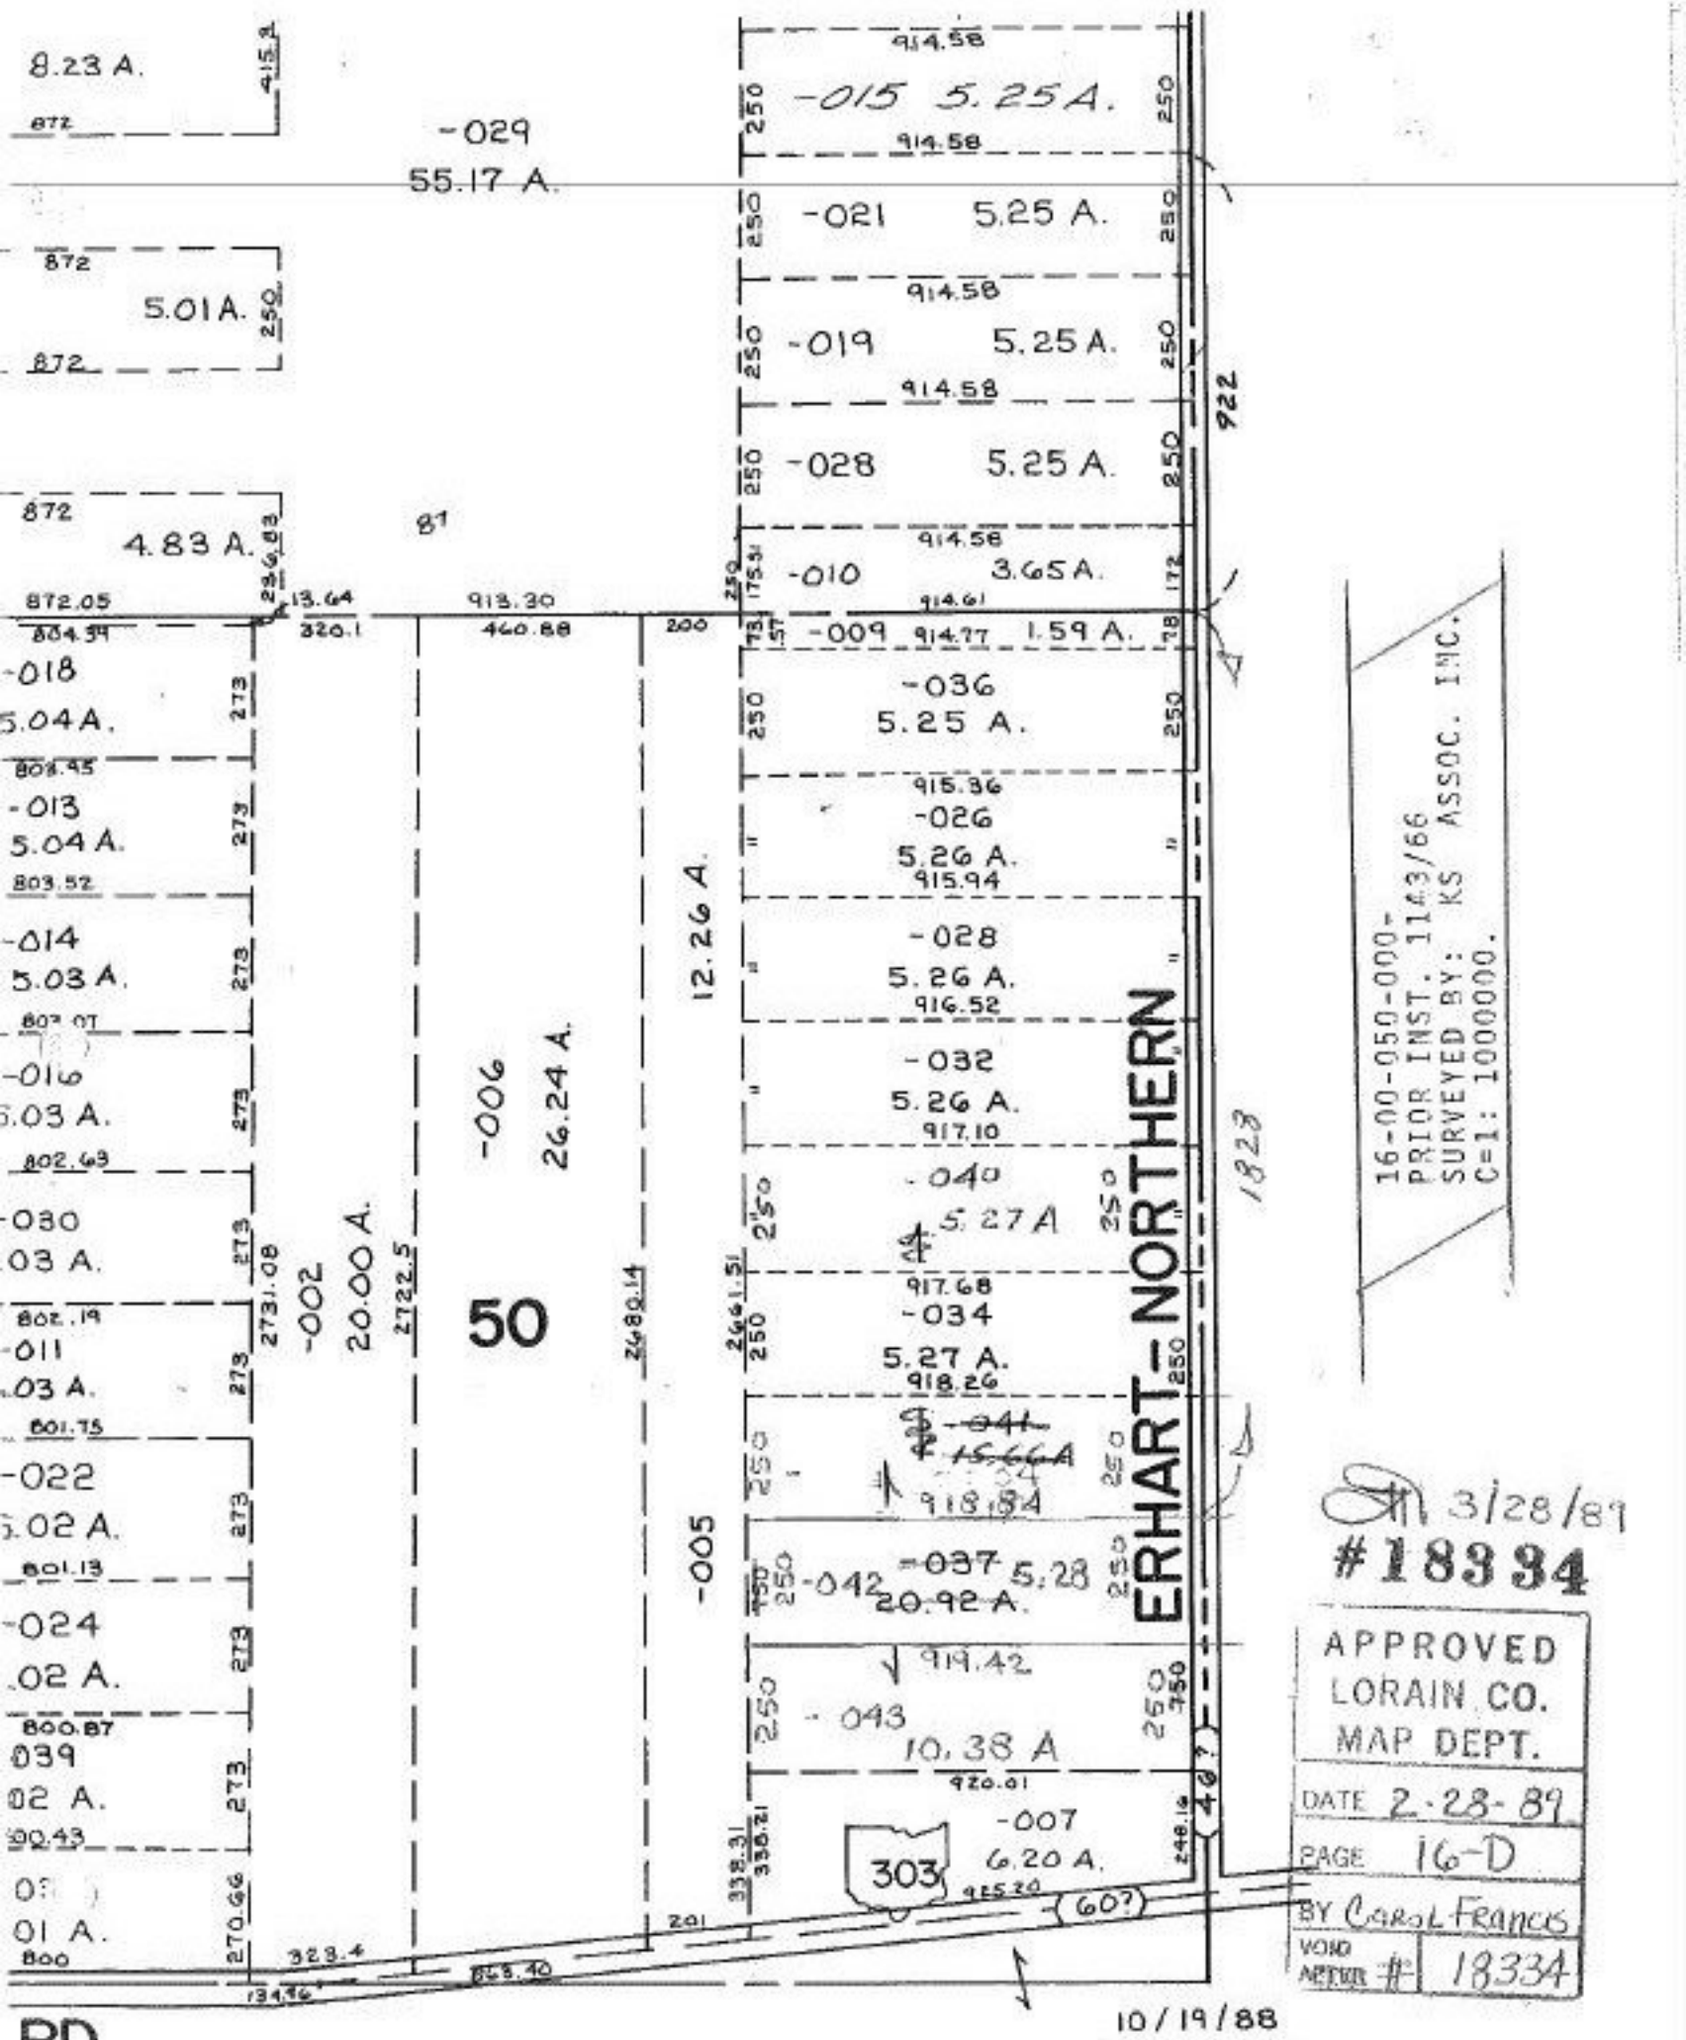

8.23 A.
-029
55.17 A.
5.01 A.
4.83 A.
-015 5.25 A.
-021 5.25 A.
-019 5.25 A.
-028 5.25 A.
-010 3.65 A.
-009 1.59 A.
-036
5.25 A.
-026
5.26 A.
-028
5.26 A.
-032
5.26 A.
-040
5.27 A
-034
5.27 A.
-041
15.66 A
-037 5.28
-042 20.92 A.
-043
10.38 A
-007
6.20 A.
-018
5.04 A.
-013
5.04 A.
-014
5.03 A.
-016
5.03 A.
-030
.03 A.
-011
.03 A.
-022
5.02 A.
-024
.02 A.
039
02 A.
01 A.
-002
20.00 A.
-006
26.24 A.
12.26 A.
-005
50
303
ERHART-NORTHERN
922
1828
16-00-050-000-
PRIOR INST. 1143/66
SURVEYED BY: KS ASSOC. INC.
C=1: 1000000.
3/28/89
#18334
APPROVED
LORAIN CO.
MAP DEPT.
DATE 2-28-89
PAGE 16-D
BY Carol Francis
VOID AFTER # 18334
RD.
10/19/88
REVISED