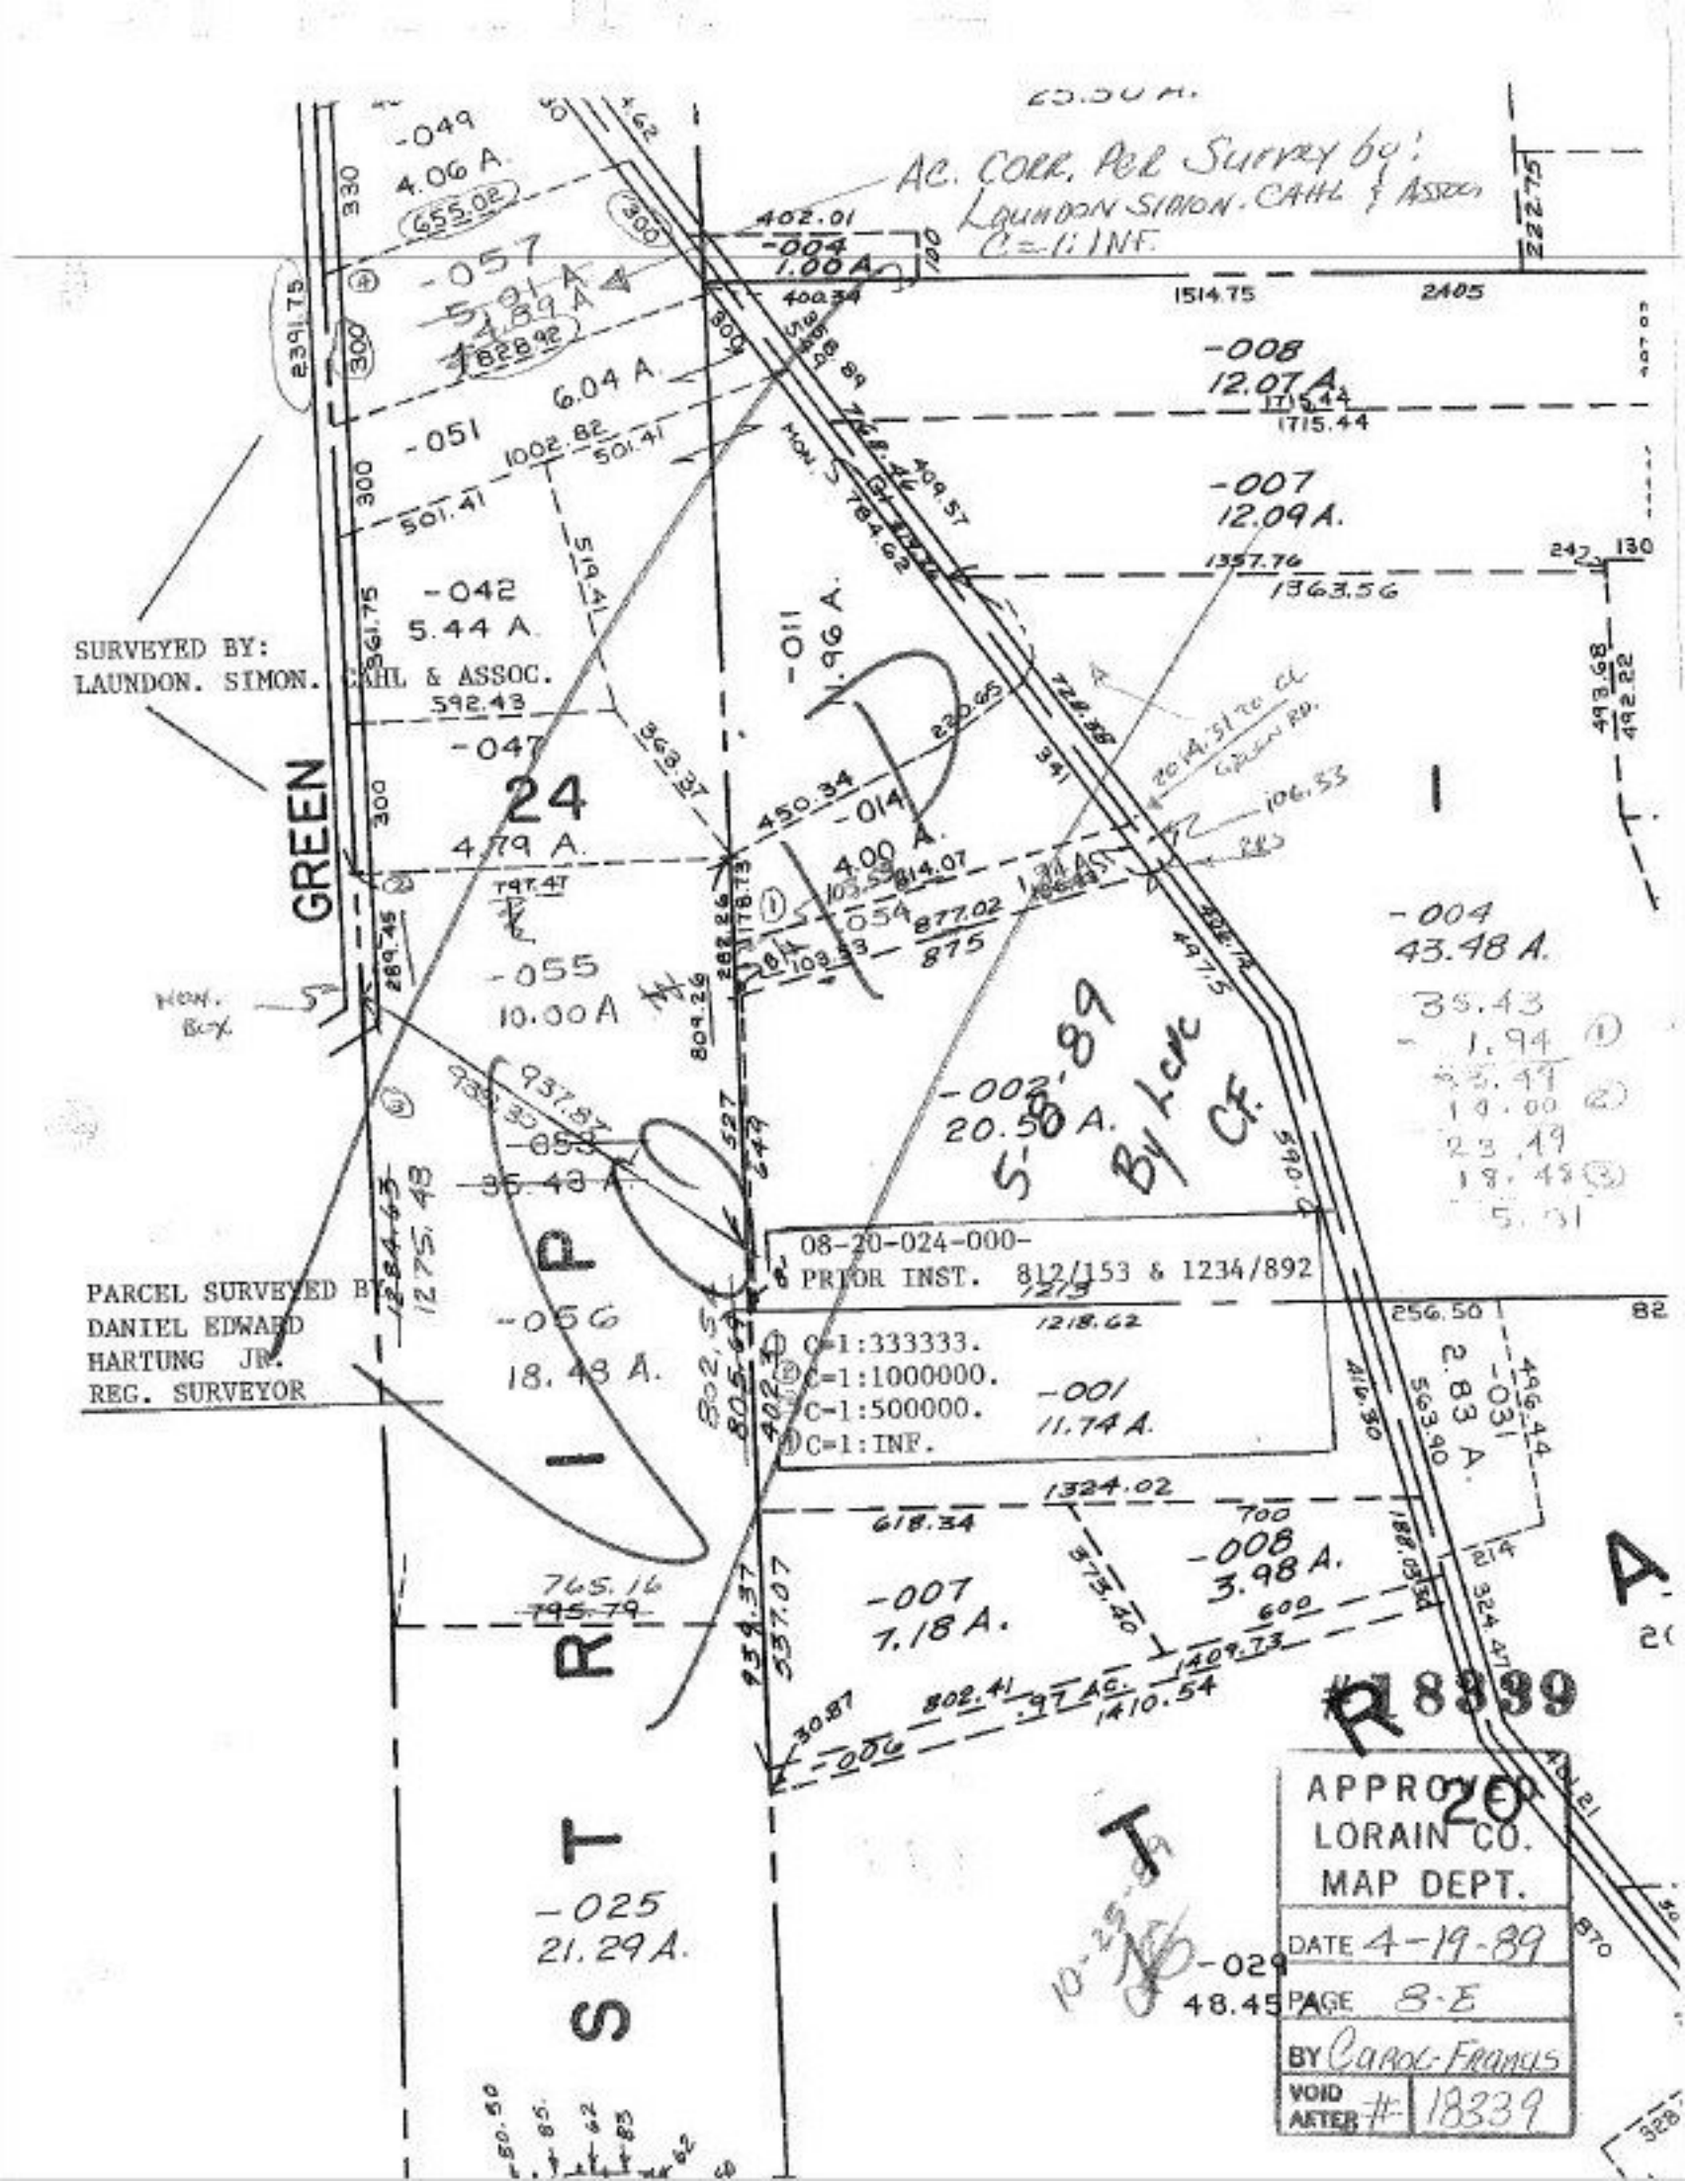

AC. CORR. PER SURVEY BY: LAUNDON SIMON. CAHL & ASSOC. C=1:INF.
SURVEYED BY: LAUNDON. SIMON. CAHL & ASSOC.
PARCEL SURVEYED BY DANIEL EDWARD HARTUNG JR. REG. SURVEYOR
GREEN
24
STRIP
-049 4.06 A.
-057 5.01 A.
-051 6.04 A.
-042 5.44 A.
-047 4.79 A.
-055 10.00 A
-053 35.43 A.
-056 18.48 A.
-025 21.29 A.
-011 1.96 A.
-014 4.00 A.
-054
-002 20.50 A.
-001 11.74 A.
-007 7.18 A.
-008 3.98 A.
-008 12.07 A.
-007 12.09 A.
-004 43.48 A.
-031 2.83 A.
-029 48.45 A.
-004 1.00 A.
08-20-024-000-
PRIOR INST. 812/153 & 1234/892
C=1:333333.
C=1:1000000.
C=1:500000.
C=1:INF.
5-8-89 By Lcpc CF.
#18339
APPROVED LORAIN CO. MAP DEPT.
DATE 4-19-89
PAGE 8-E
BY Carol-Francis
VOID AFTER # 18339