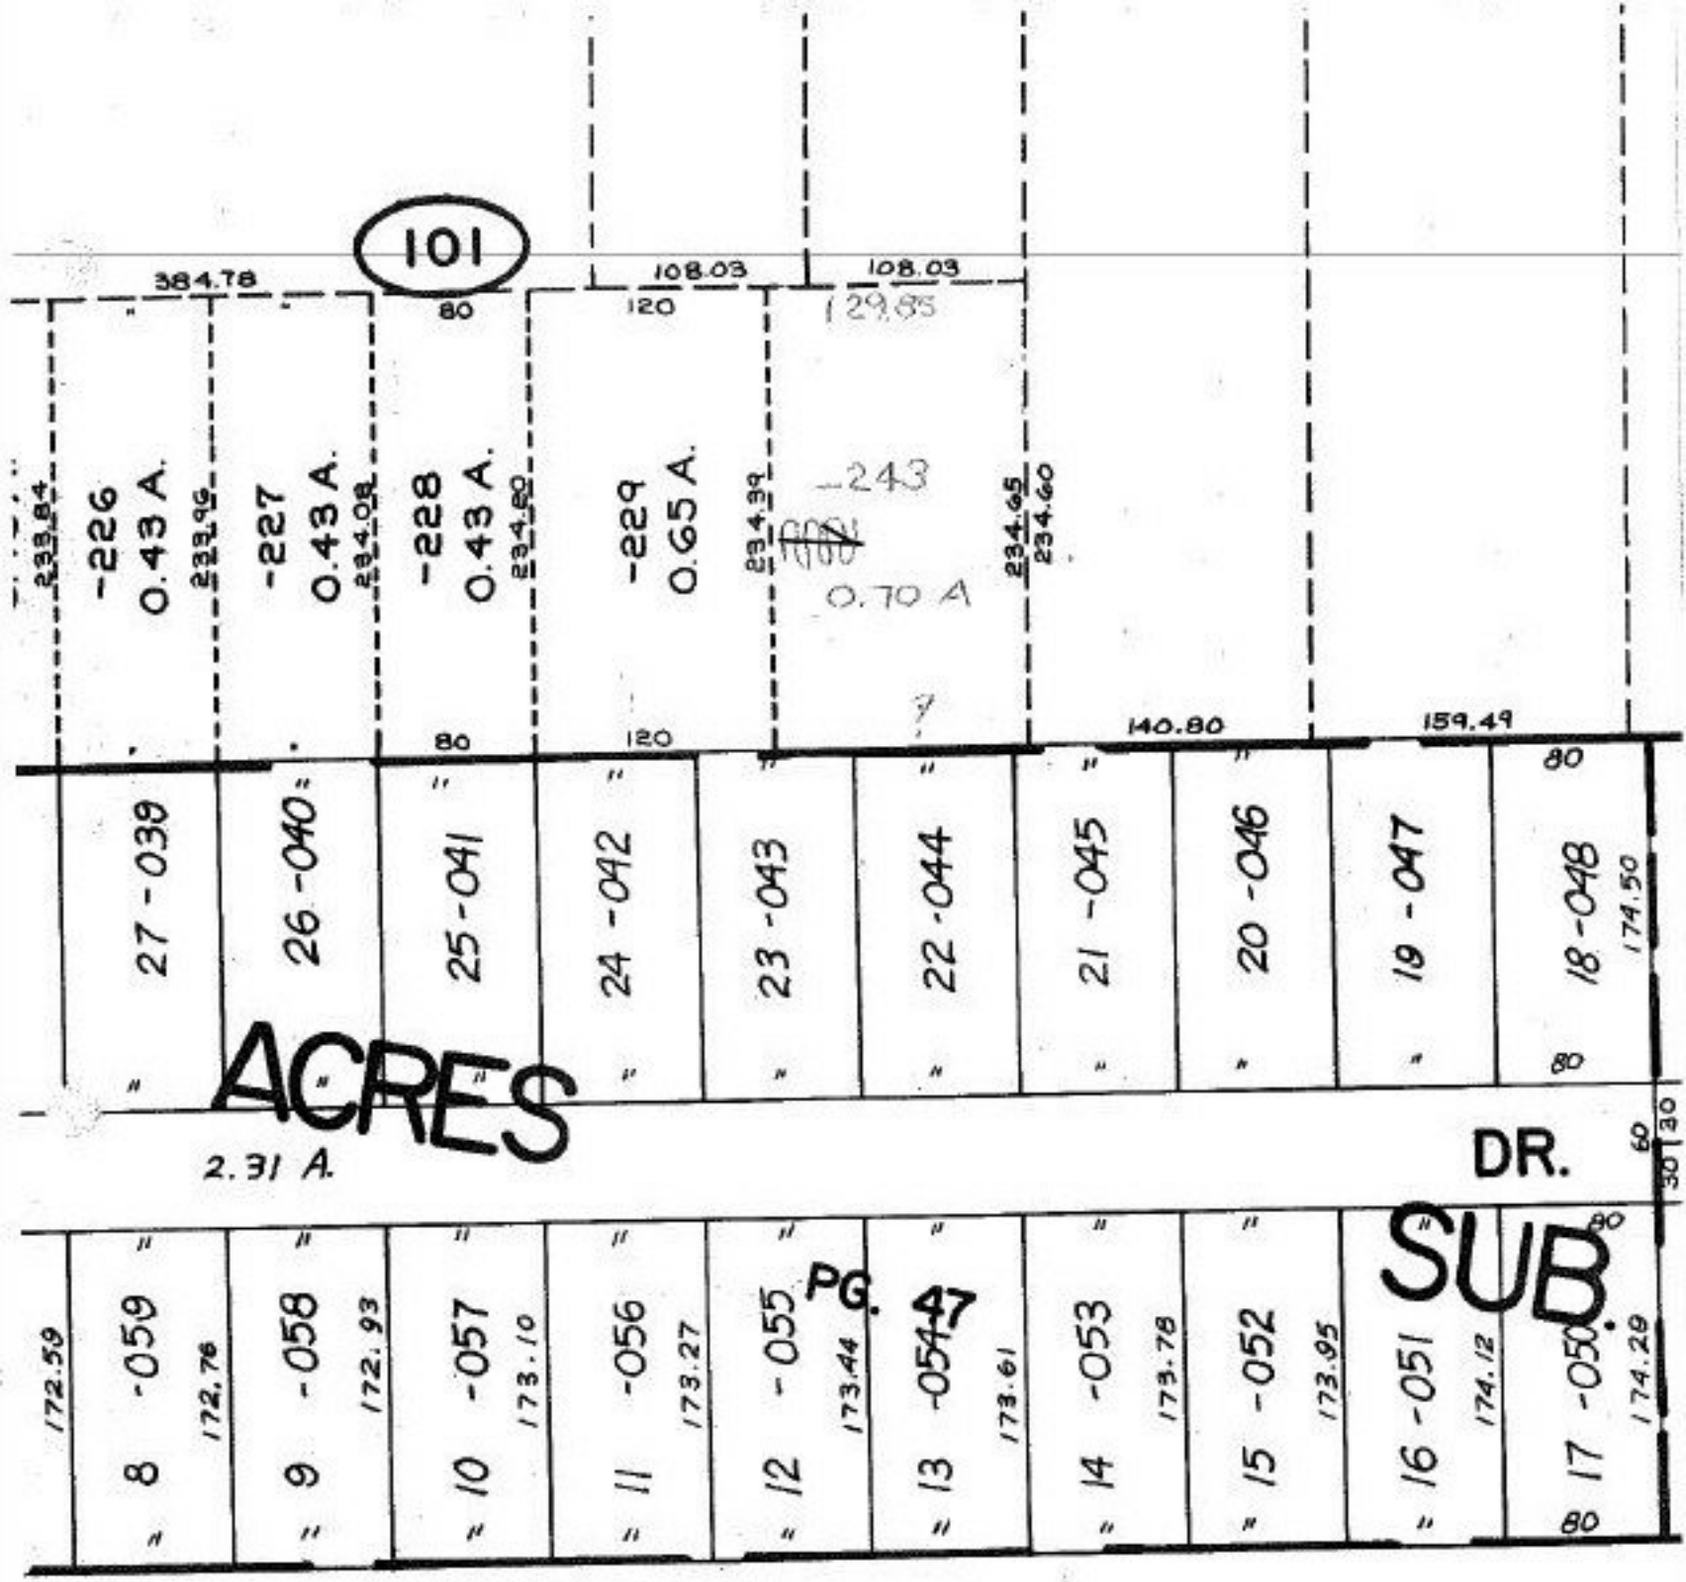

SEE 7-00-018-C

10/25/89
#18342

APPROVED
LORAIN CO.
MAP DEPT.
DATE 3-16-89
PAGE 7-00-018A
BY CAROL-FRANCIS
VOID AFTER TWP

RIDGEVILLE

#18342