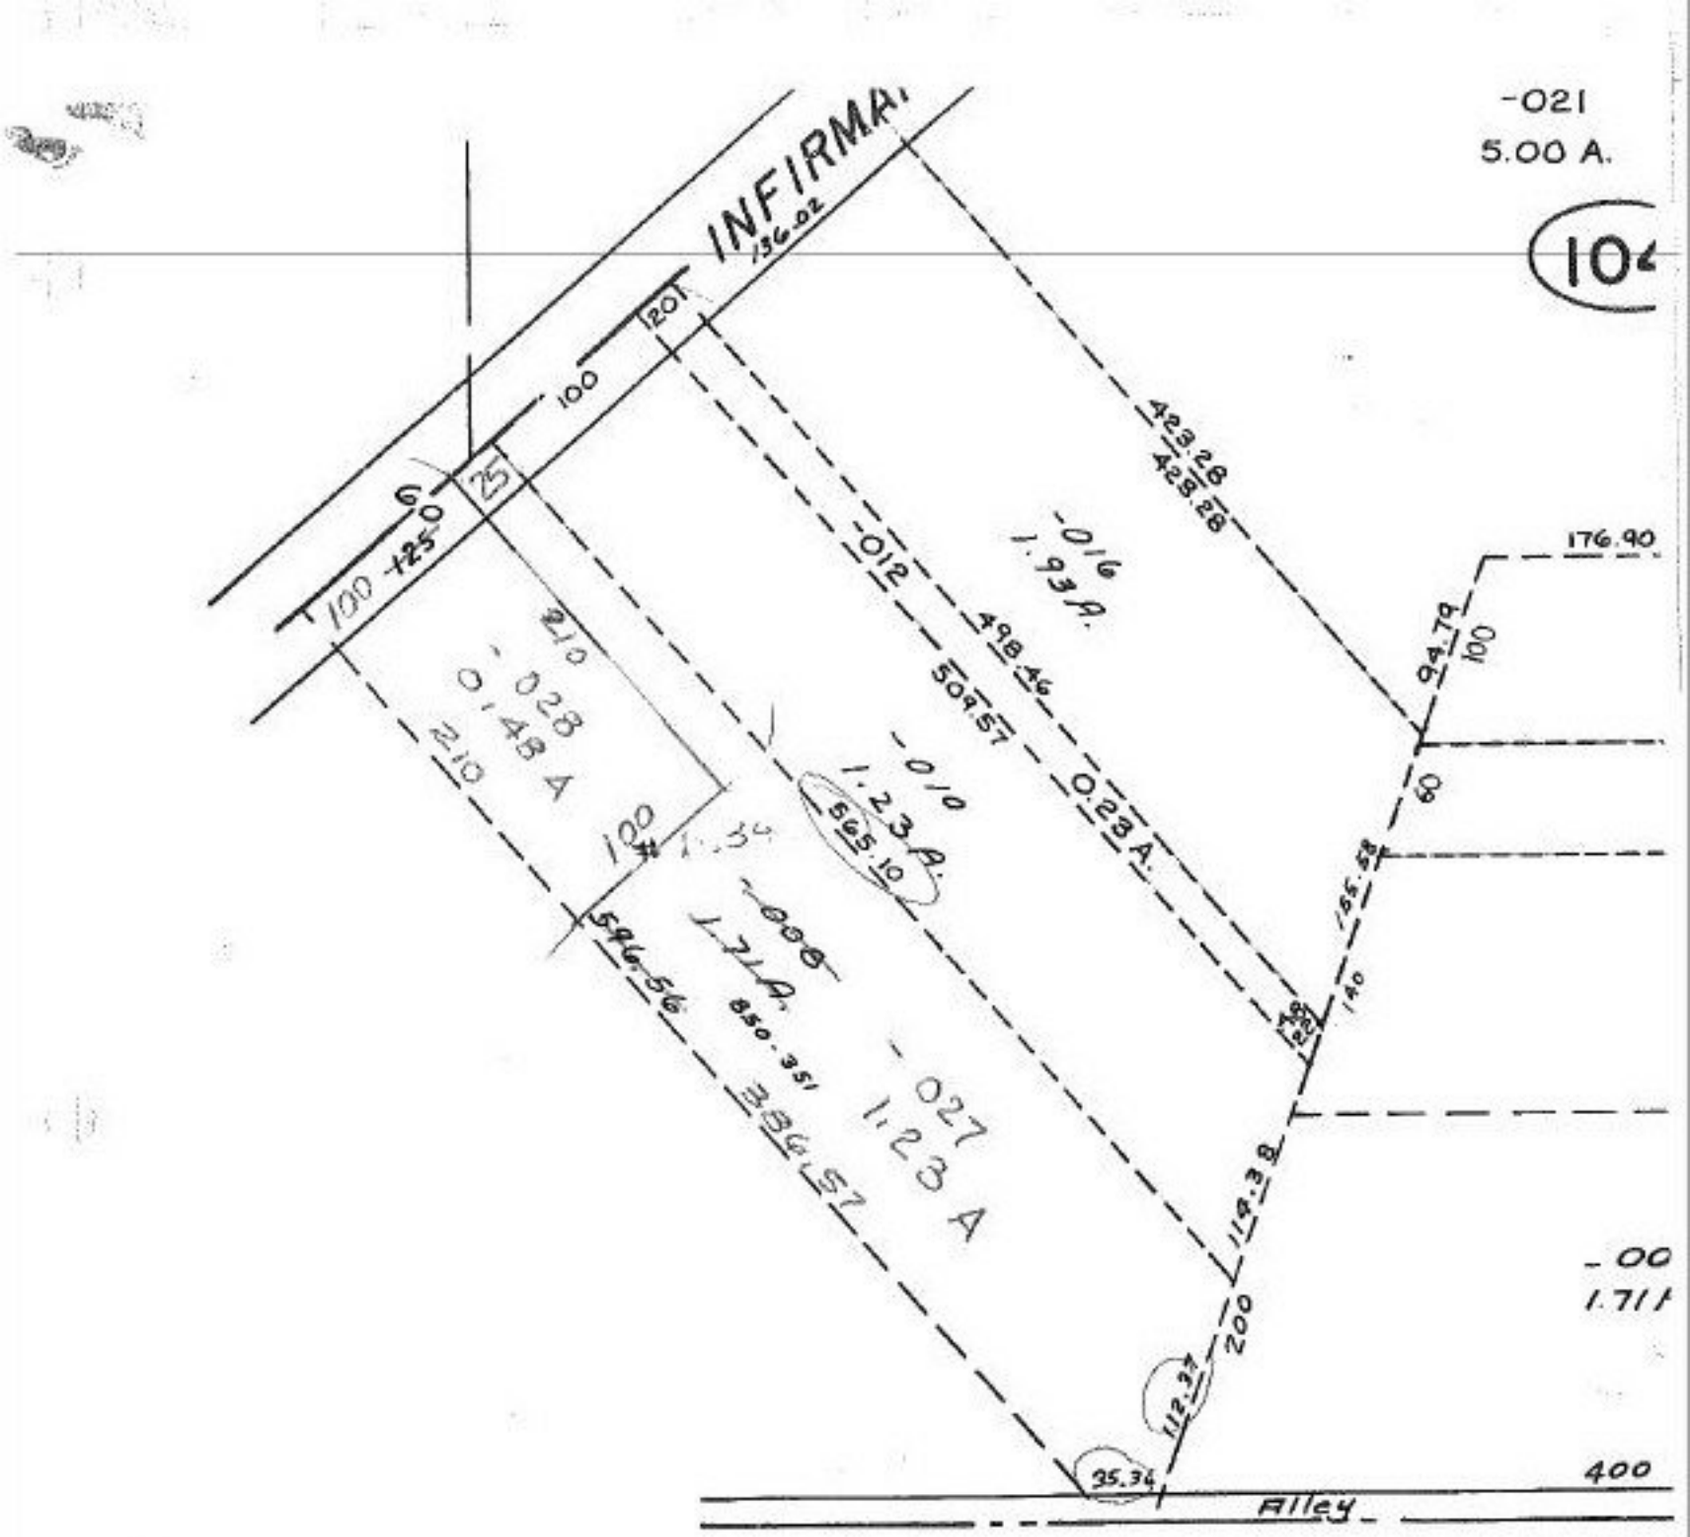

10/18/89

#18346

Copyright 1963
9/26/88

6 - 135

06-24-007-104-

PRIOR INST. 1178/780
SURVEYED BY: LAUNDON.
SIMON.
C=1:26315. CAHL & ASSOC.

ELYRIA

SCALE: 1" = 100'

APPROVED
LORAIN CO.
MAP DEPT.
DATE 3-8-89
PAGE 6-135
BY Carol Frances
WORD INDEX # 18346