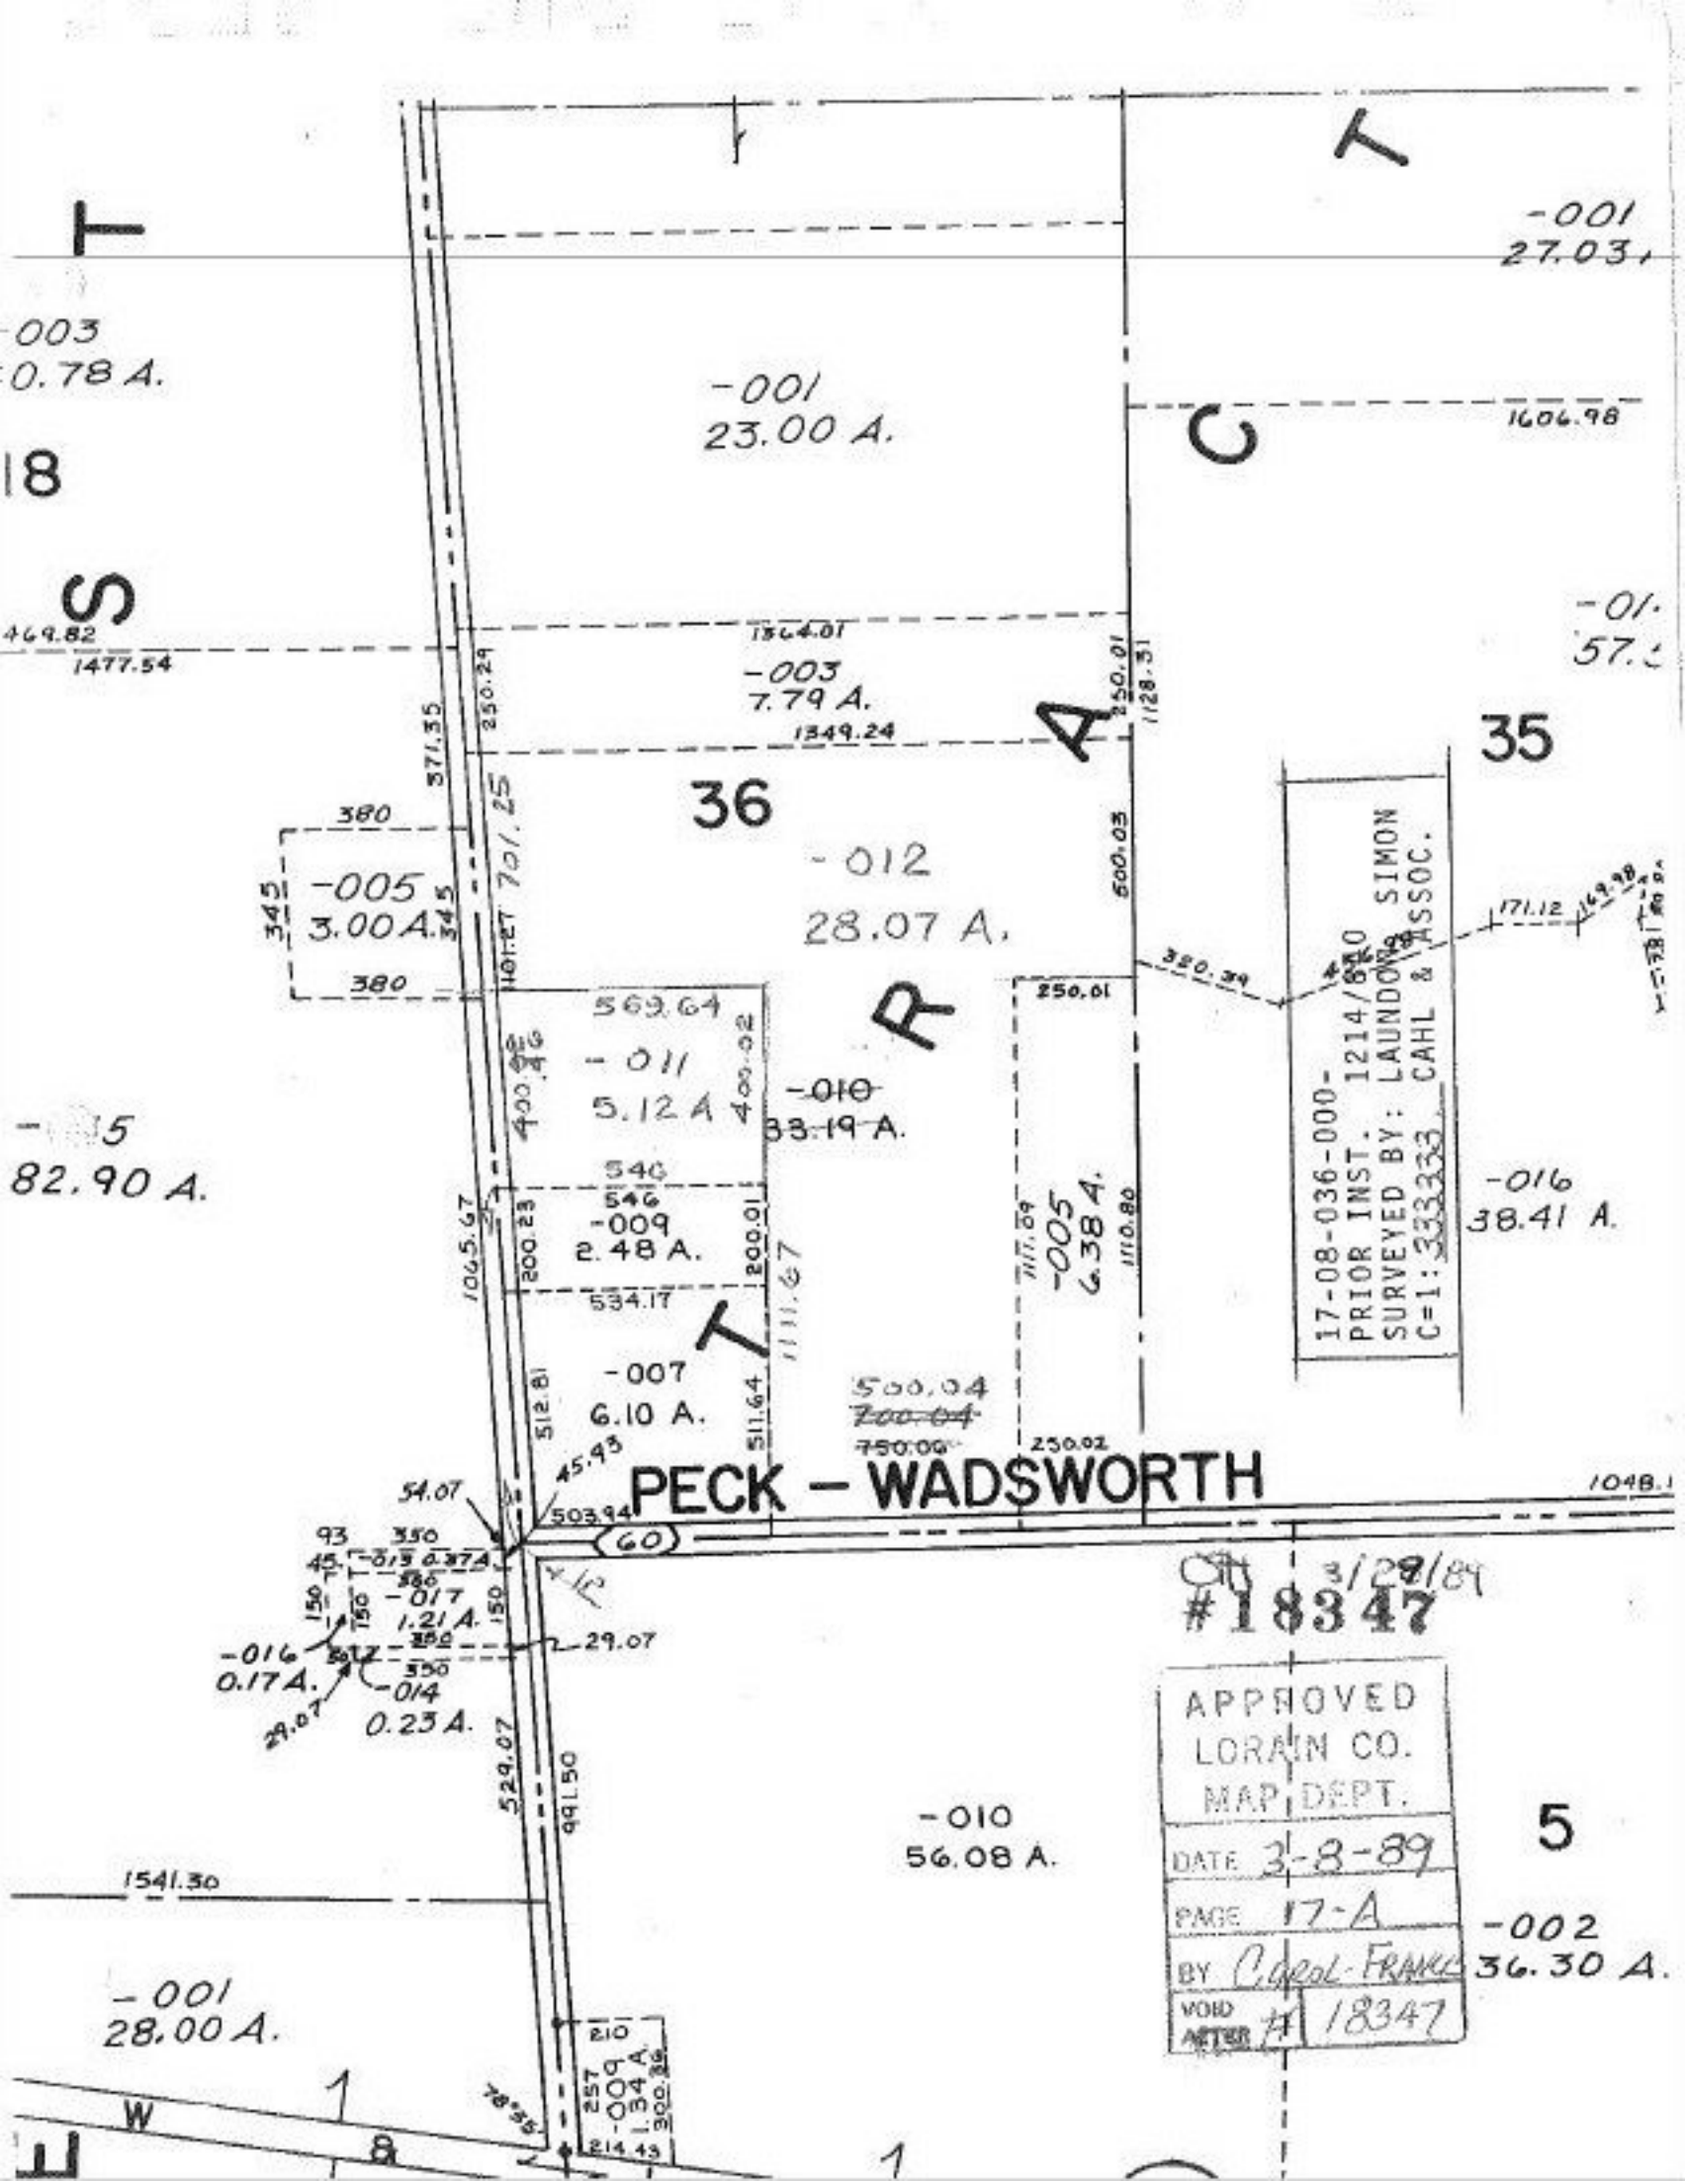

-001
27.03
-003
0.78 A.
-001
23.00 A.
1606.98
18
S
C
T
469.82
1477.54
1364.01
-003
7.79 A.
1349.24
35
36
-012
28.07 A.
-005
3.00 A.
380
345
701.25
569.64
-011
5.12 A
-010
33.19 A.
-005
6.38 A.
-016
38.41 A.
17-08-036-000-
PRIOR INST. 1214/810
SURVEYED BY: LAUNDON, SIMON
C=1: 333333 CAHL & ASSOC.
82.90 A.
546
-009
2.48 A.
534.17
-007
6.10 A.
500.04
750.00
250.02
PECK - WADSWORTH
1048.1
54.07
503.94
60
-017
1.21 A.
-016
0.17 A.
-014
0.23 A.
29.07
529.07
991.50
-010
56.08 A.
5
1541.30
-002
36.30 A.
-001
28.00 A.
-009
1.34 A.
214.43
#18347
3/28/89
APPROVED
LORAIN CO.
MAP DEPT.
DATE 3-8-89
PAGE 17-A
BY Carol Franke
VOID AFTER # 18347