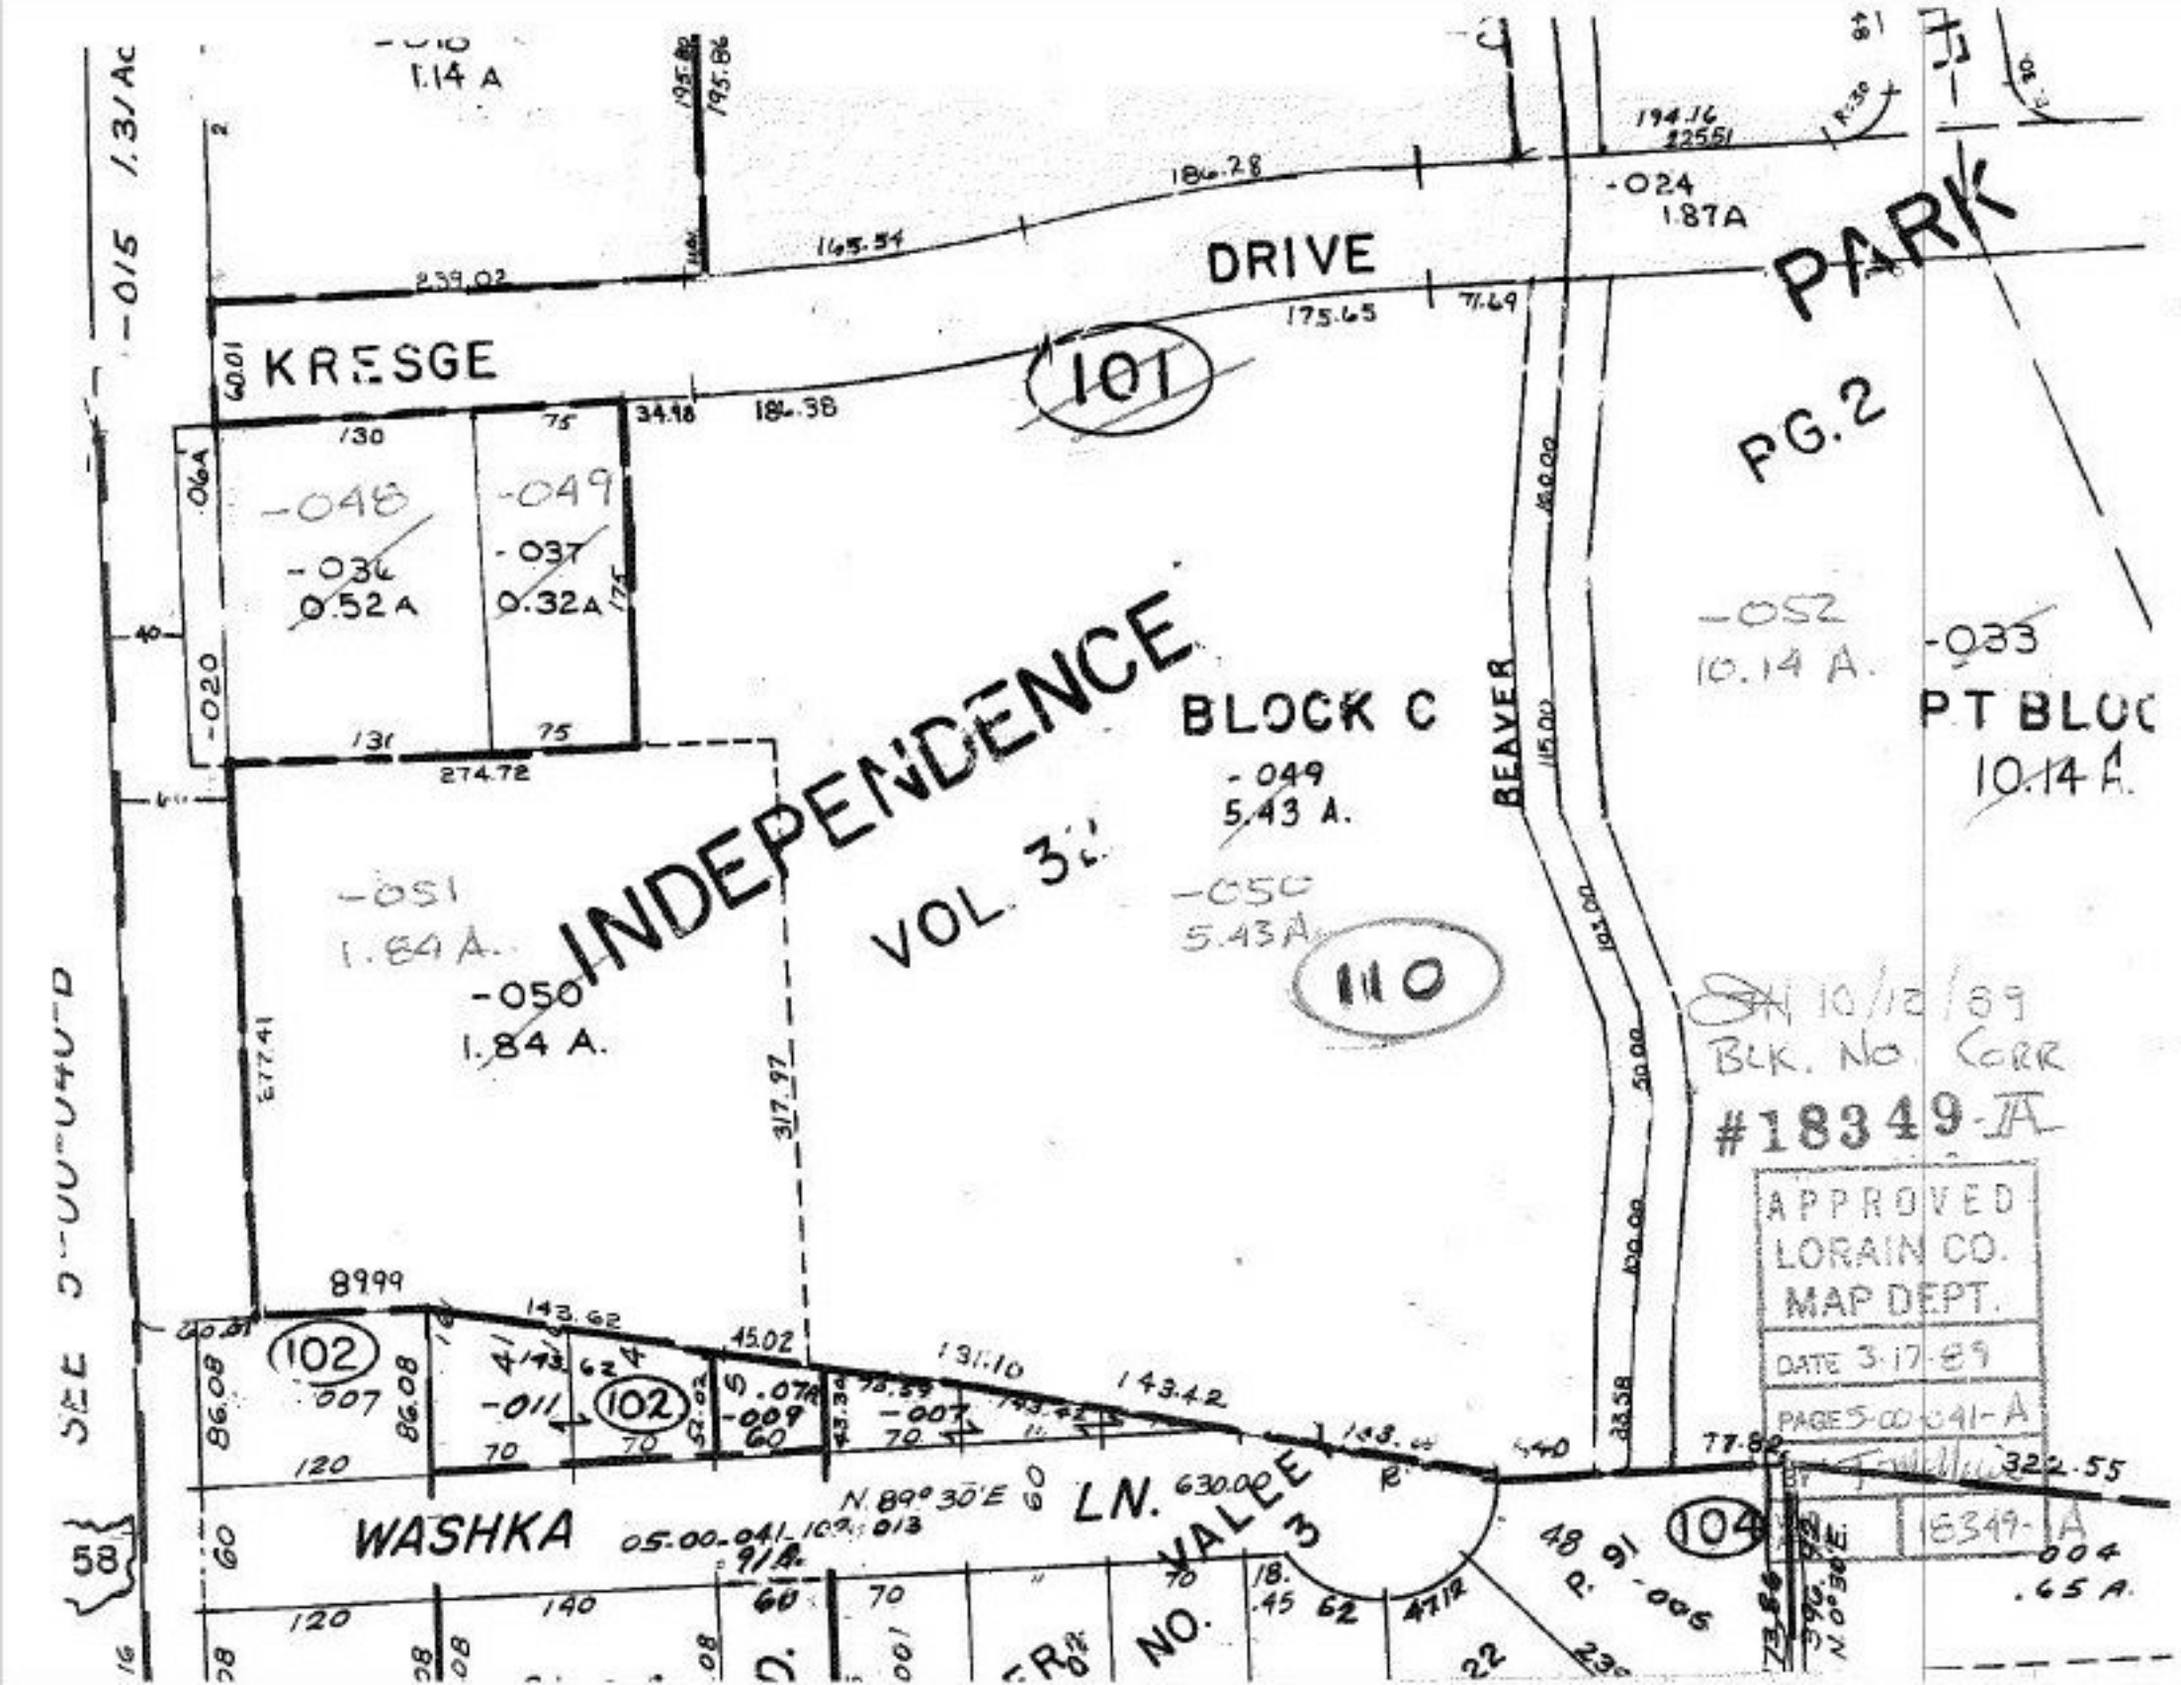

KRESGE
DRIVE
PARK
PG. 2
INDEPENDENCE
VOL. 3
BLOCK C
-049
5.43 A.
-050
5.43 A.
110
BEAVER
-052
10.14 A.
-033
PT BLOC
10.14 A.
-048
-036
0.52 A
-049
-037
0.32 A
-051
1.84 A.
-050
1.84 A.
101
102
104
WASHKA
LN.
VALLEY
NO. 3
-024
1.87A
1.14 A
10/12/89
BLK. NO. CORR
#18349-A
APPROVED
LORAIN CO.
MAP DEPT.
DATE 3-17-89
PAGE 5-00-041-A
18349-A