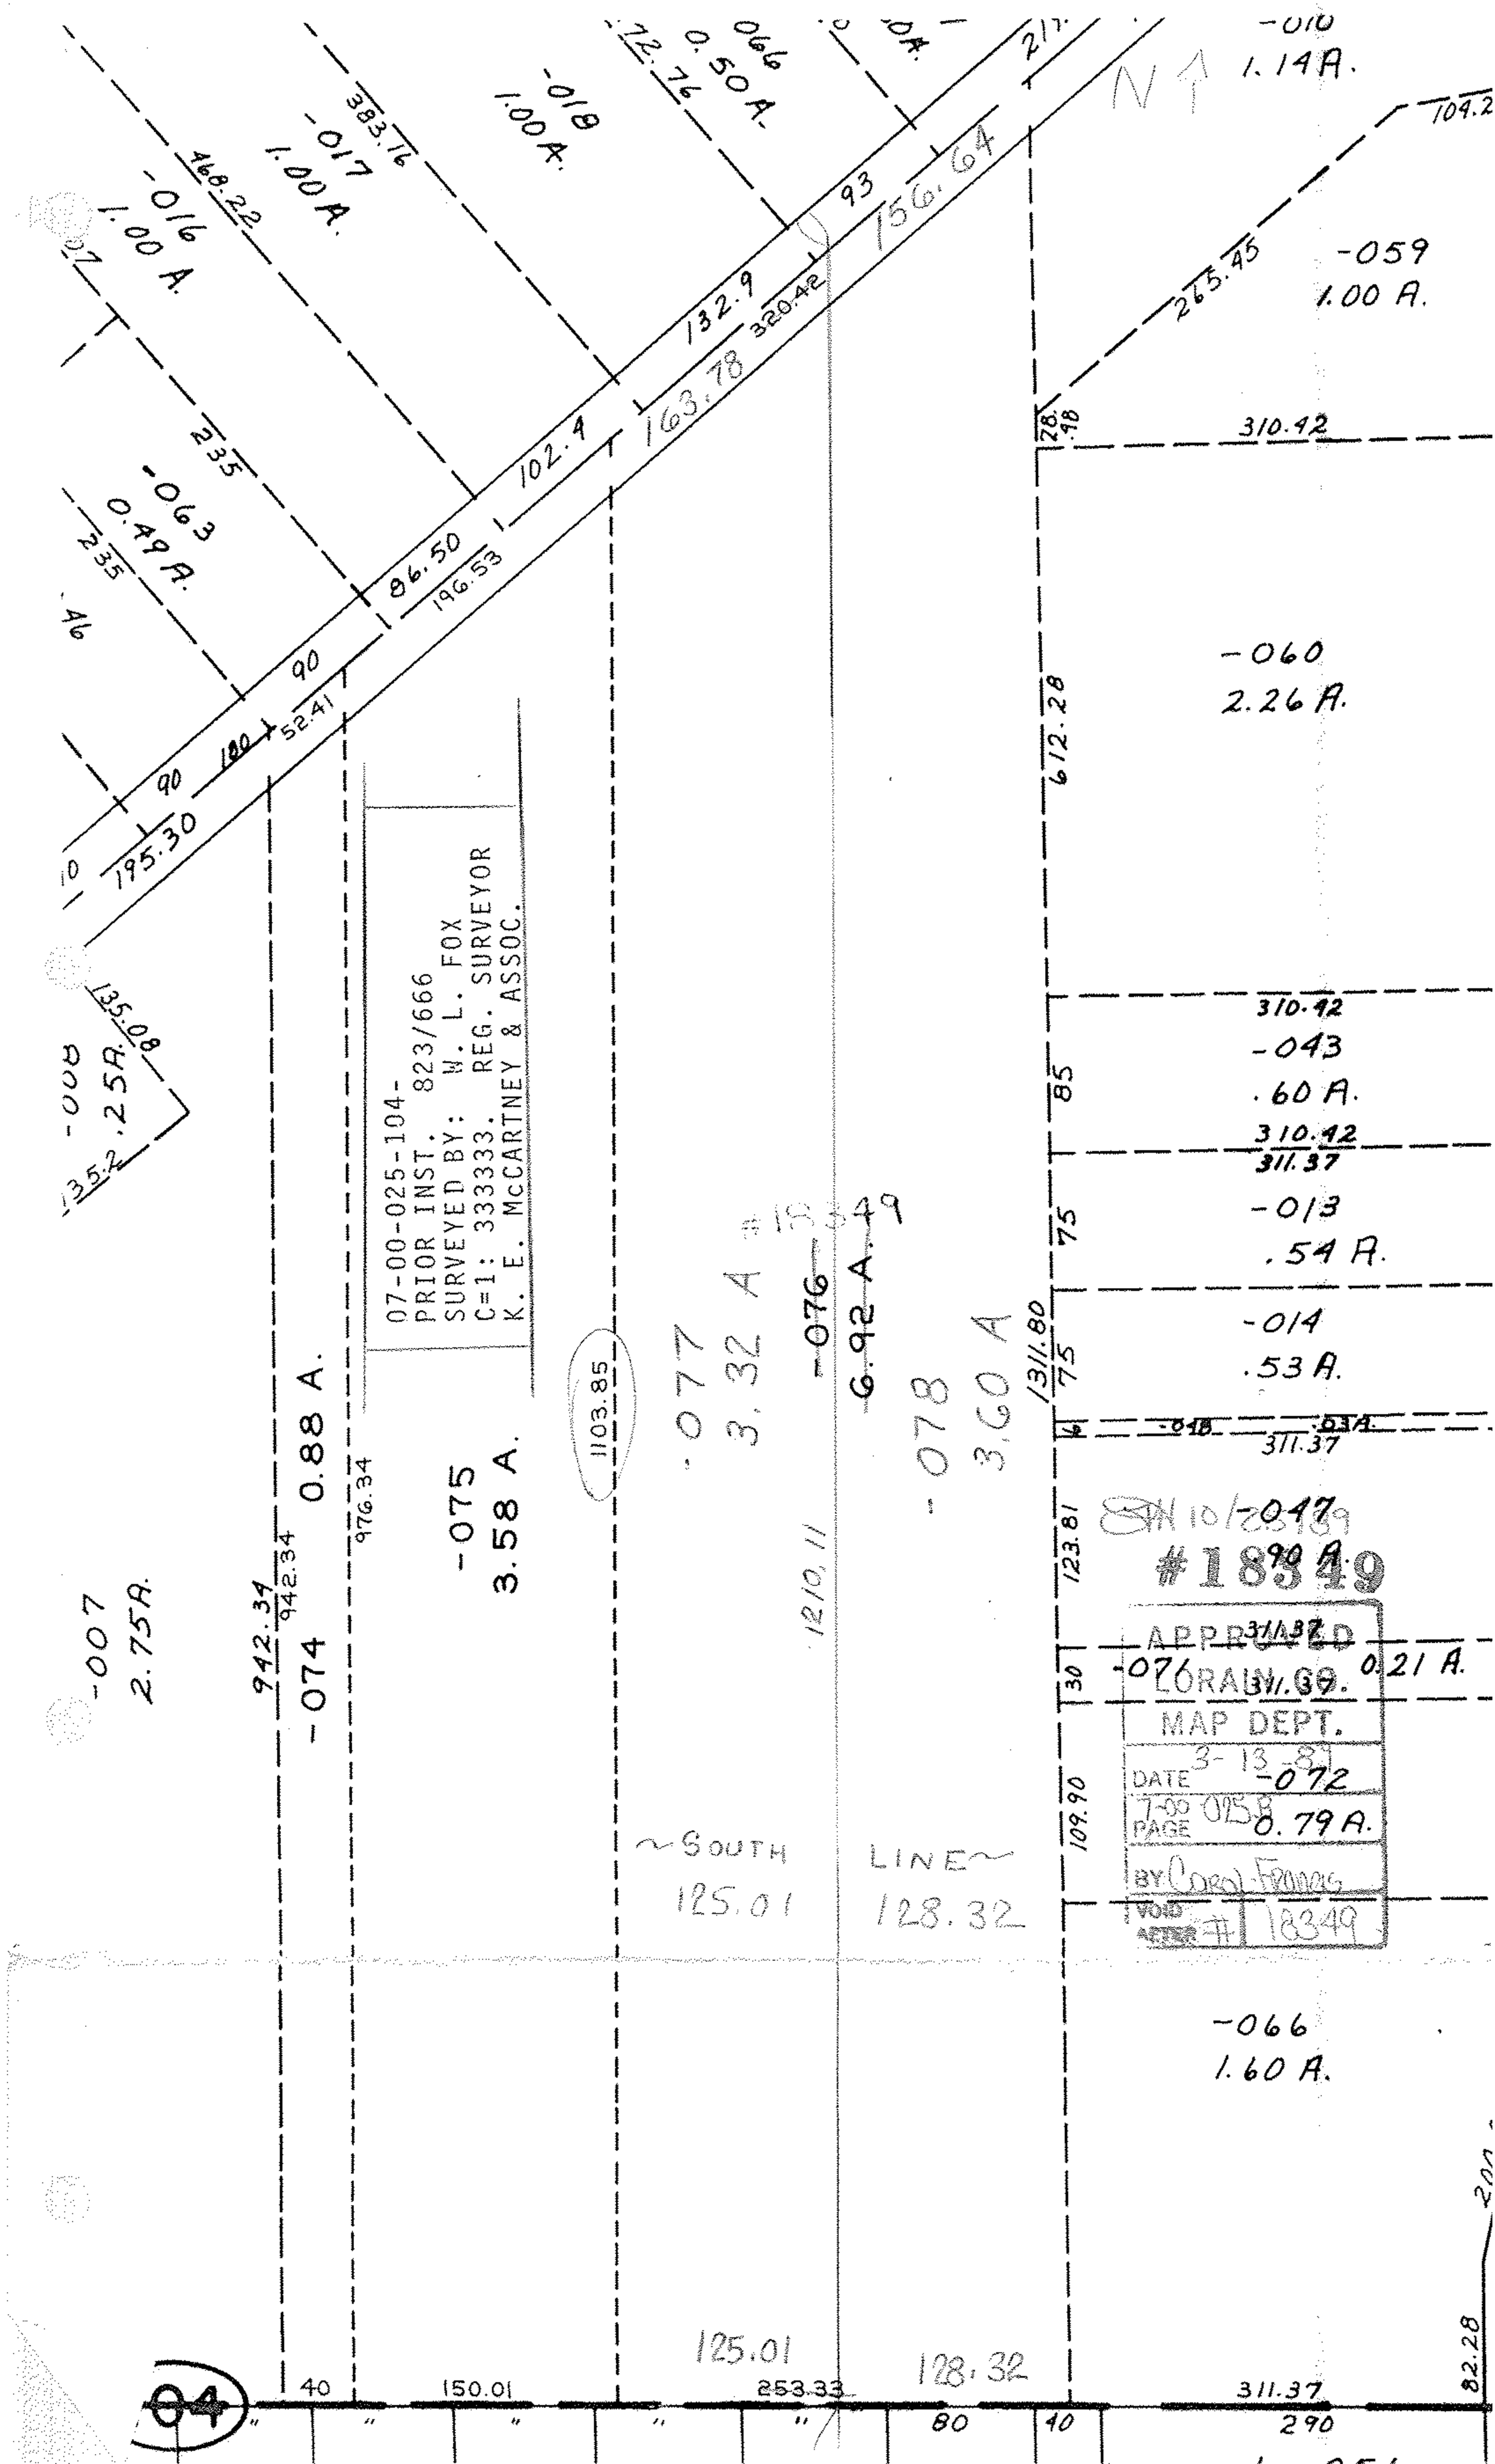
-010
1.14A.
-018
1.00A.
-017
1.00A.
-016
1.00A.
-063
0.49A.
-059
1.00 A.
-060
2.26 A.
-066
1.60 A.
-043
.60 A.
-013
.54 A.
-014
.53 A.
-047
.21 A.
-072
0.79 A.
-076
6.92 A.
-075
3.58 A.
-074
0.88 A.
-007
2.75A.
-008
.25A.
07-00-025-104-
PRIOR INST. 823/666
SURVEYED BY: W. L. FOX
C=1: 333333. REG. SURVEYOR
K. E. McCARTNEY & ASSOC.
~SOUTH LINE~
125.01
128.32
#18349
APPROVED
MAP DEPT.
DATE 3-13-81
PAGE
BY
VOID AFTER
04