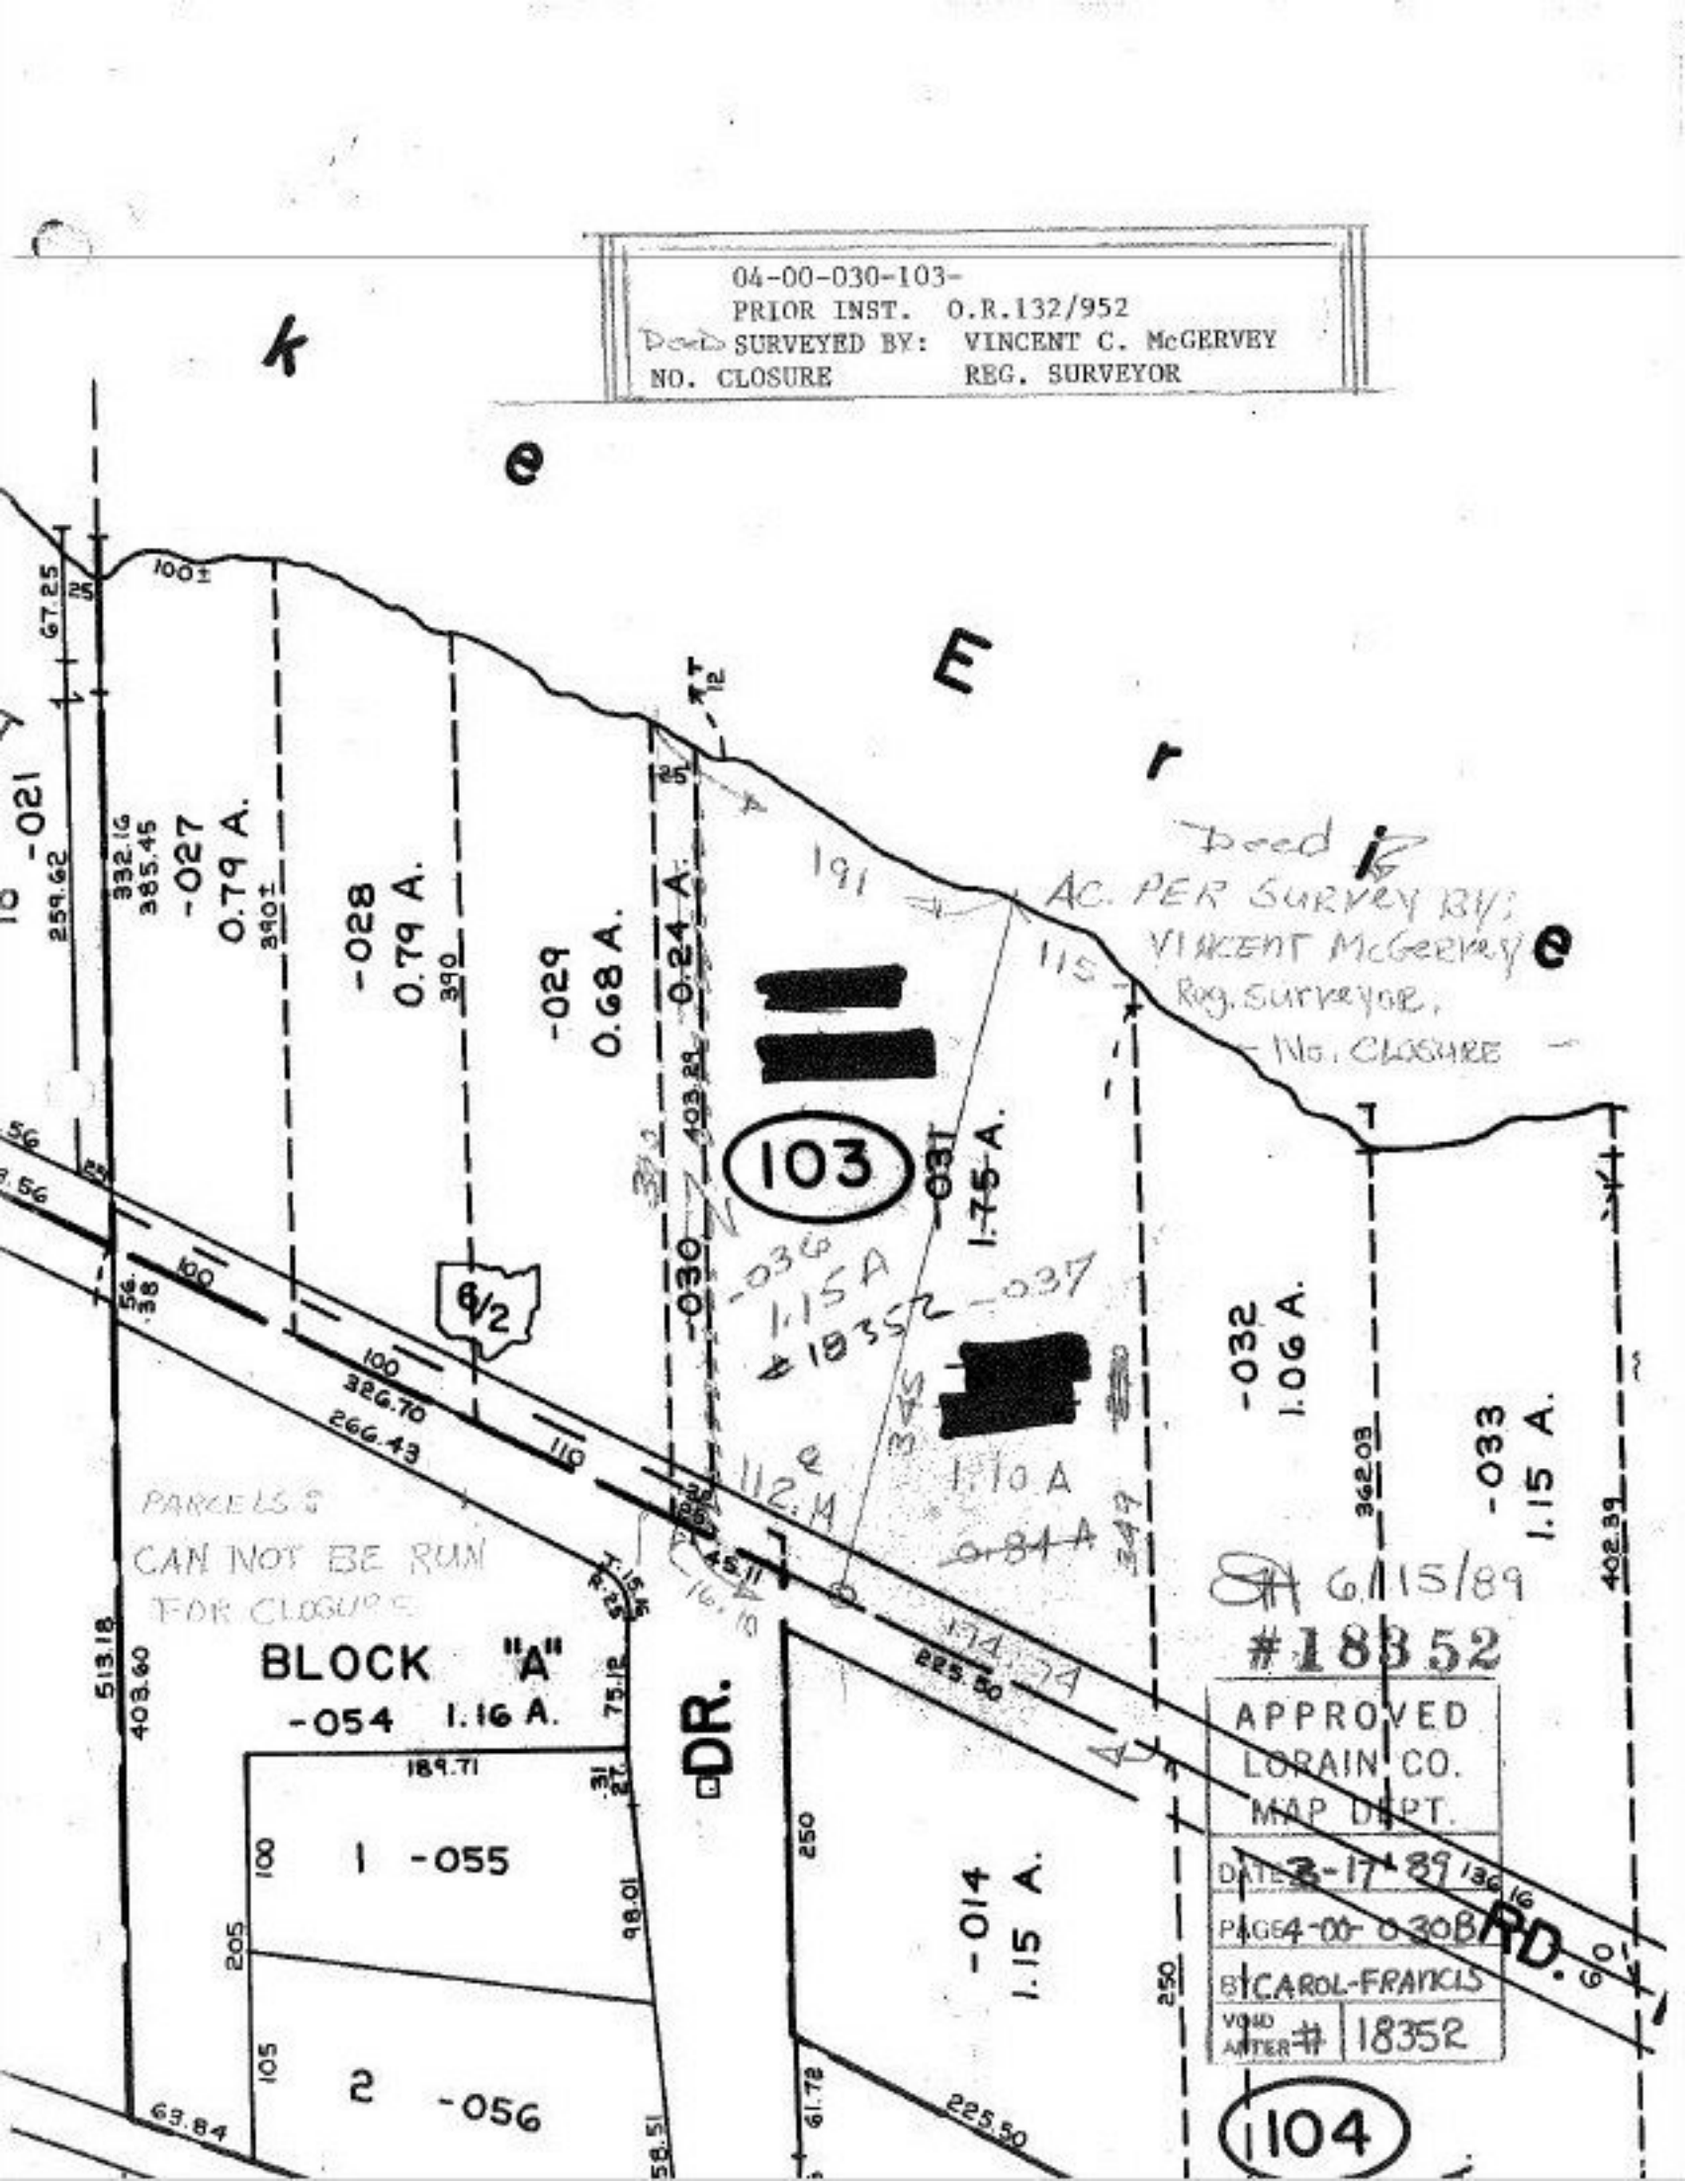
04-00-030-103-
PRIOR INST. O.R.132/952
SURVEYED BY: VINCENT C. McGERVEY
NO. CLOSURE REG. SURVEYOR
Deed is
AC. PER SURVEY BY:
VINCENT McGERVEY
Reg. Surveyor,
No. CLOSURE
-021
-027
0.79 A.
-028
0.79 A.
-029
0.68 A.
0.24 A.
-030
1.15 A.
#18352
-031
1.75 A.
-032
1.06 A.
-033
1.15 A.
103
104
1.10 A
.81 A
PARCELS 3
CAN NOT BE RUN
FOR CLOSURE
BLOCK "A"
-054 1.16 A.
1 -055
2 -056
-014
1.15 A.
DR.
RD.
6/15/89
#18352
APPROVED
LORAIN CO.
MAP DEPT.
DATE 3-17-89
PAGE 4-00-030
BY CAROL-FRANCIS
VOID AFTER # 18352