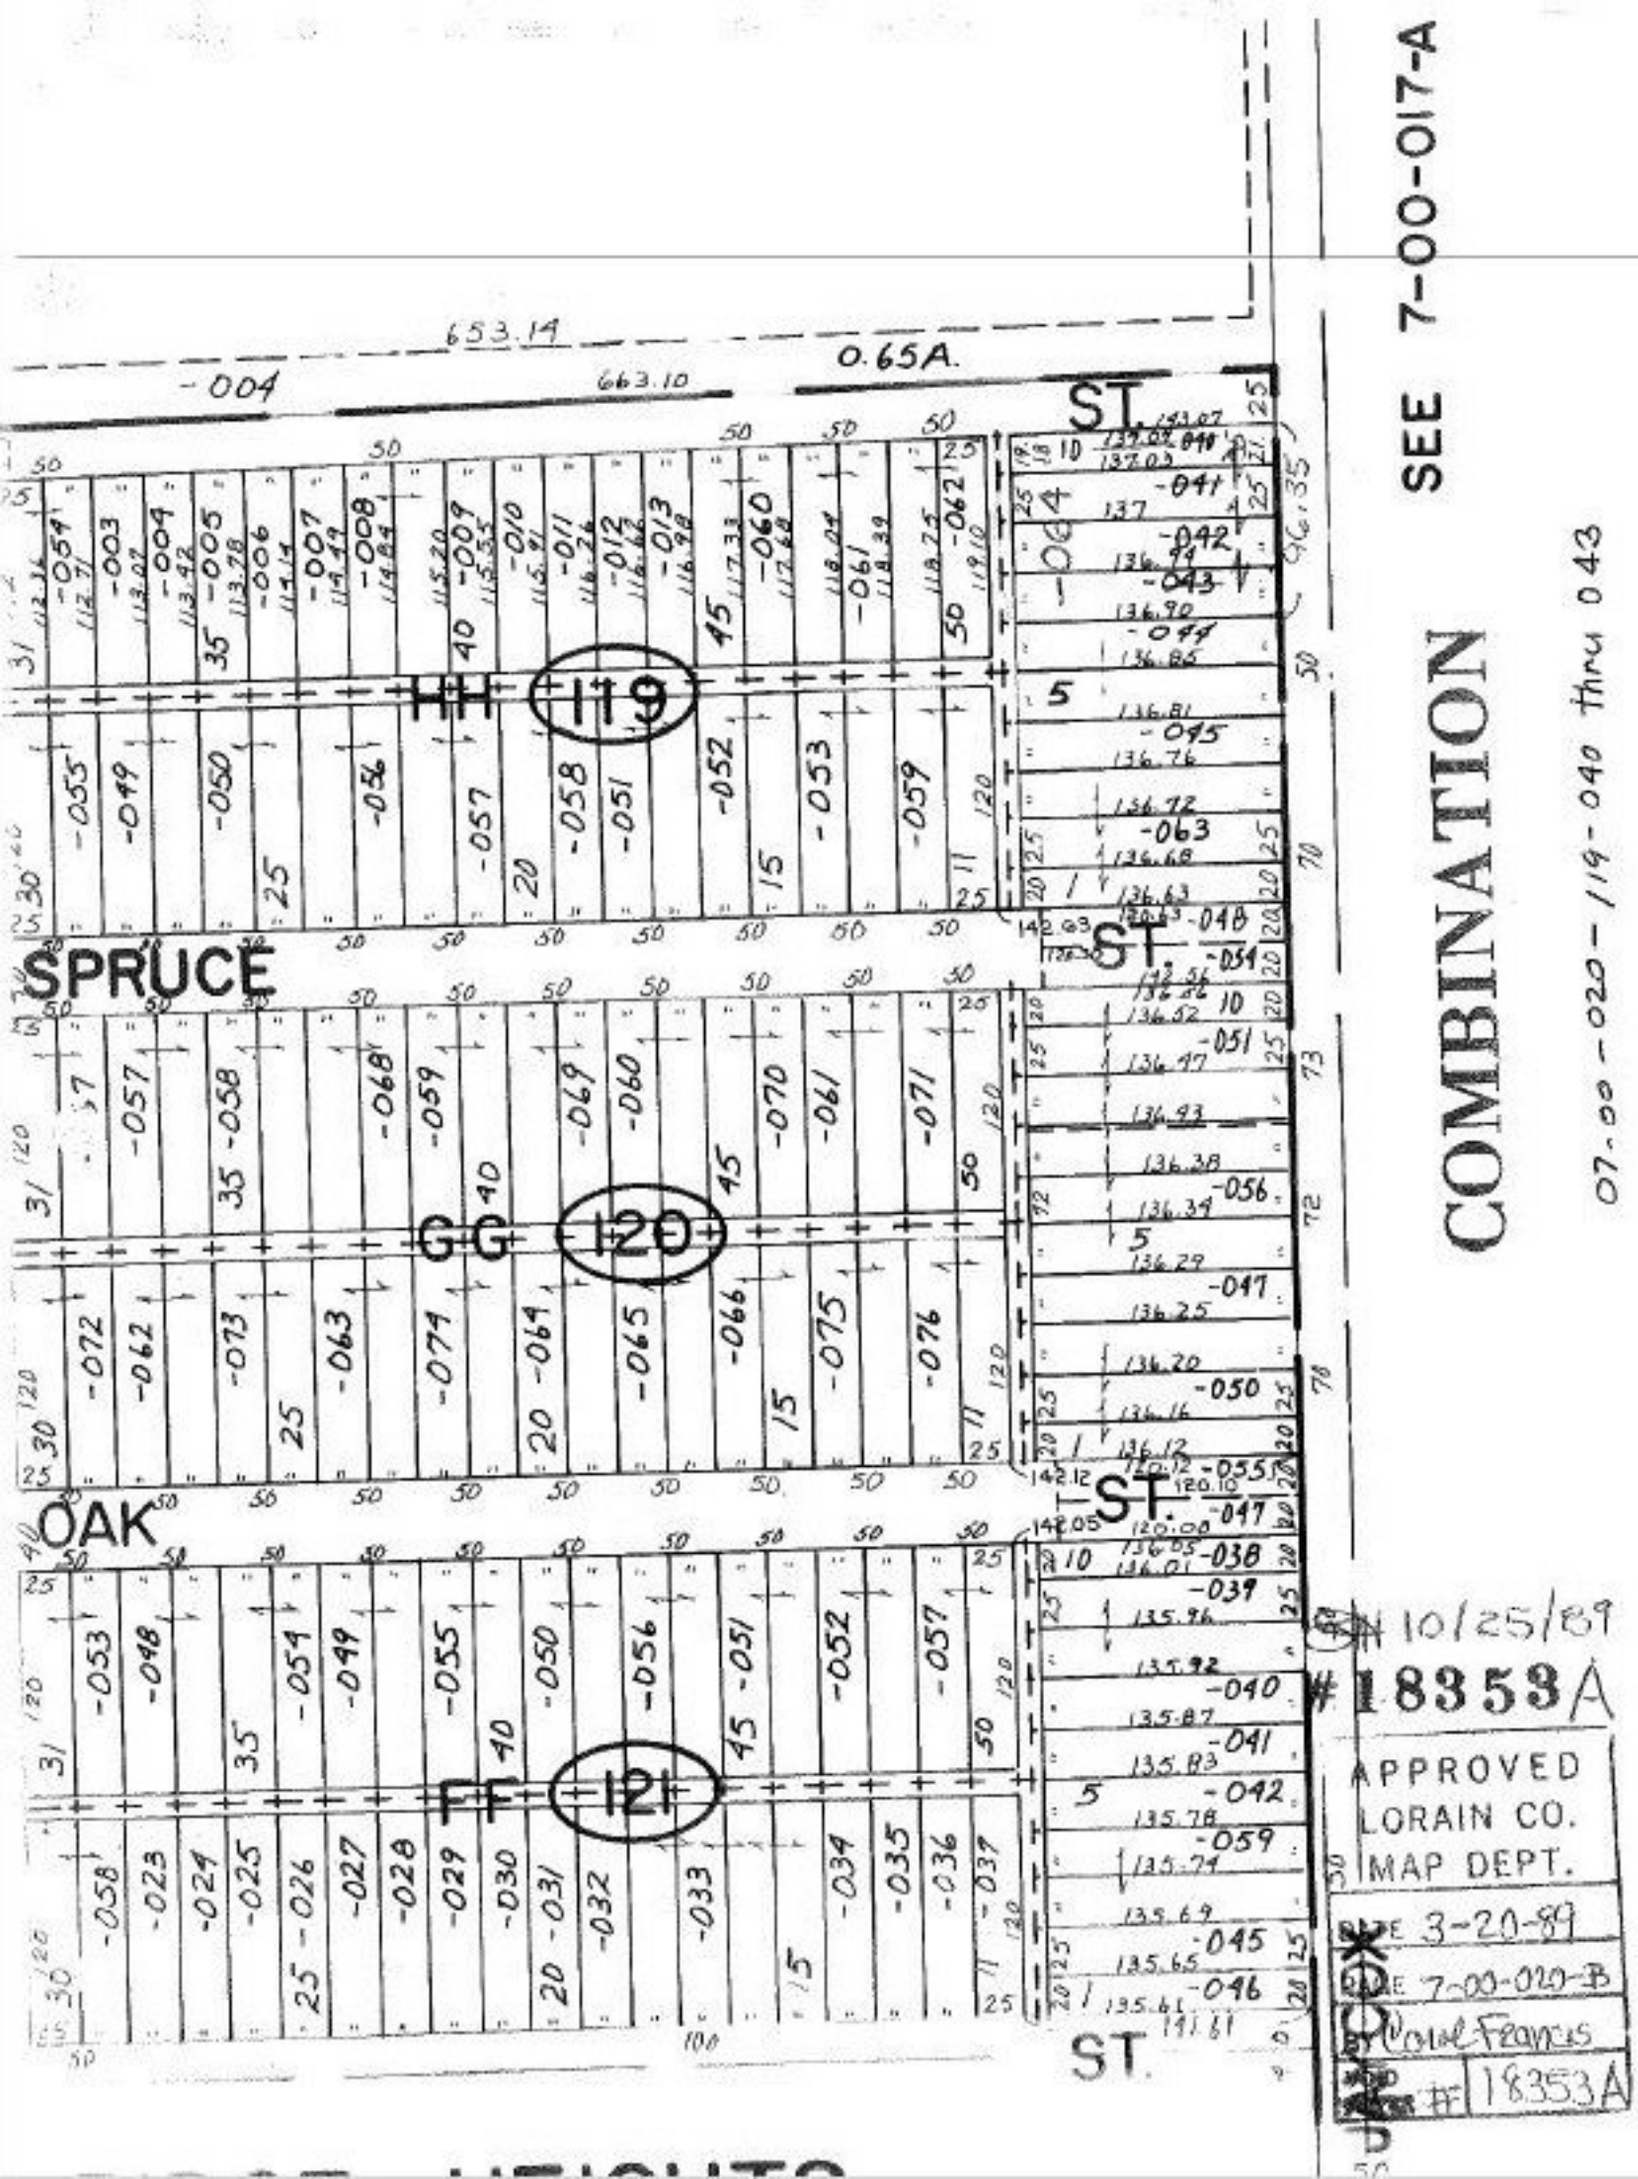

SEE 7-00-017-A
COMBINATION
07-00-020-119-040 thru 043
653.14
0.65A.
663.10
-004
ST.
HH 119
SPRUCE
GG 120
OAK
FF 121
ST.
ST.
ST.
10/25/89
#18353A
APPROVED
LORAIN CO.
MAP DEPT.
DATE 3-20-89
DATE 7-00-020-B
BY Carol Francis
#18353A