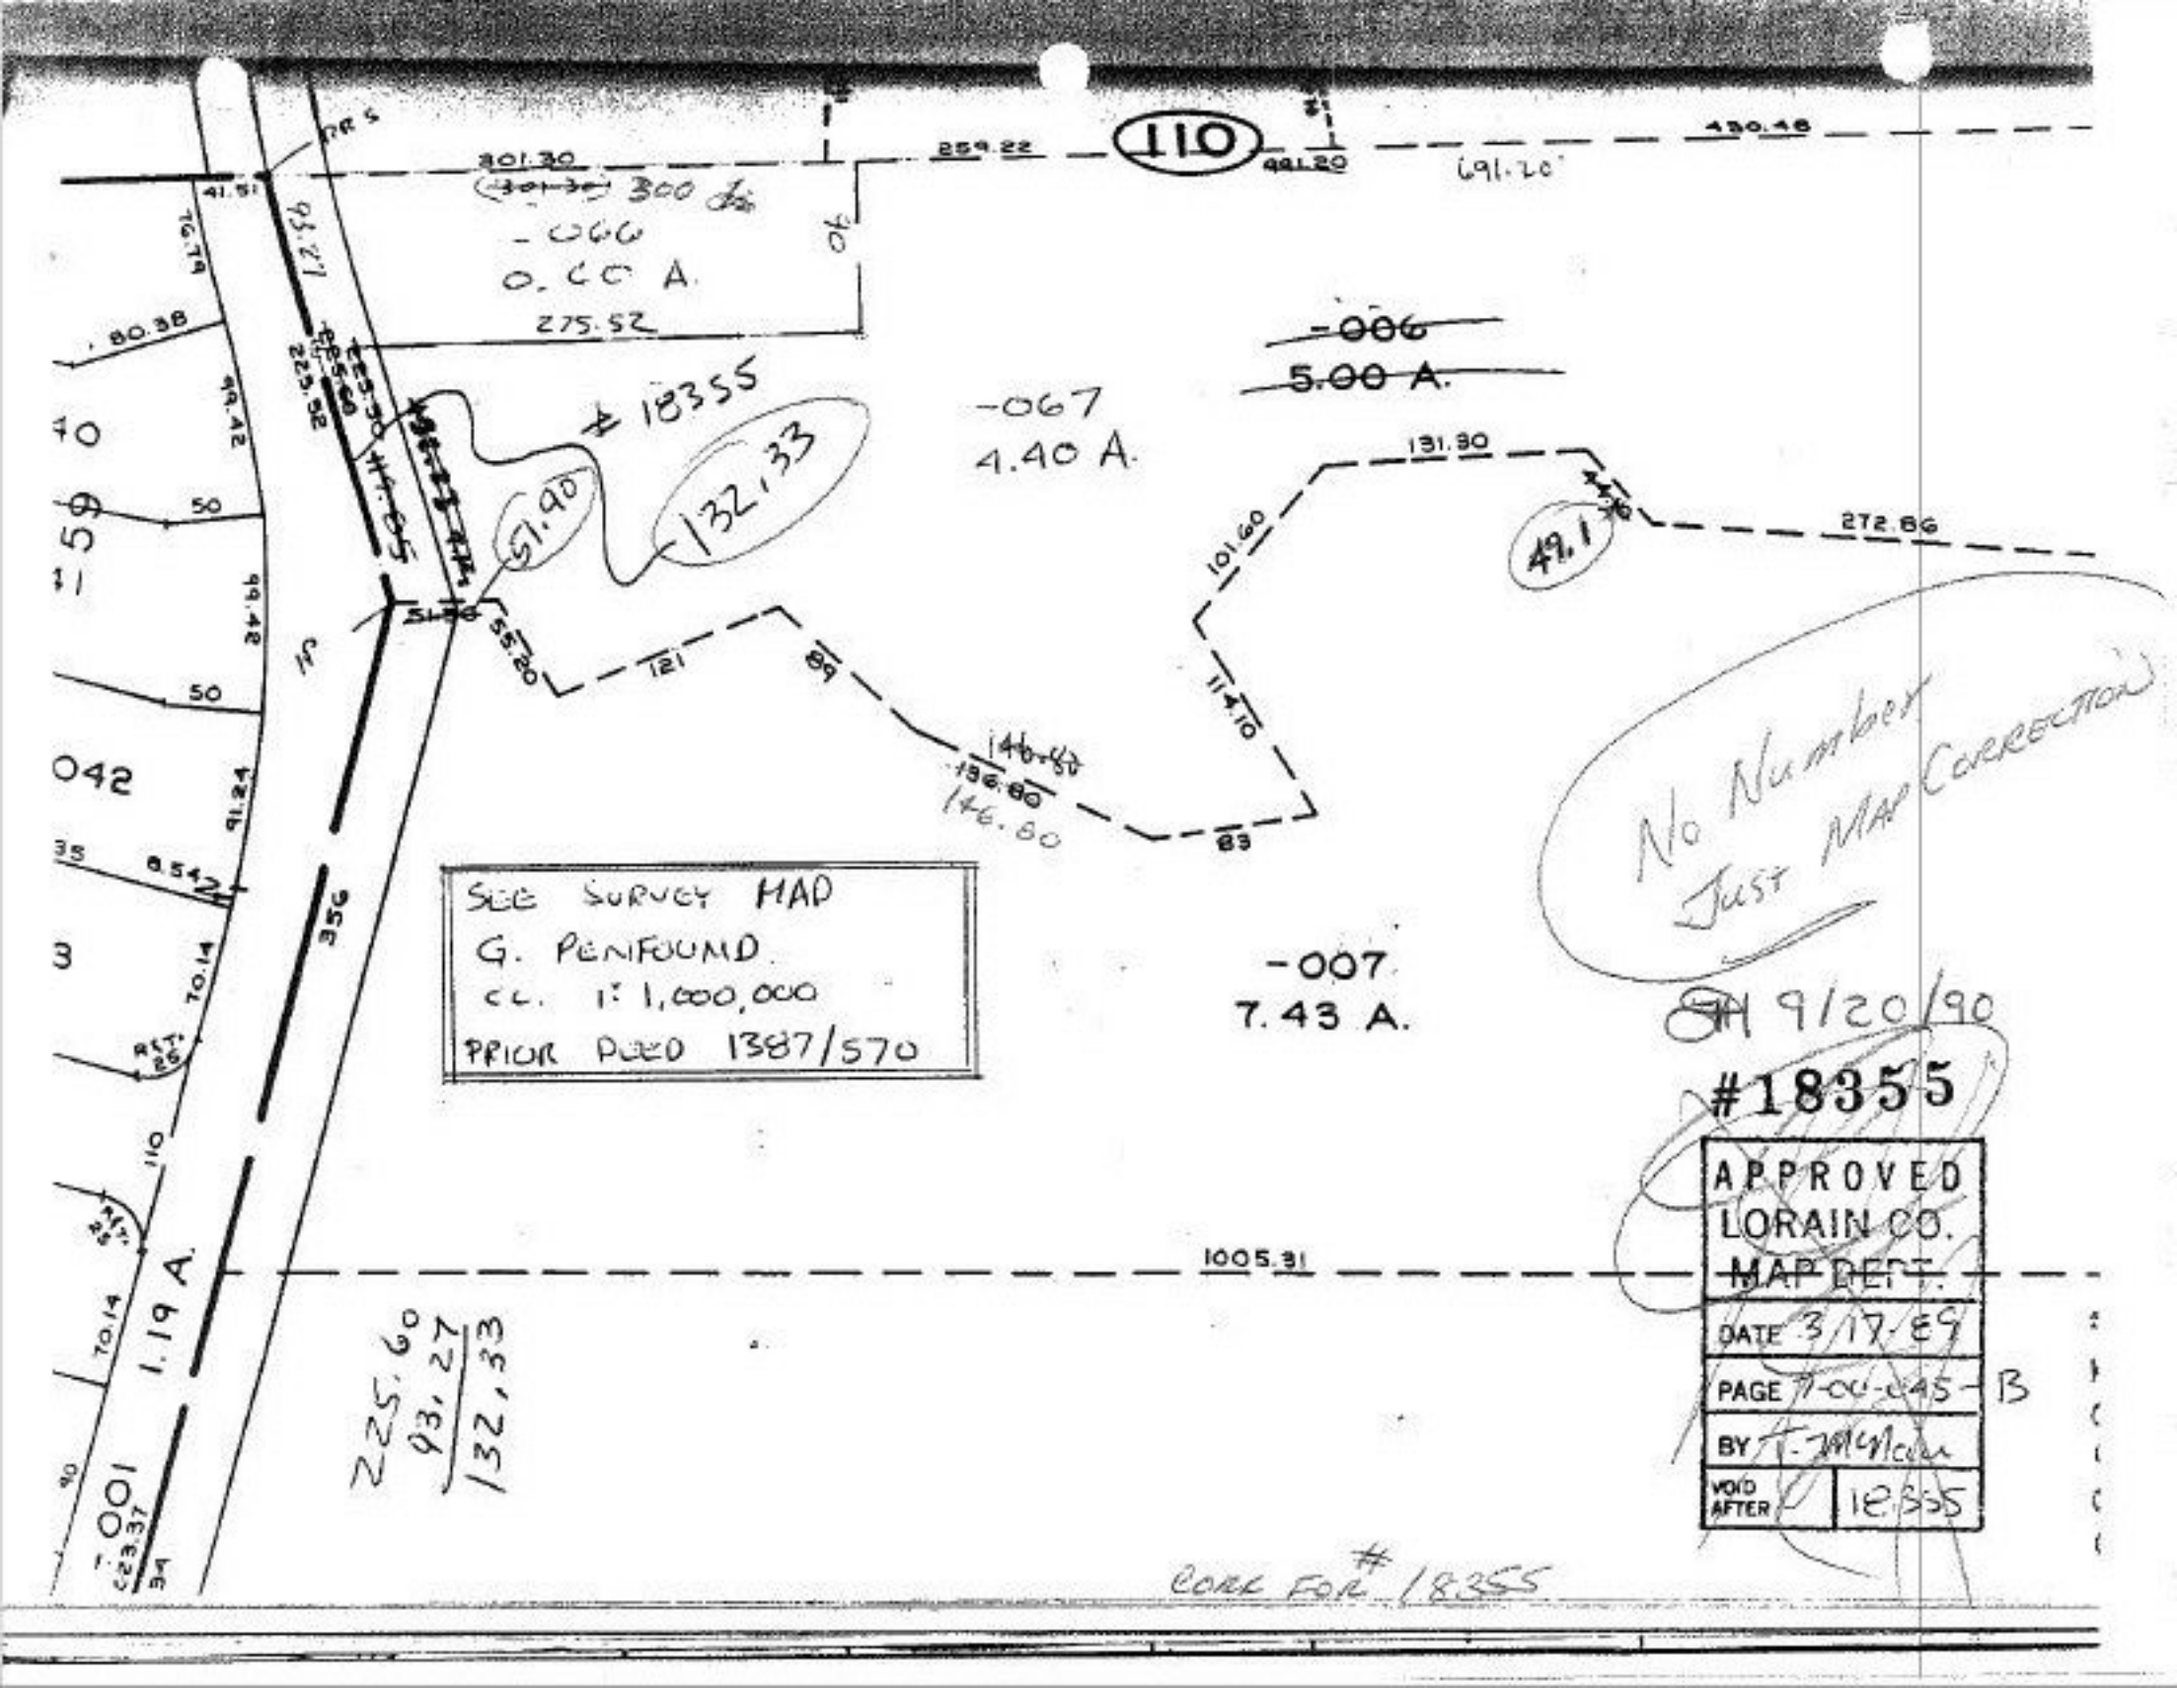
110
301.30
(301.30) 300 ft
-066
0.CC A.
275.52
259.22
491.20
691.20
430.48
-006
5.00 A.
-067
4.40 A.
-007
7.43 A.
# 18355
131.30
272.86
101.60
114.10
146.80
146.80
121
89
83
55.20
51.90
132,33
49.1
SEE SURVEY MAP
G. PENFOUND
cc. 1" 1,000,000
PRIOR DEED 1387/570
No Number
Just MAP Correction
9/20/90
#18355
APPROVED
LORAIN CO.
MAP DEPT.
DATE 3/17/89
PAGE 7-00-045 B
BY T. McMahon
VOID AFTER 18355
1005.31
1.19 A.
225.60
93.27
132,33
CORK FOR # 18355