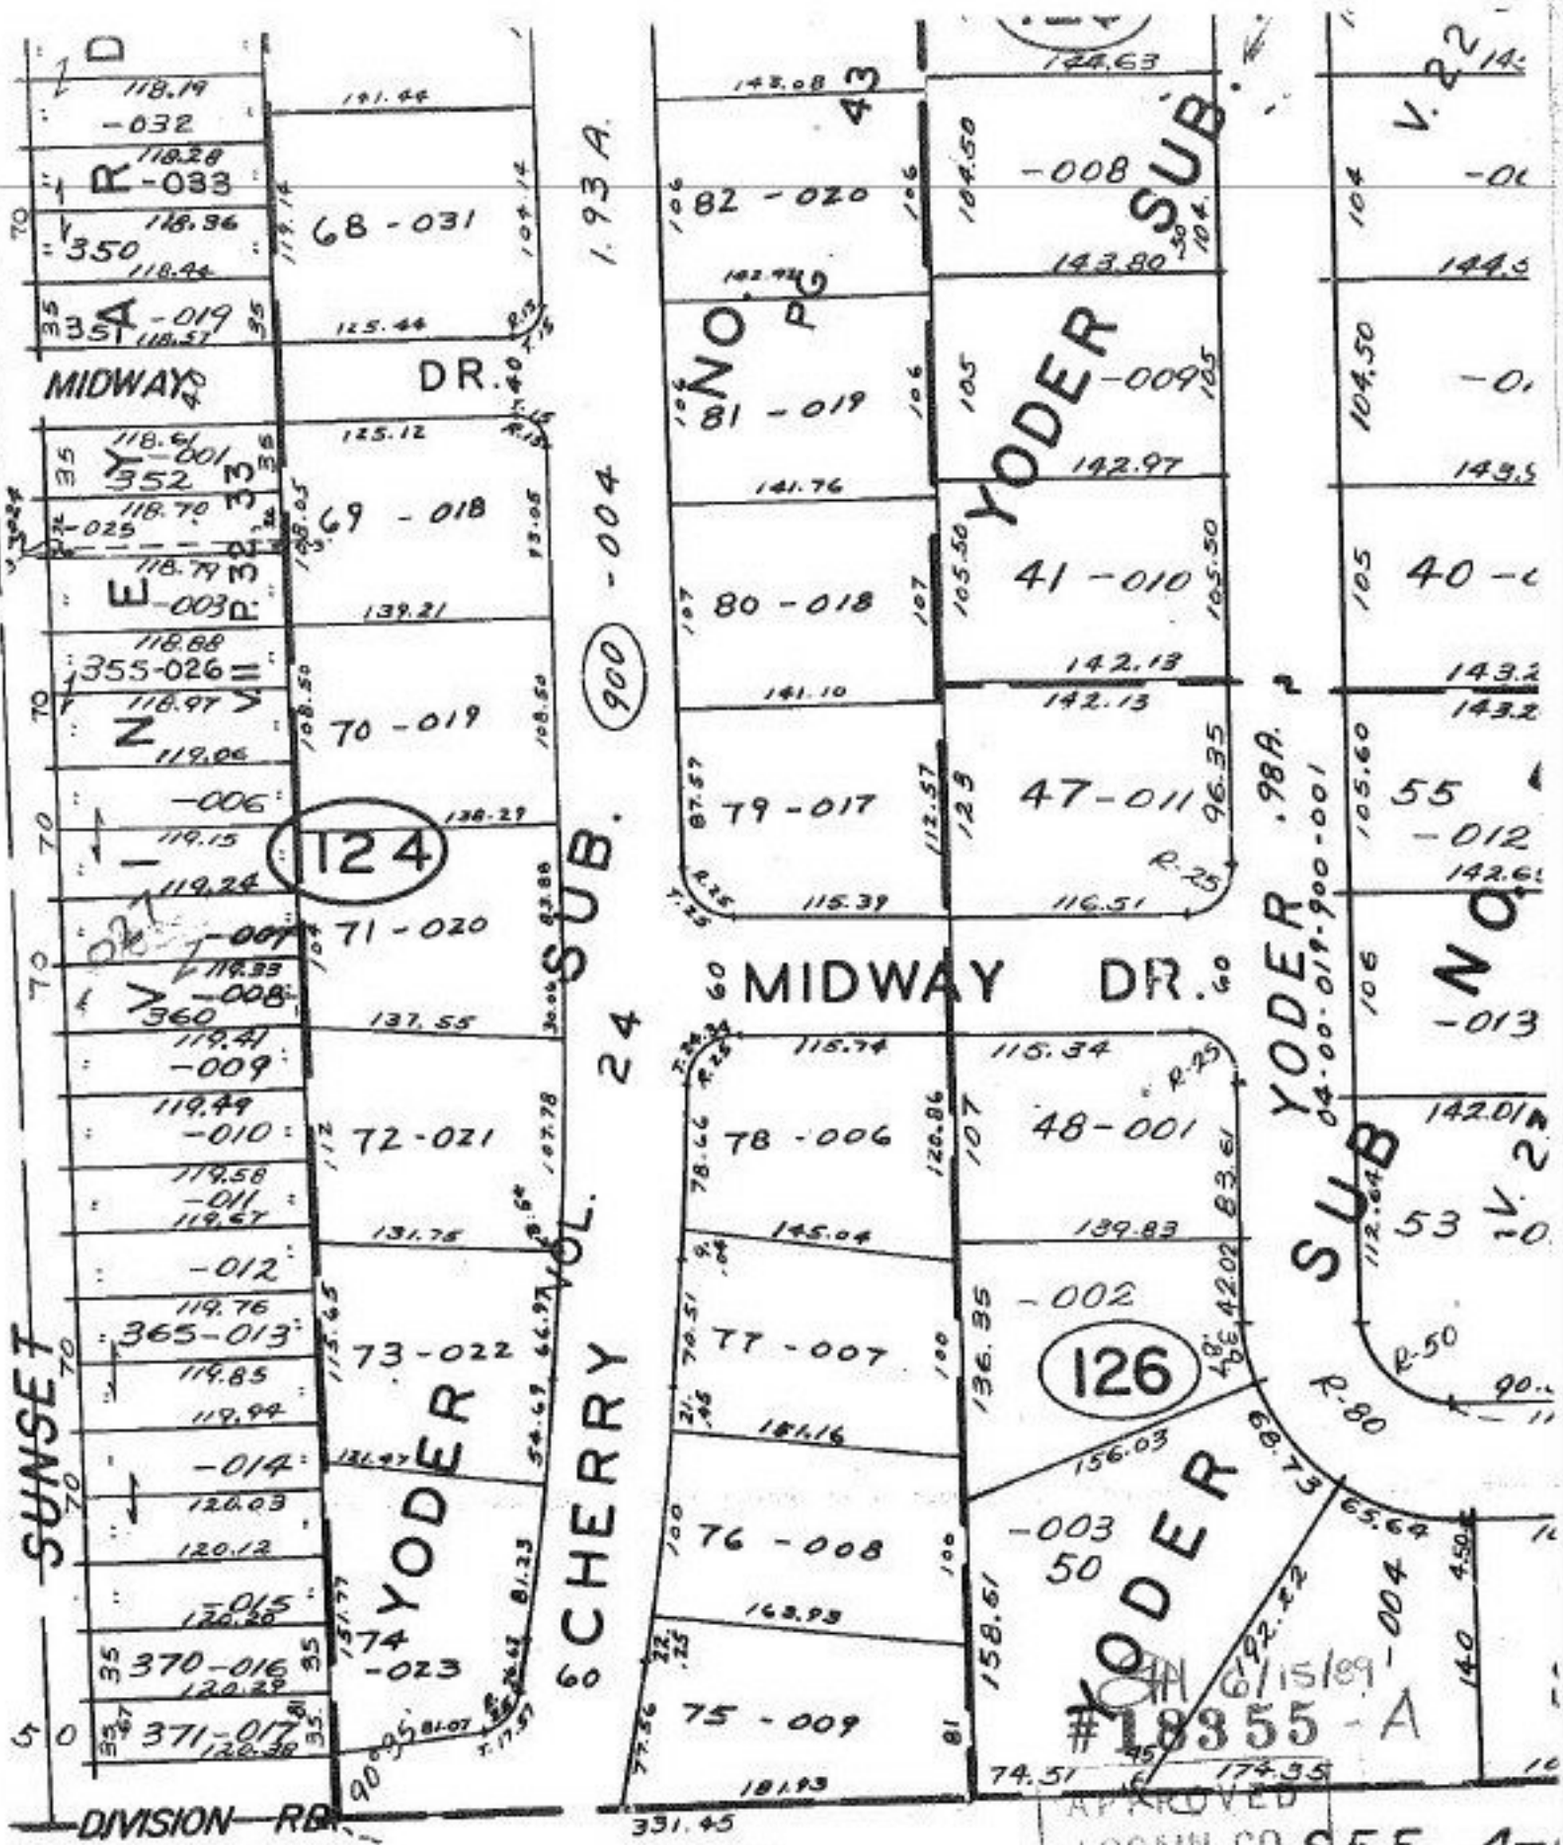

#18355-A

6/15/89

COMBINATION

04-00-019-124 ~~-007~~ ~~-008~~

APPROVED
LORAIN CO.
MAP DEPT.
DATE 8/24/89
PAGE 4-00-019-B
BY CAROL-FRANCIS

SEE 4-