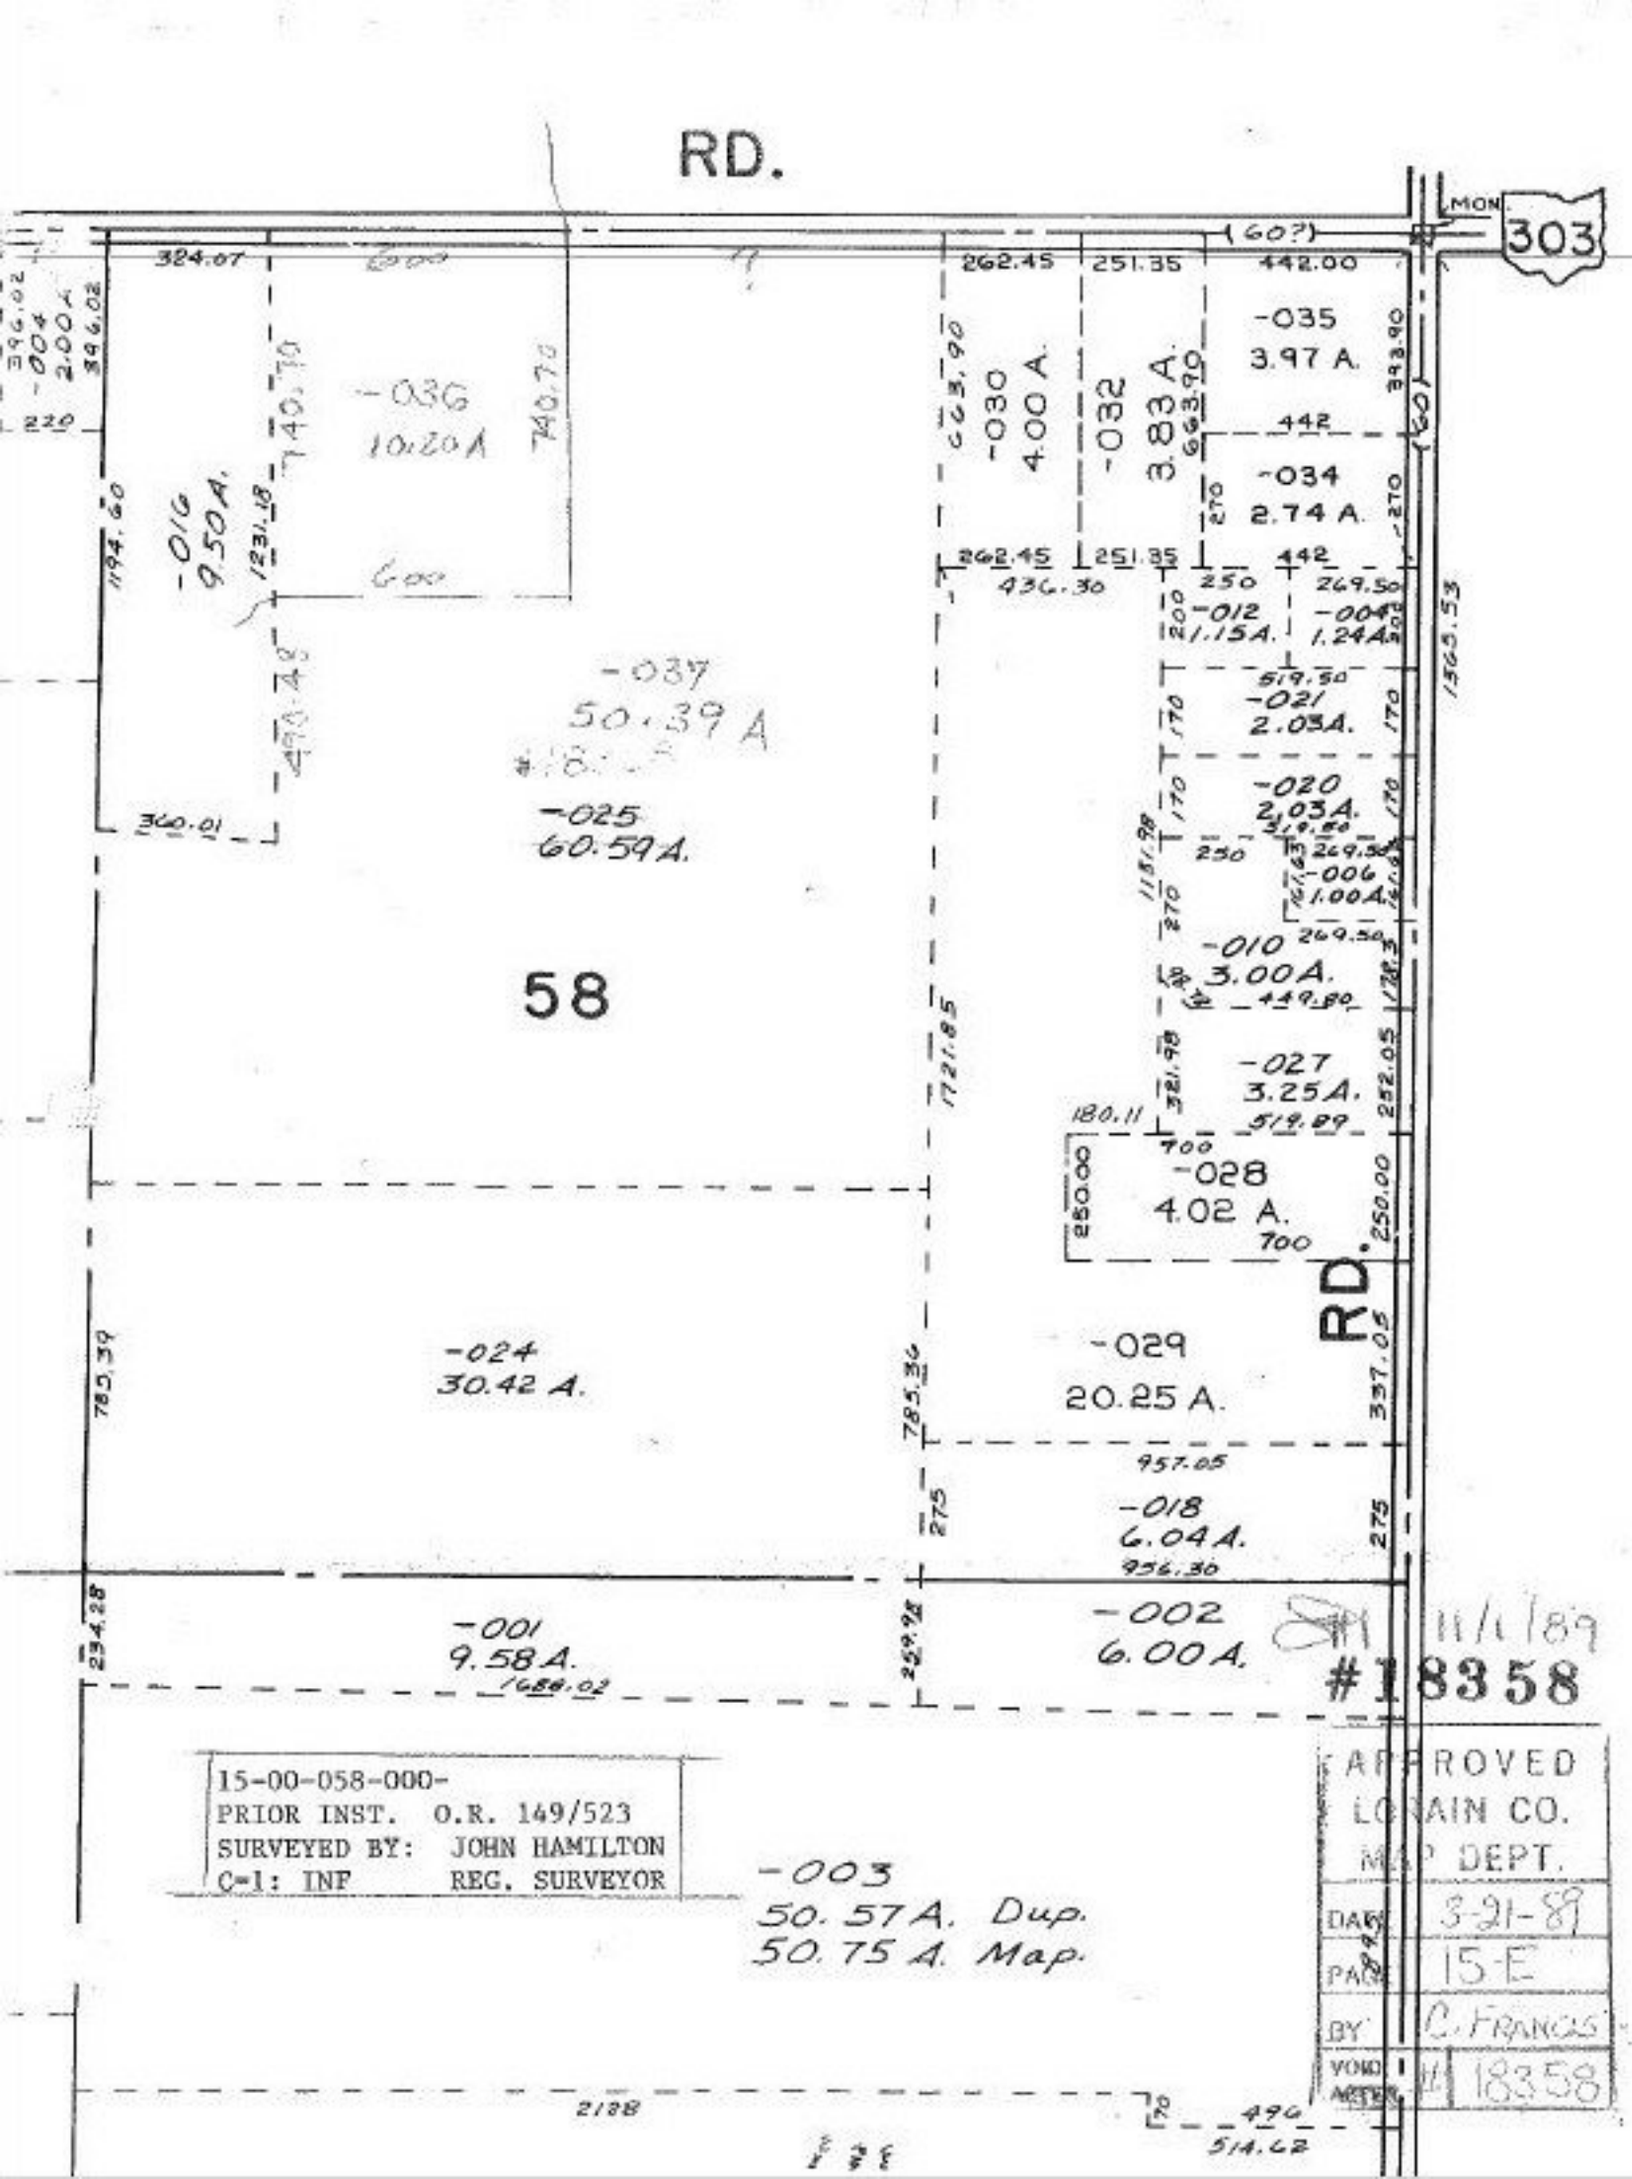
RD.
MON. 303
(60?)
324.07
262.45
251.35
442.00
-035
3.97 A.
-030
4.00 A.
-032
3.83 A.
-034
2.74 A.
-036
10.20 A.
-016
9.50 A.
-037
50.39 A.
-025
60.59 A.
58
-012
1.15 A.
-004
1.24 A.
-021
2.05 A.
-020
2.03 A.
-006
1.00 A.
-010
3.00 A.
-027
3.25 A.
-028
4.02 A.
RD.
-024
30.42 A.
-029
20.25 A.
-018
6.04 A.
-001
9.58 A.
-002
6.00 A.
-003
50.57 A. Dup.
50.75 A. Map.
15-00-058-000-
PRIOR INST. O.R. 149/523
SURVEYED BY: JOHN HAMILTON
C-1: INF REG. SURVEYOR
APPROVED
LORAIN CO.
MAP DEPT.
DATE 3-21-89
PAGE 15-E
BY C. FRANCIS
VOID AFFDVT #18358
11/1/89
#18358