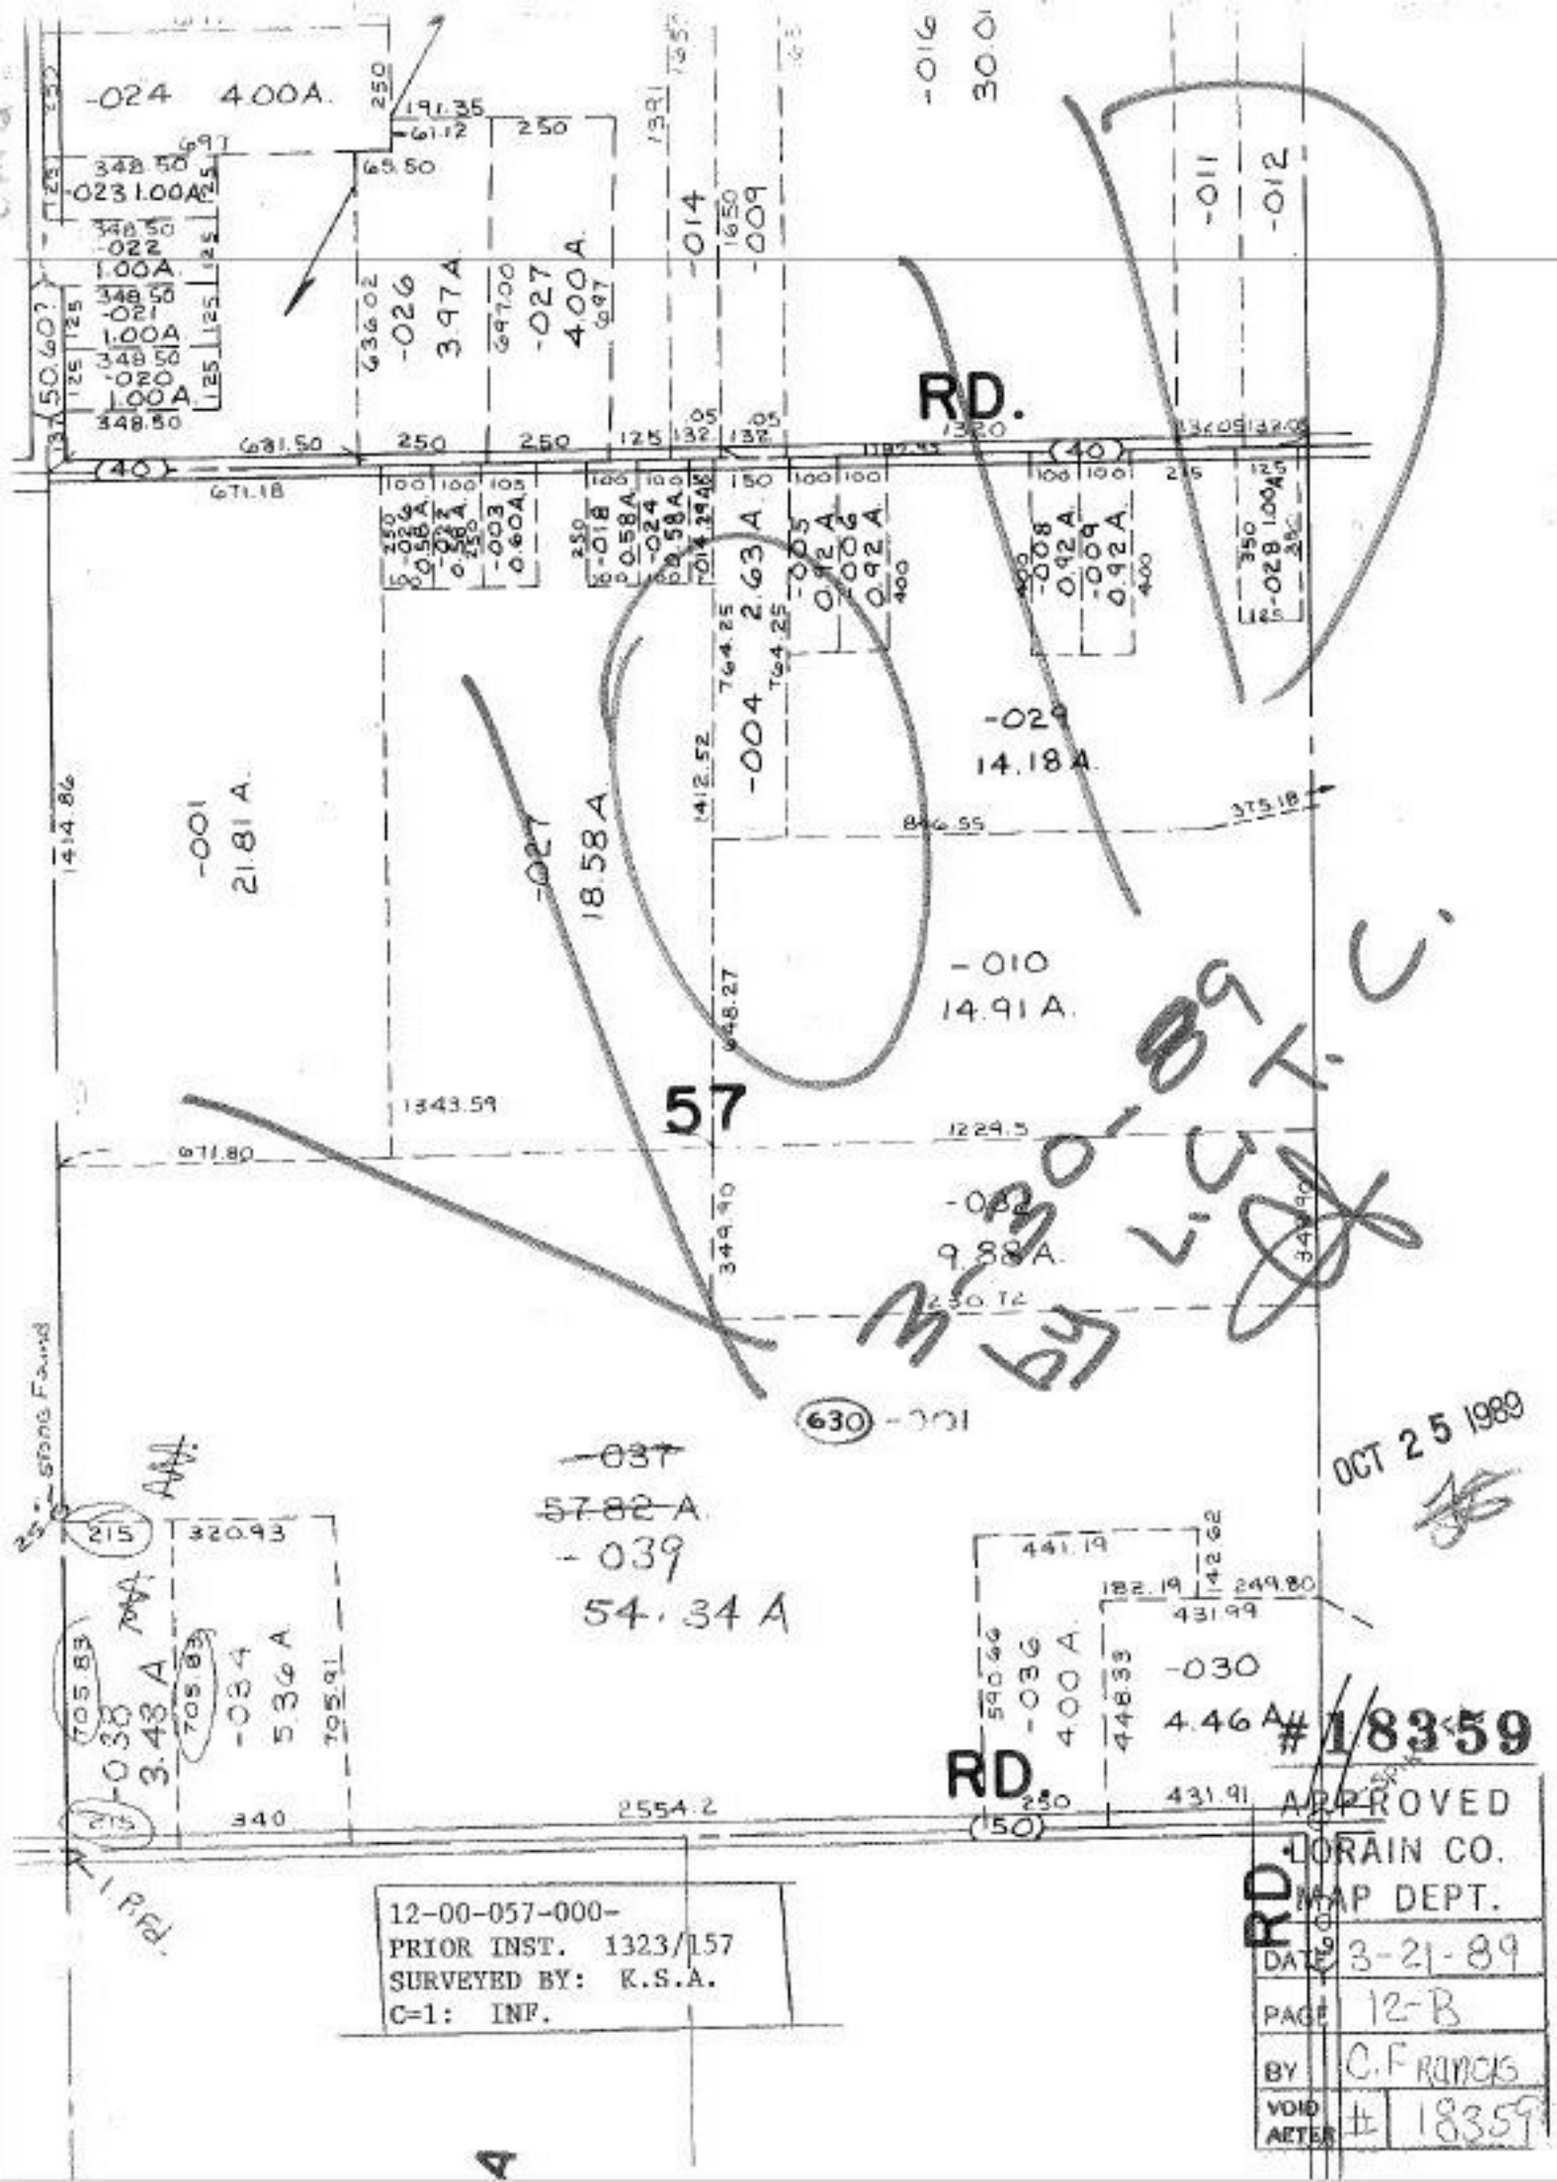

12-00-057-000-
PRIOR INST. 1323/157
SURVEYED BY: K.S.A.
C=1: INF.