


SEE 4-00-015-B

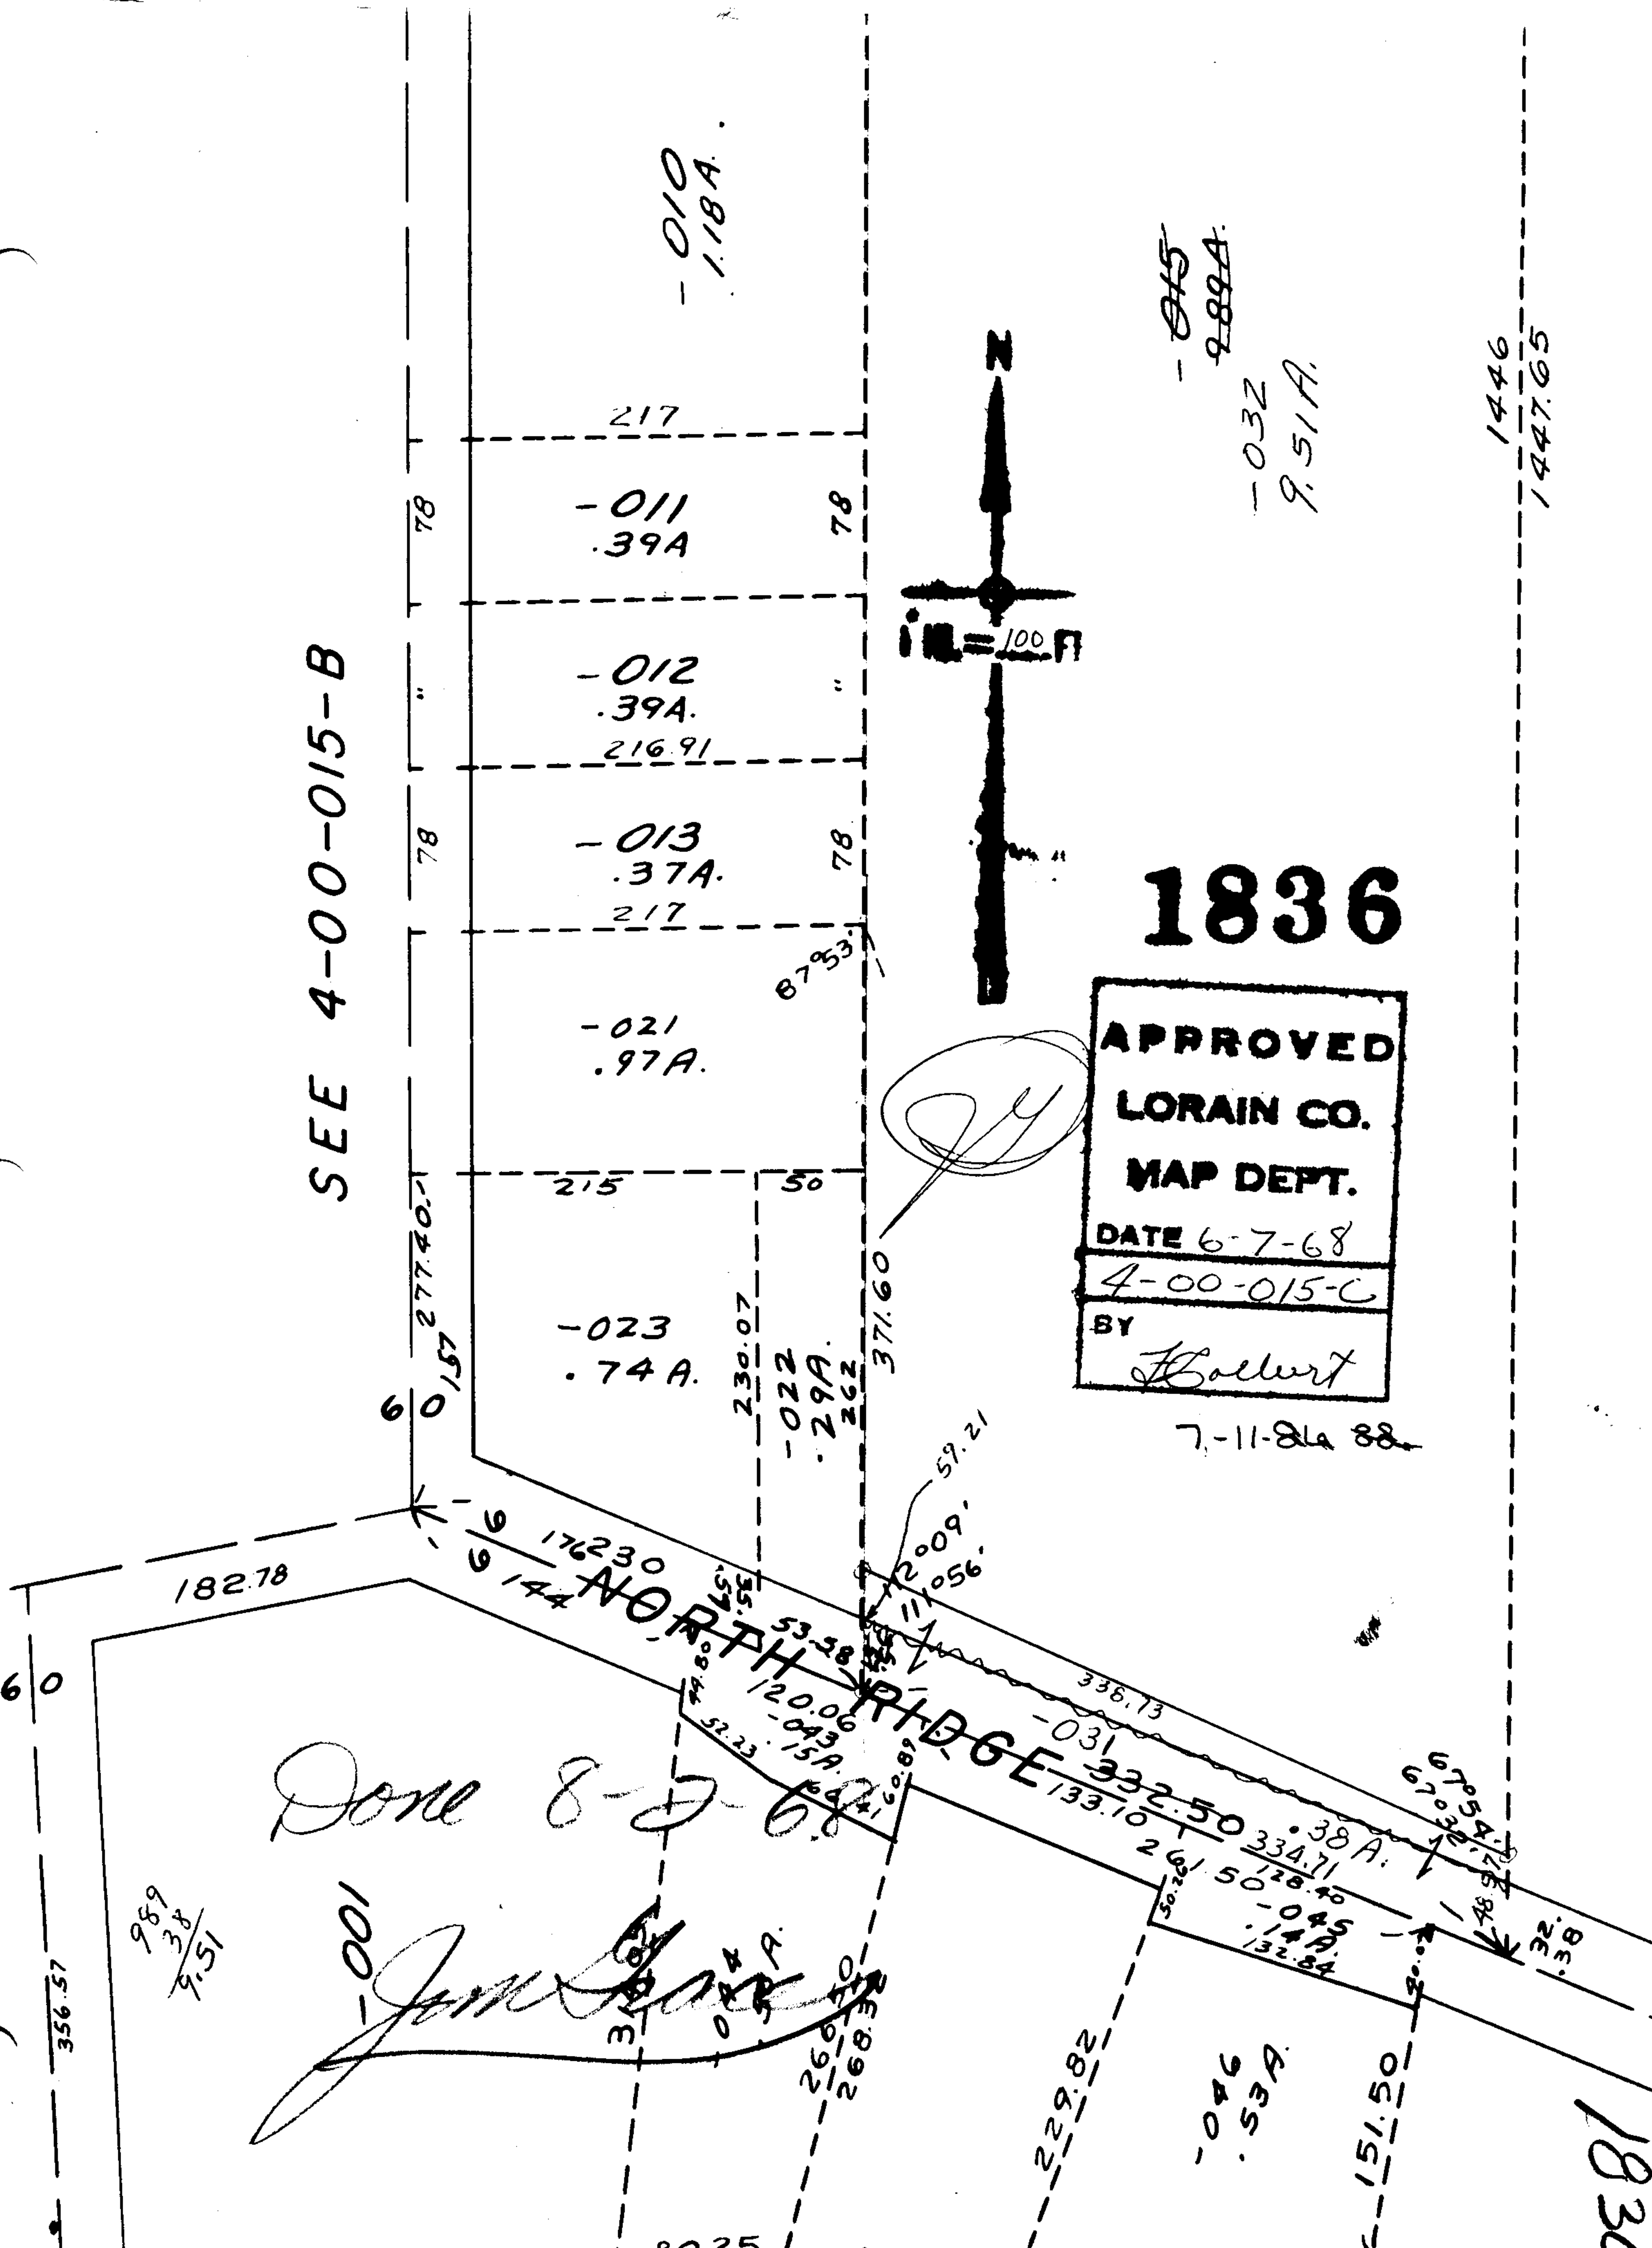

-010
1.18 A.

-011
0.39 A.

-012
0.39 A.
216.91

-013
0.37 A.
217

-021
0.97 A.

-023
0.74 A.

-022
0.29 A.
262

1836

APPROVED
LORAIN CO.
MAP DEPT.

DATE 6-7-68
4-00-015-C
BY
Hallert

-015
~~2.89 A.~~
-032
9.51 A.

1446
1447.65

7-11-84 88


-001

989
38
9.51

-046
0.53 A.

1836