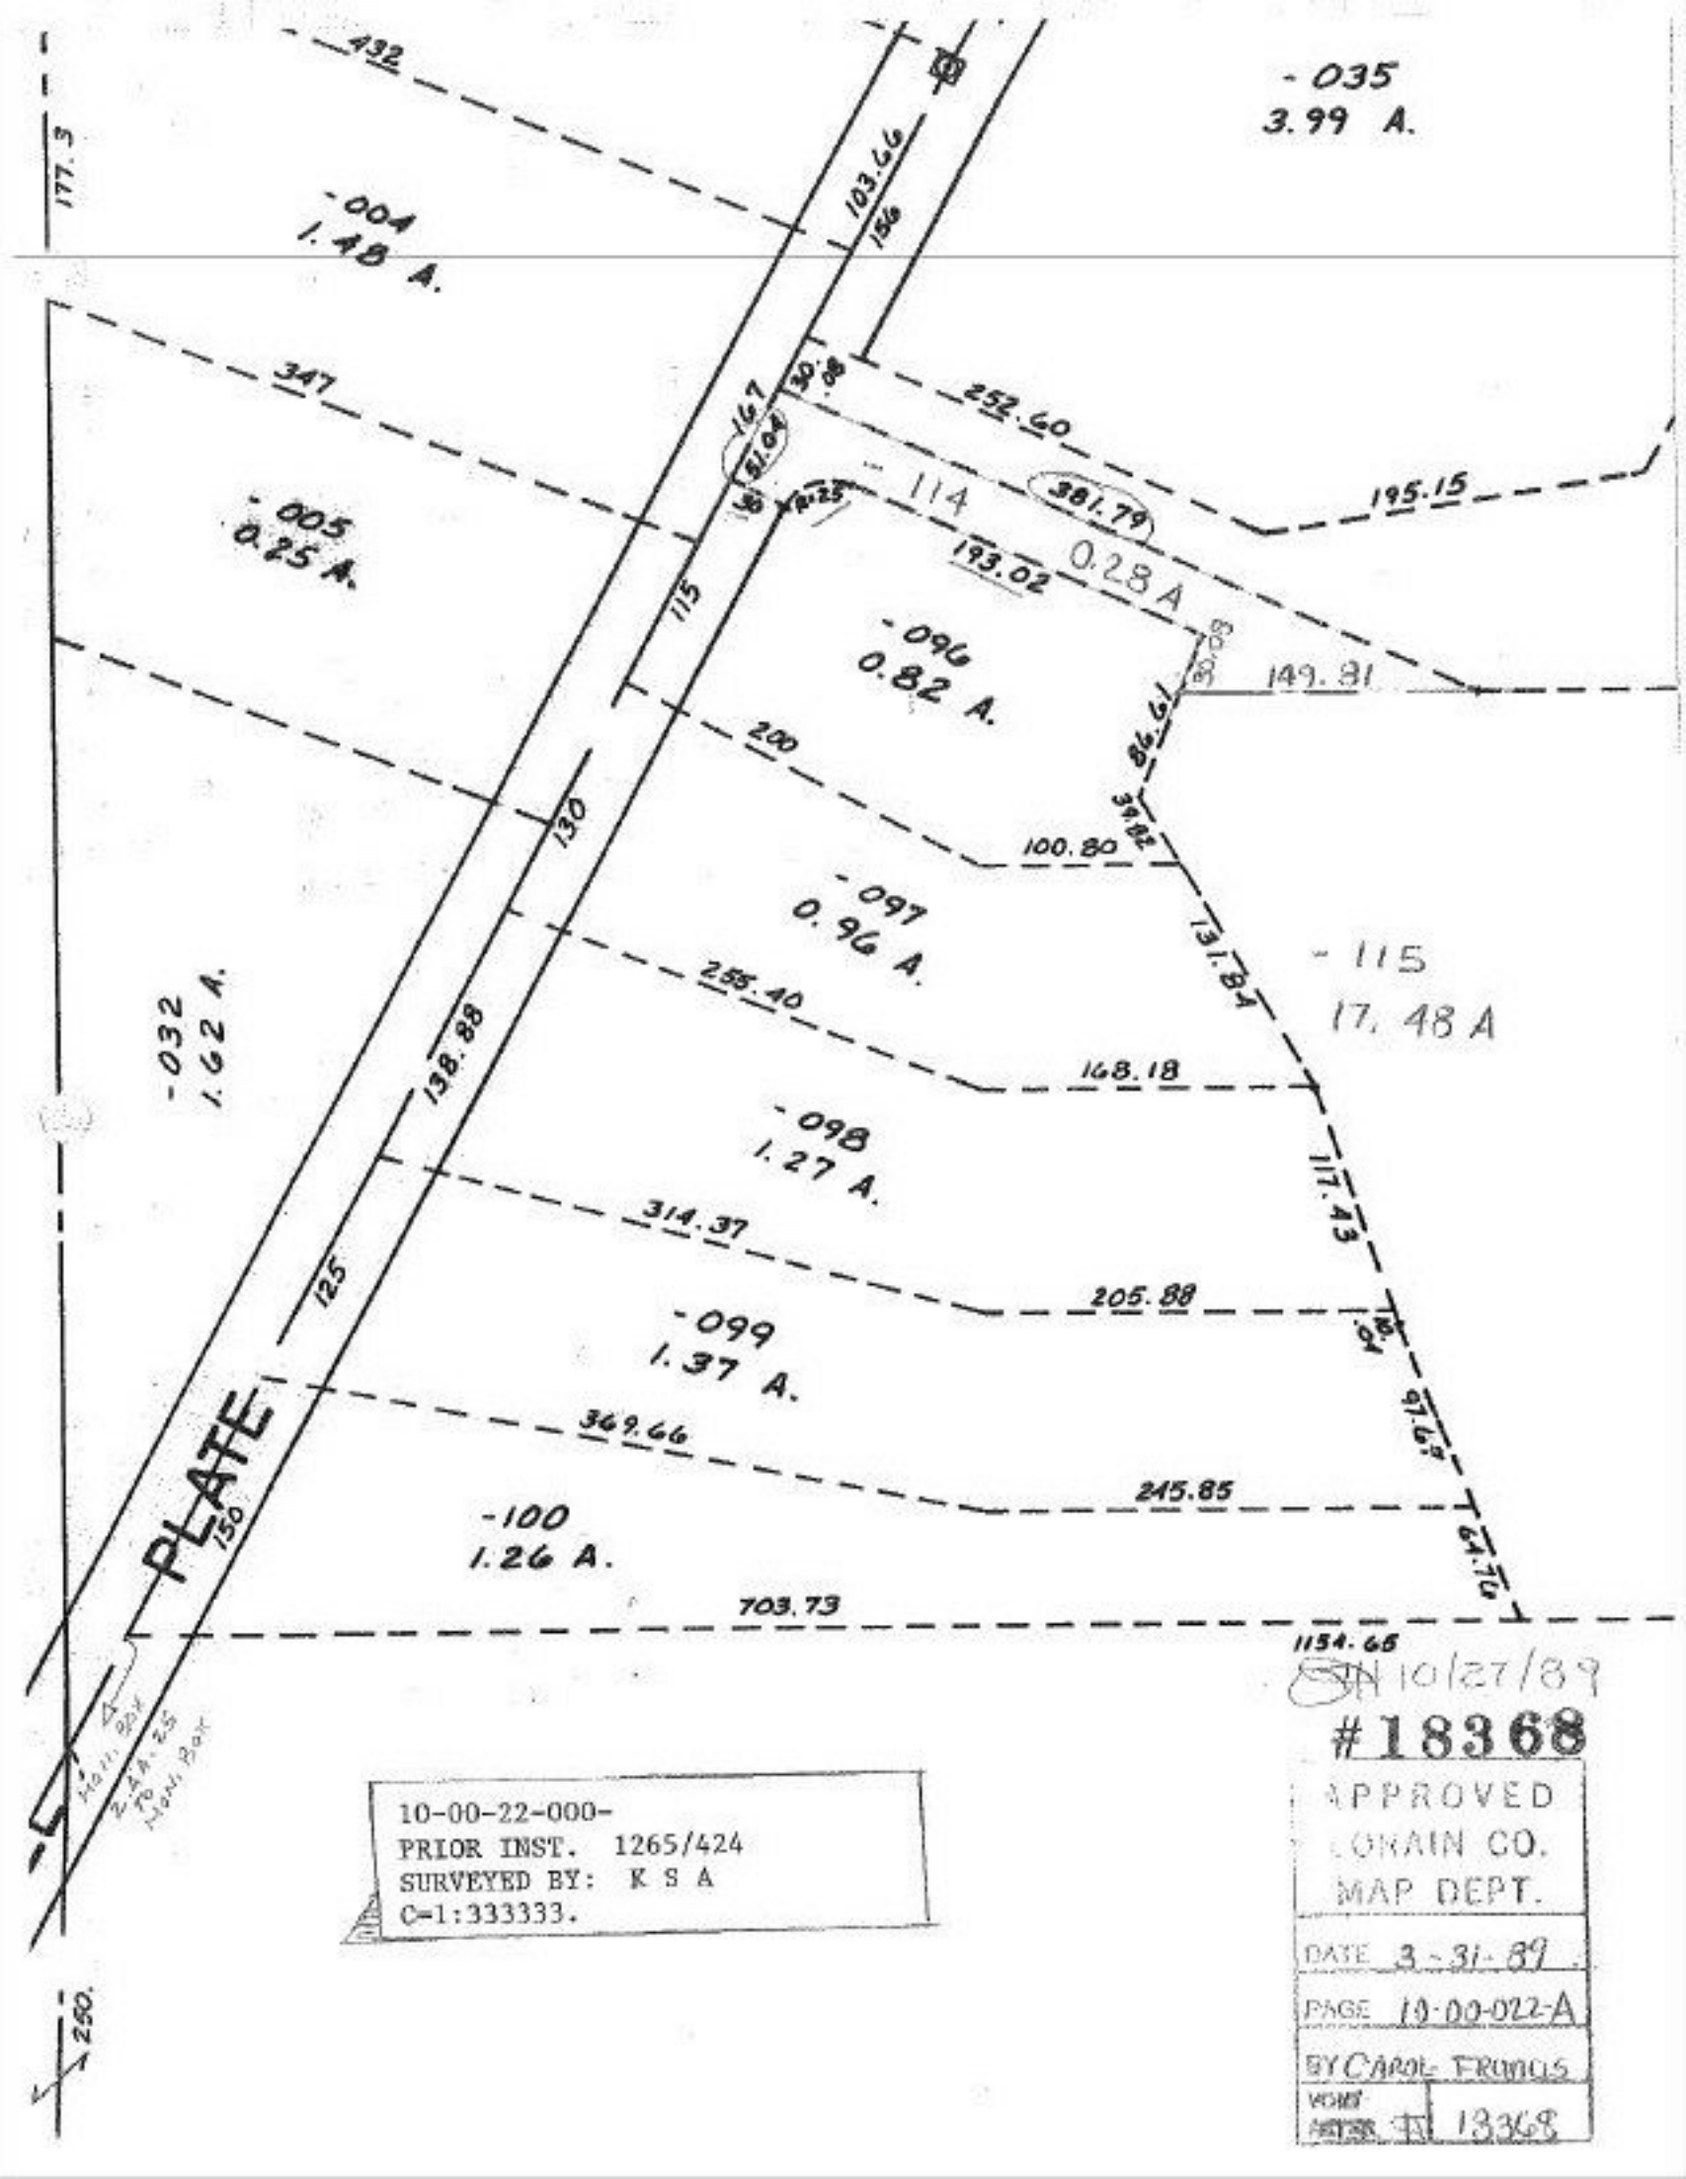

10-00-22-000-
PRIOR INST. 1265/424
SURVEYED BY: K S A
C-1:333333.

SN 10/27/89

#18368

APPROVED
LORAIN CO.
MAP DEPT.
DATE 3-31-89
PAGE 10-00-022-A
BY CAROL FRANCIS
VOL/PAGE 13368