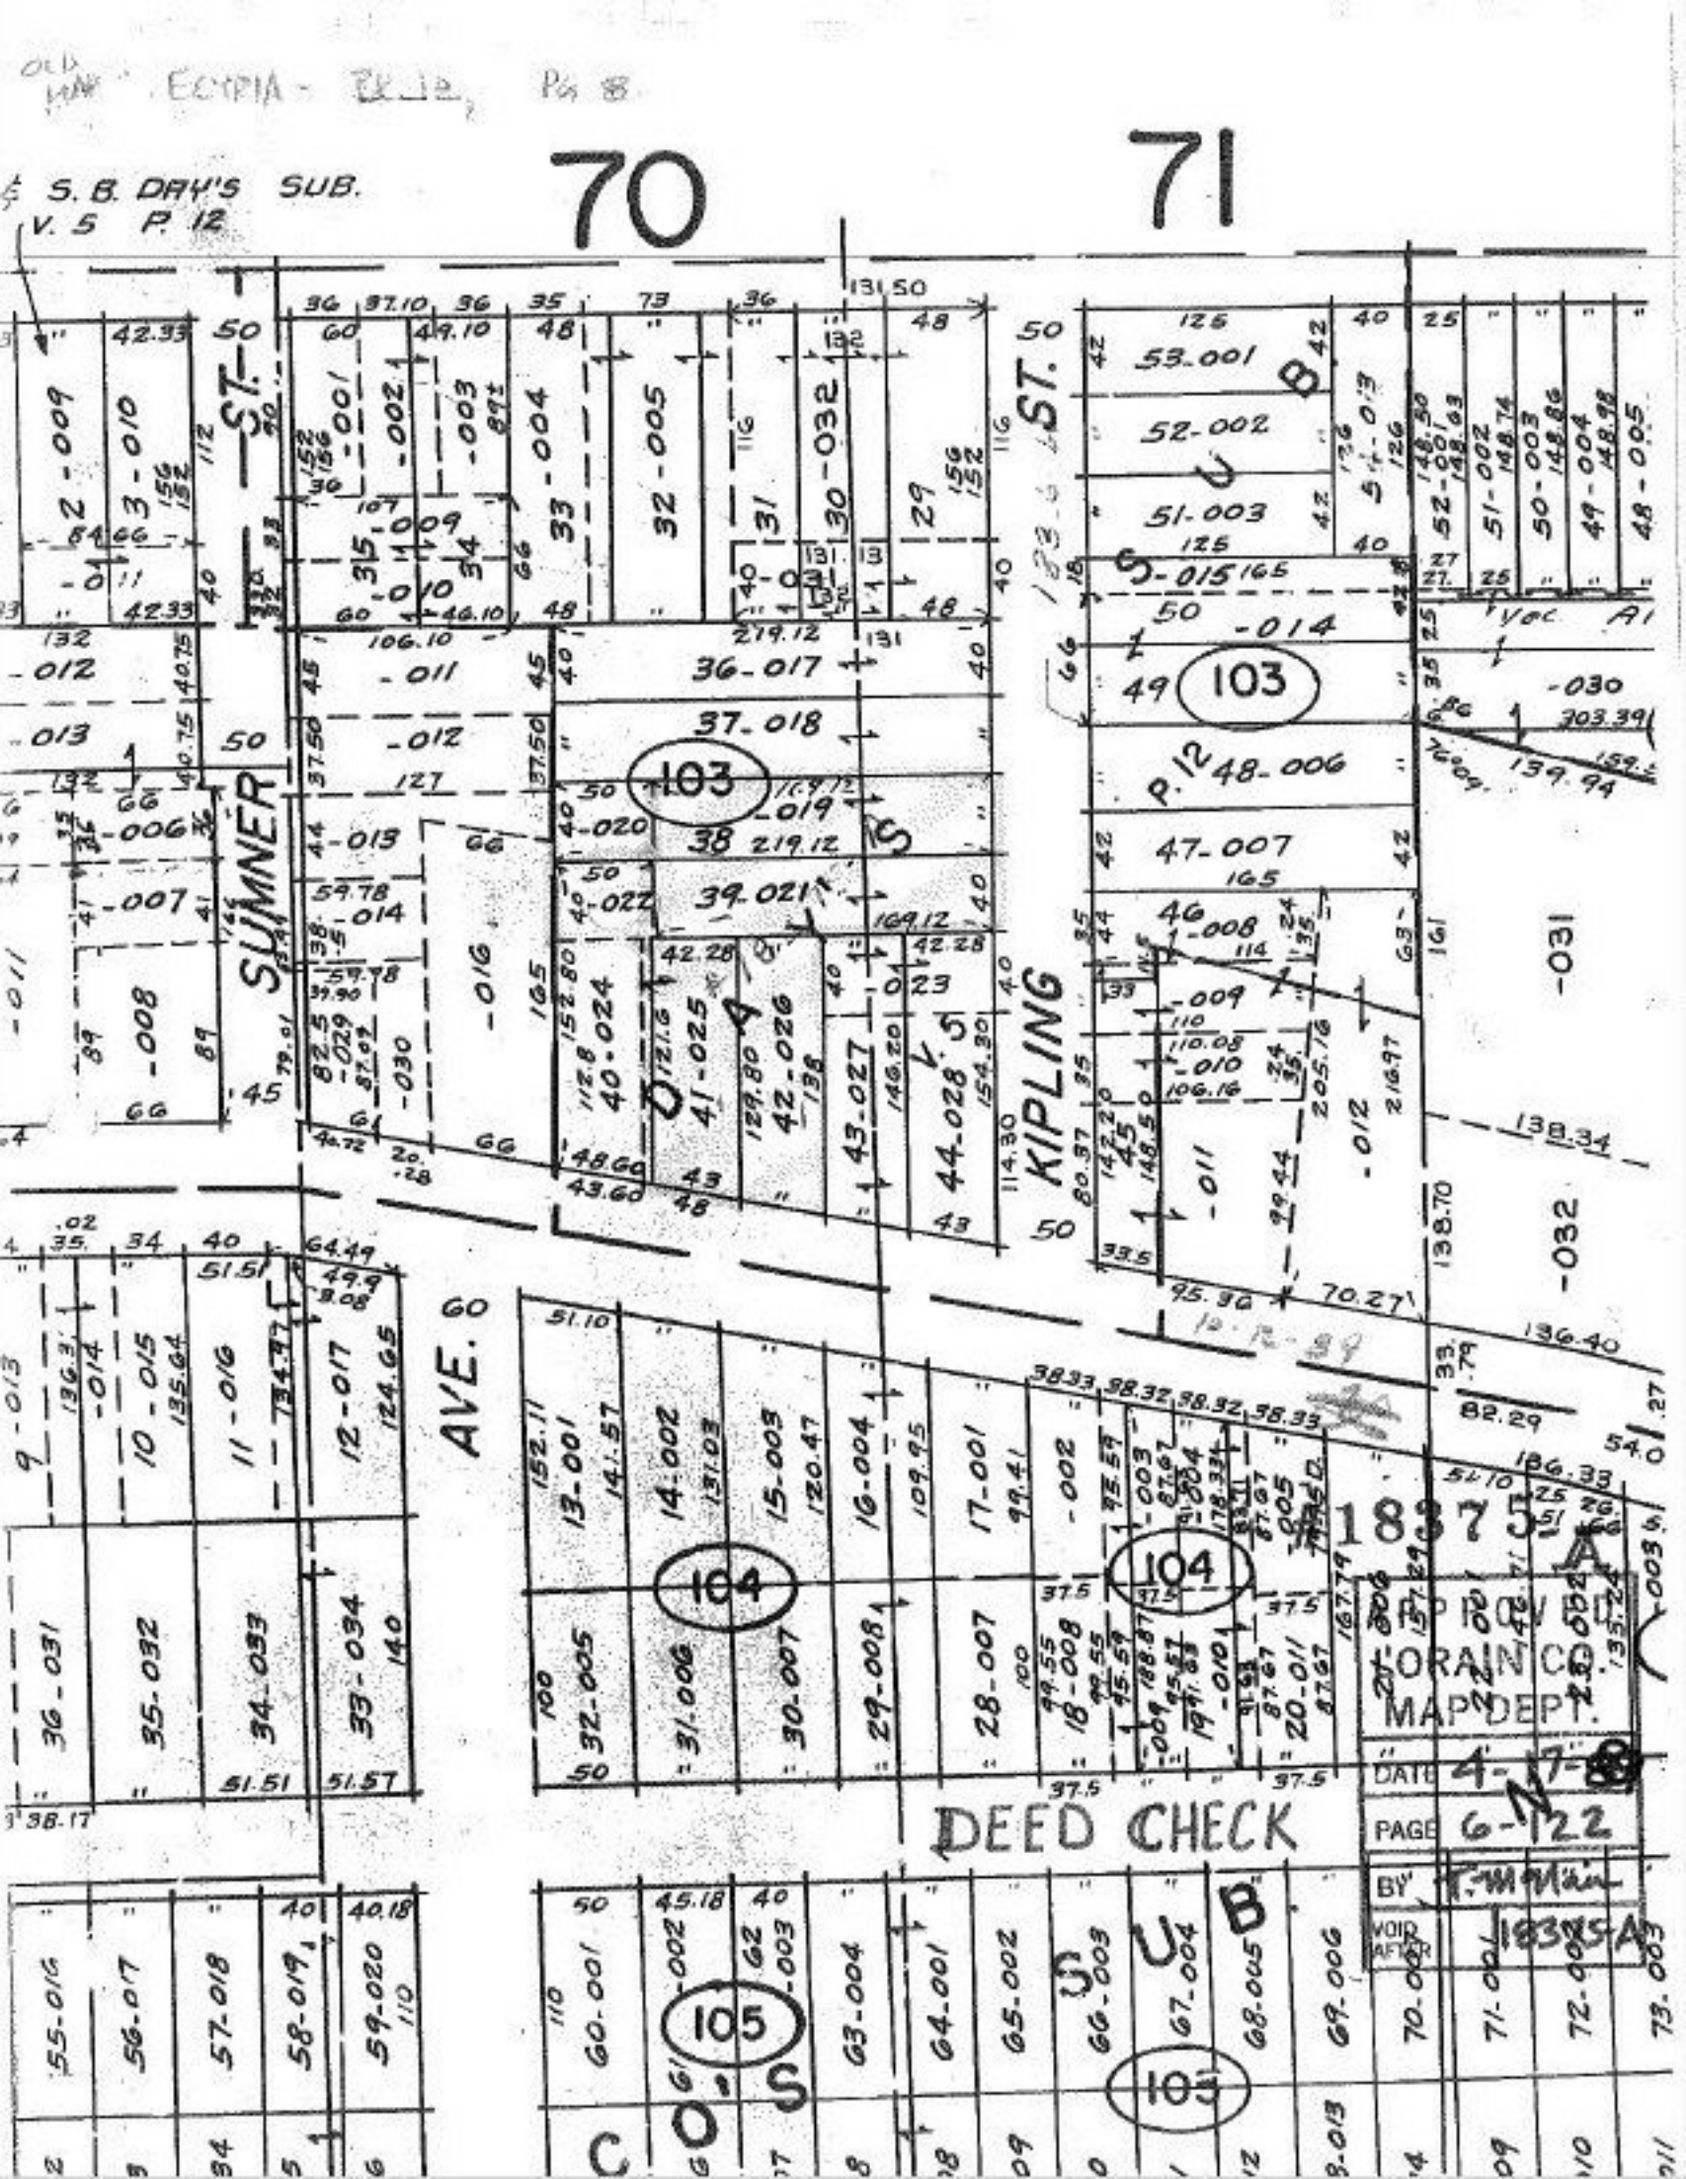

OLD MAP ECTRIA - BK 12, PG 8
70
71
S. B. DAY'S SUB.
V. 5 P. 12
SUMNER ST.
KIPLING ST.
AVE.
103
104
105
DEED CHECK
#18375-A
APPROVED
ORAIN CO.
MAP DEPT.
DATE 4-17-89
PAGE 6-122
BY
VOID AFTER 18375-A