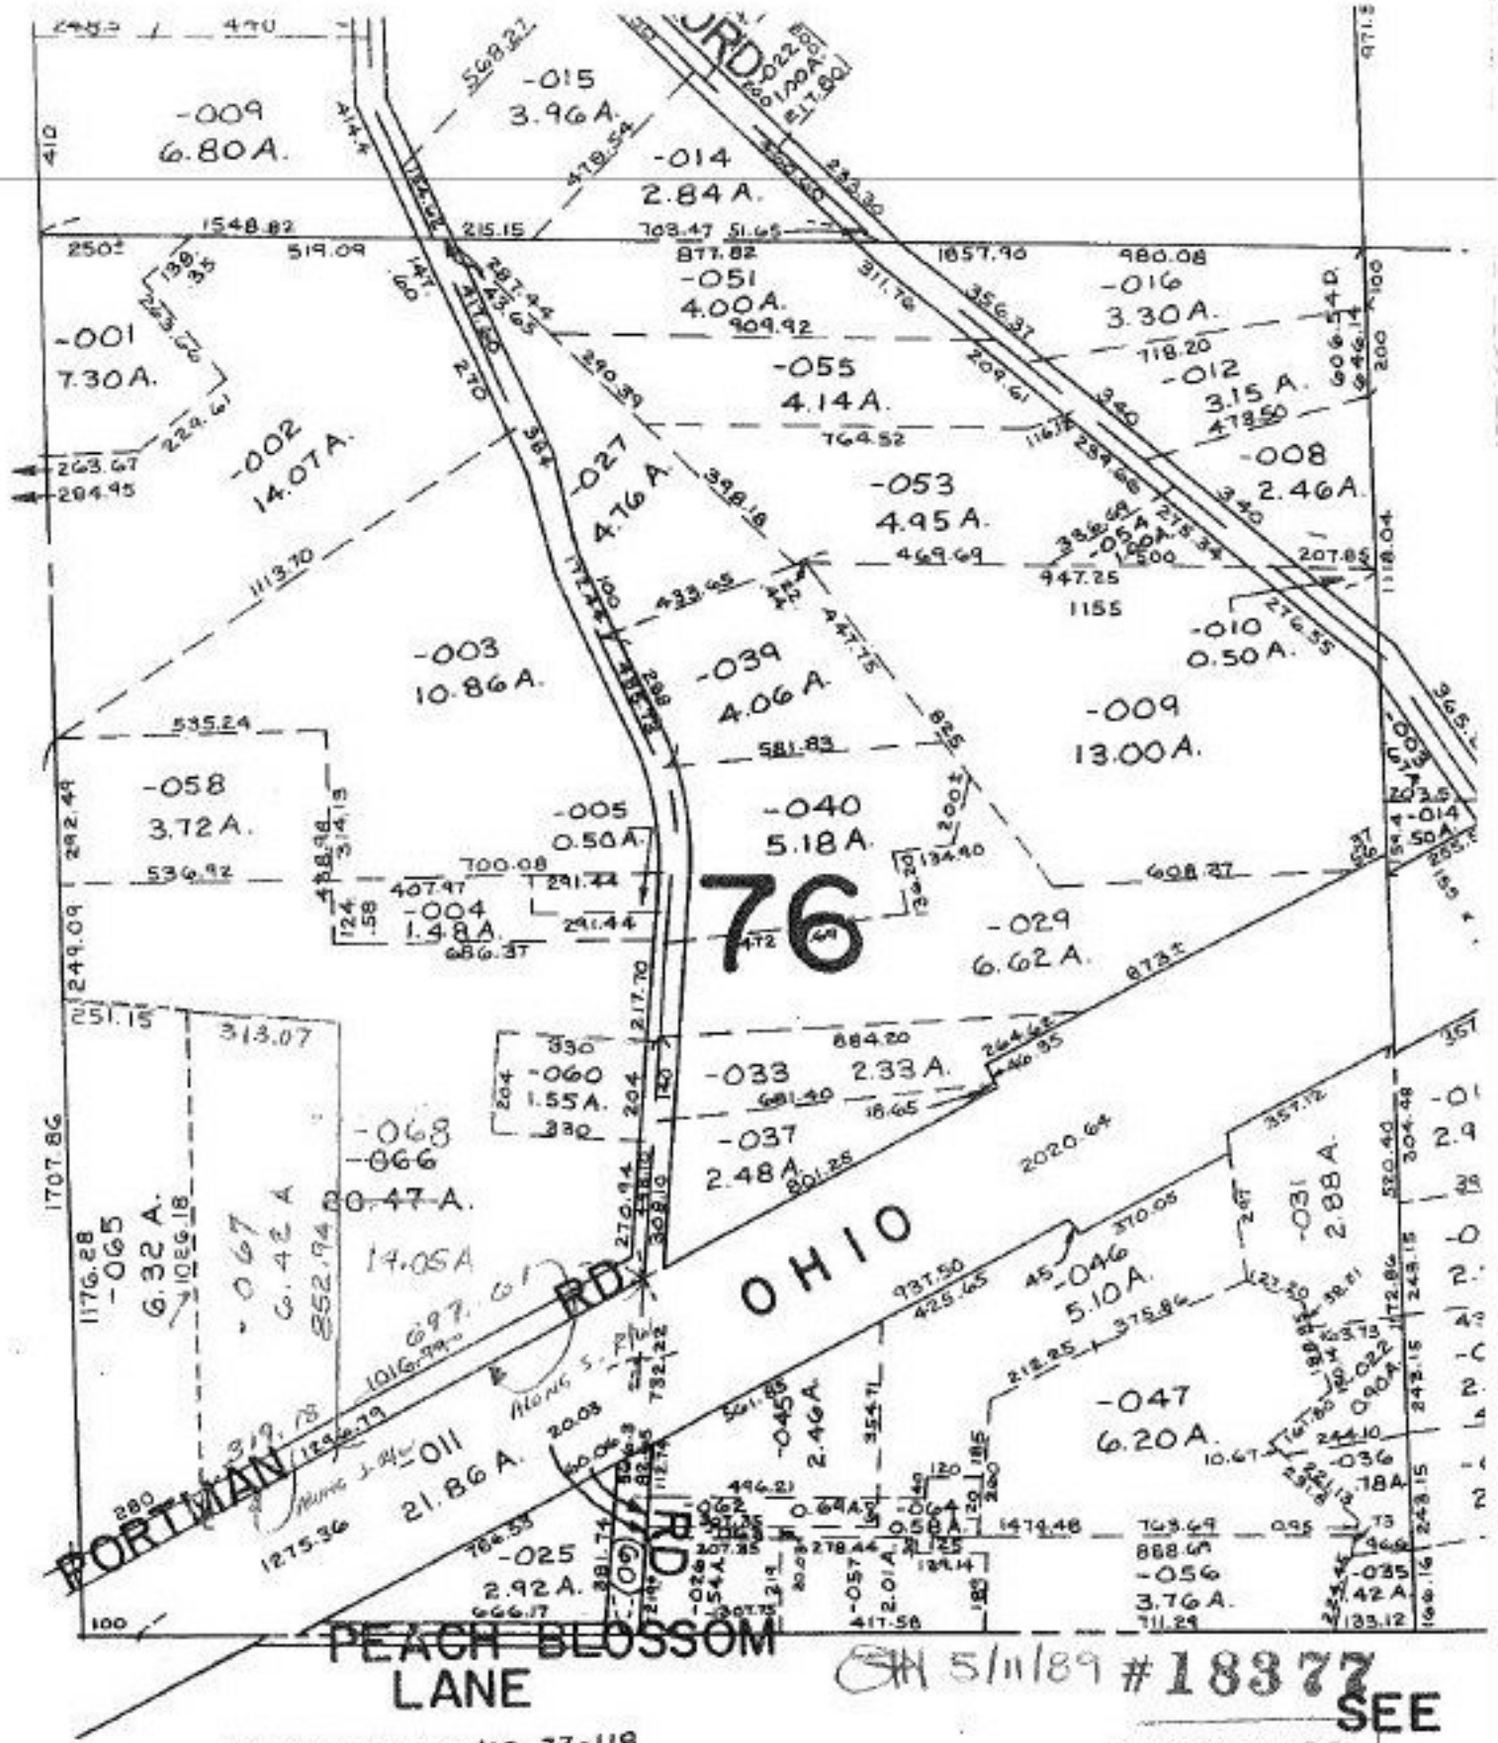

CO. COMM. RES. NO. 77-118

2-22-1977

5/11/89 #18377 SEE

APPROVED
LORAIN CO.
MAP DEPT.

DATE 4-6-89

PAGE 1-K

BY CAROLYN FRANCIS

VOID AFFIDAVIT X 18377

01-00-076-000-

PRIOR INST 993/660

SURVEYED BY: ARNOLD KOEPP

C=1: 20000. REG. SURVEYOR