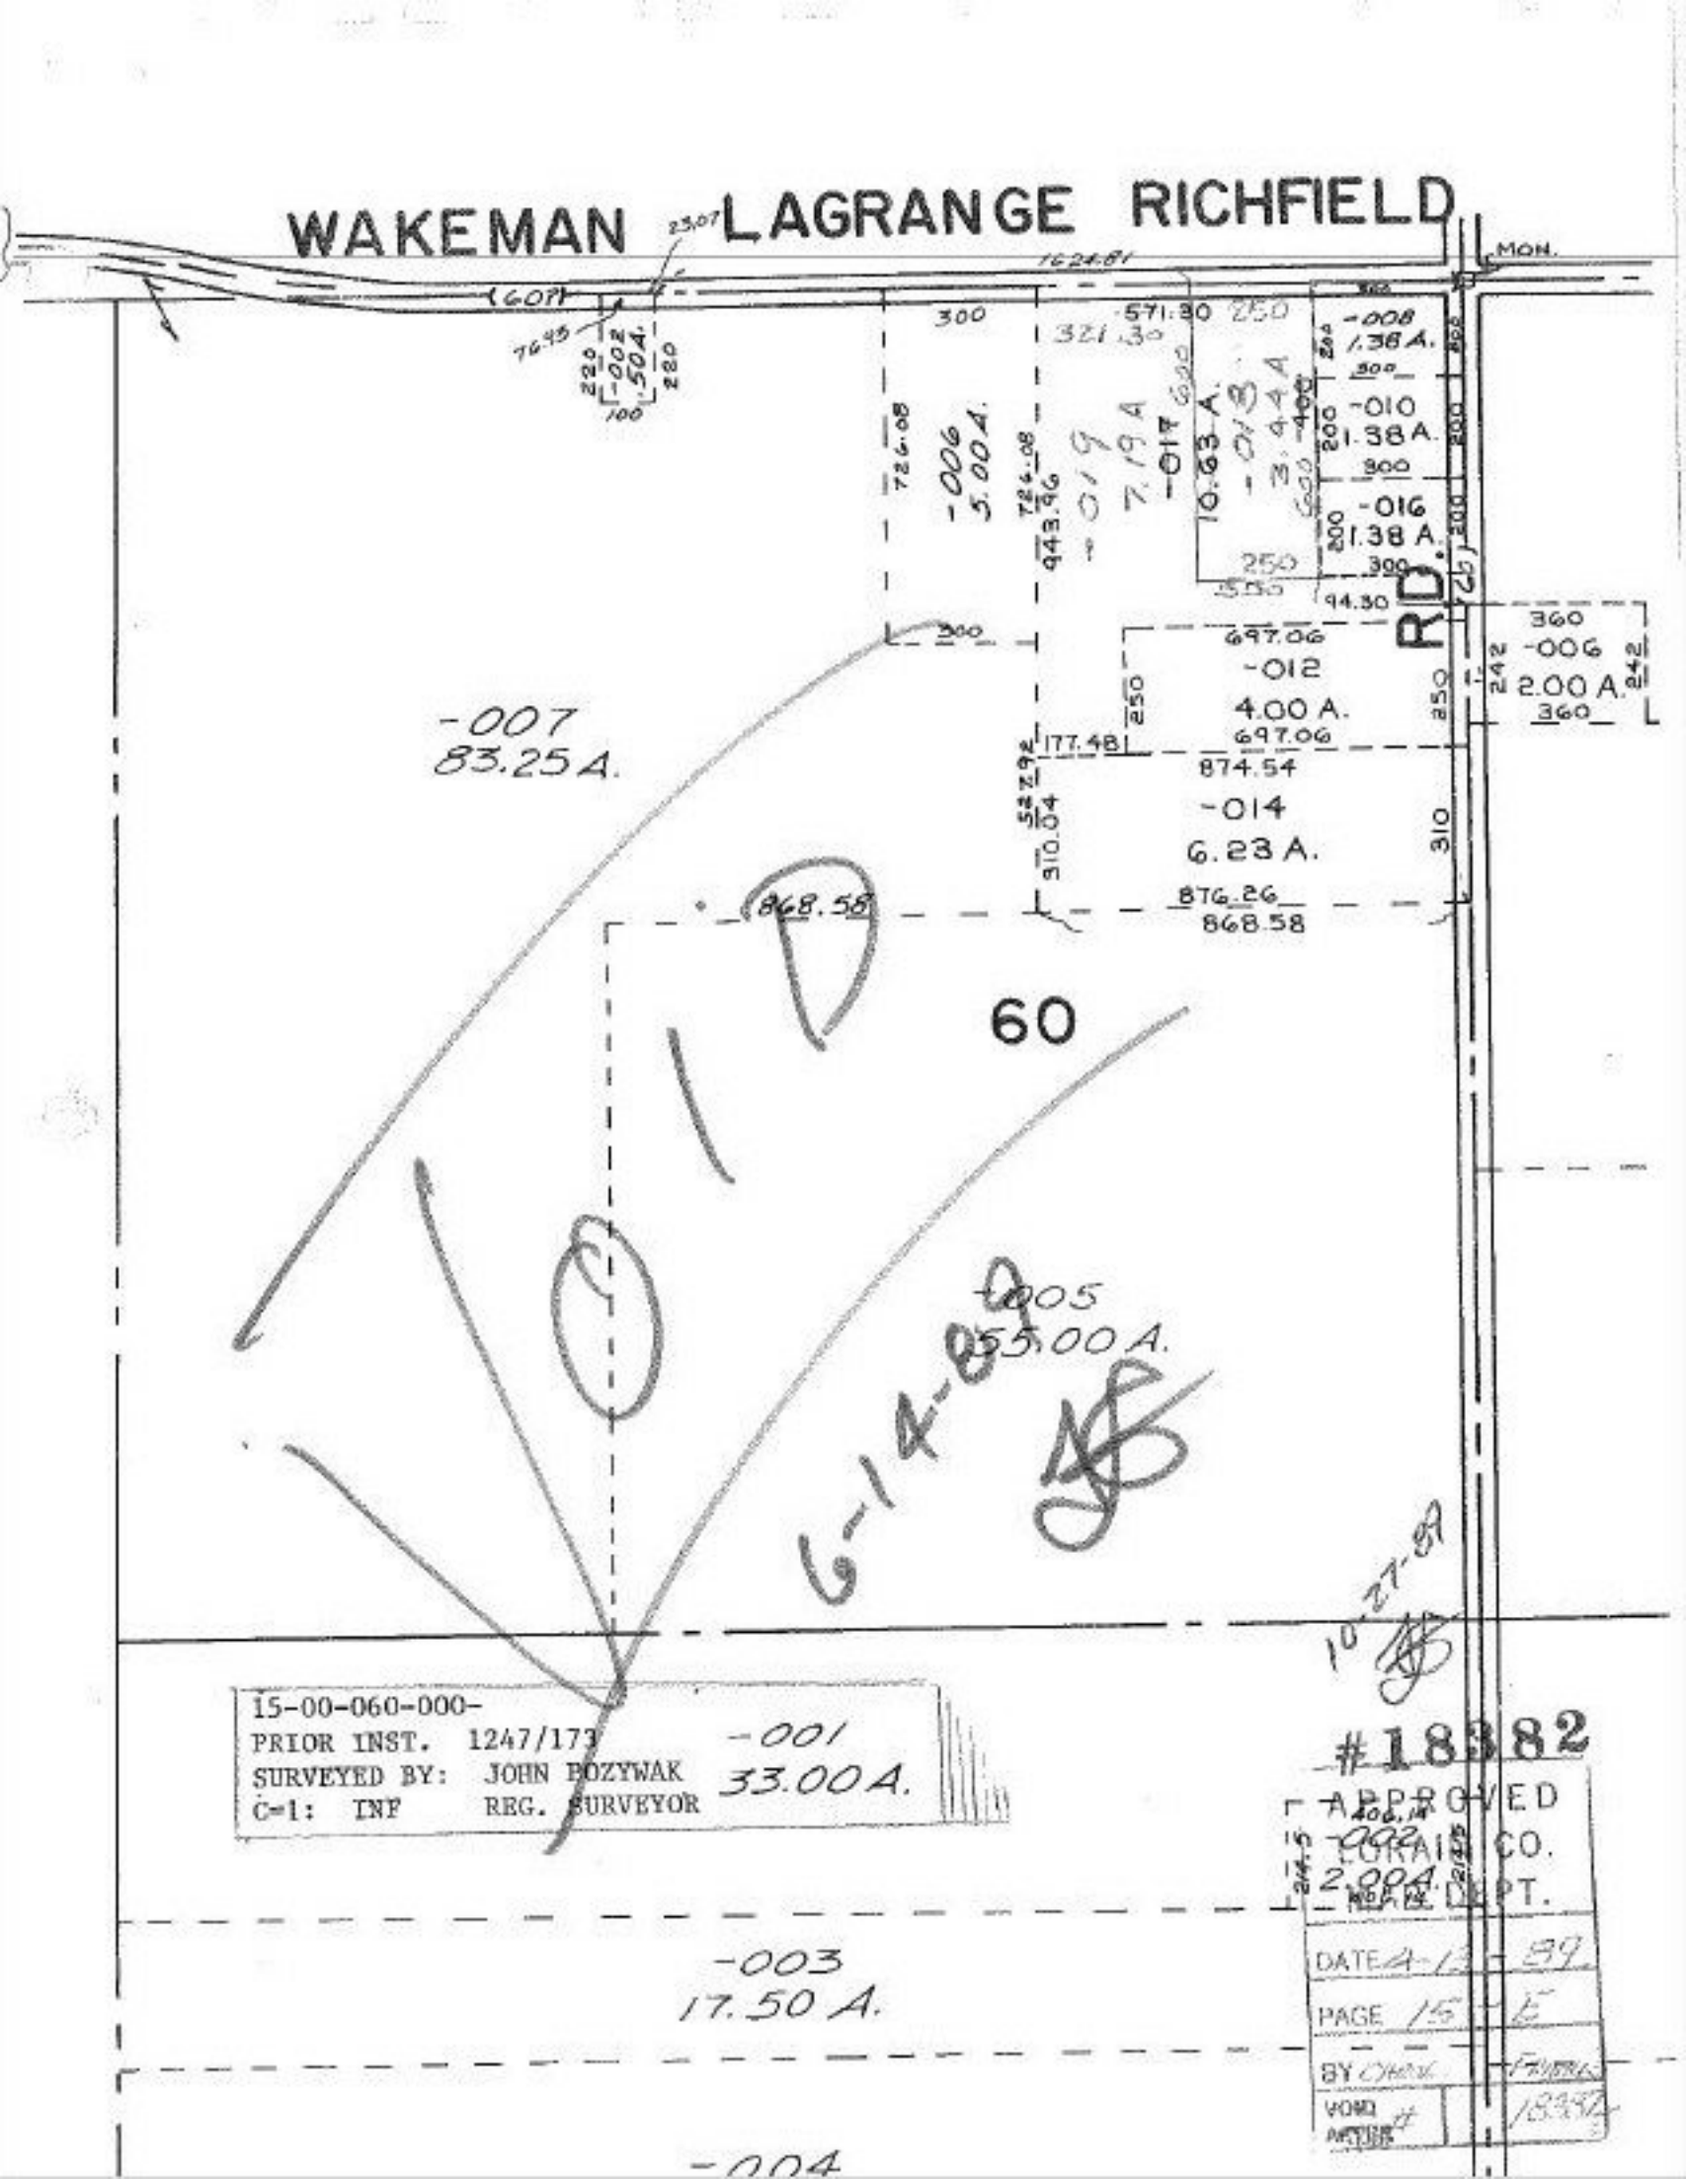
WAKEMAN LAGRANGE RICHFIELD
MON.
RD.
-007
83.25 A.
-006
5.00 A.
-019
7.19 A
-017
10.63 A.
-018
3.44 A
-008
1.38 A.
-010
1.38 A.
-016
1.38 A.
-012
4.00 A.
-006
2.00 A.
-014
6.23 A.
60
-005
55.00 A.
-001
33.00 A.
-003
17.50 A.
-004
VOID
6-14-89
10-27-89
15-00-060-000-
PRIOR INST. 1247/173
SURVEYED BY: JOHN POZYWAK
C=1: INF REG. SURVEYOR
#18382
APPROVED
LORAIN CO.
MAP DEPT.
DATE 4-13-89
PAGE 15 E
BY
VOID
ACTION #
18382